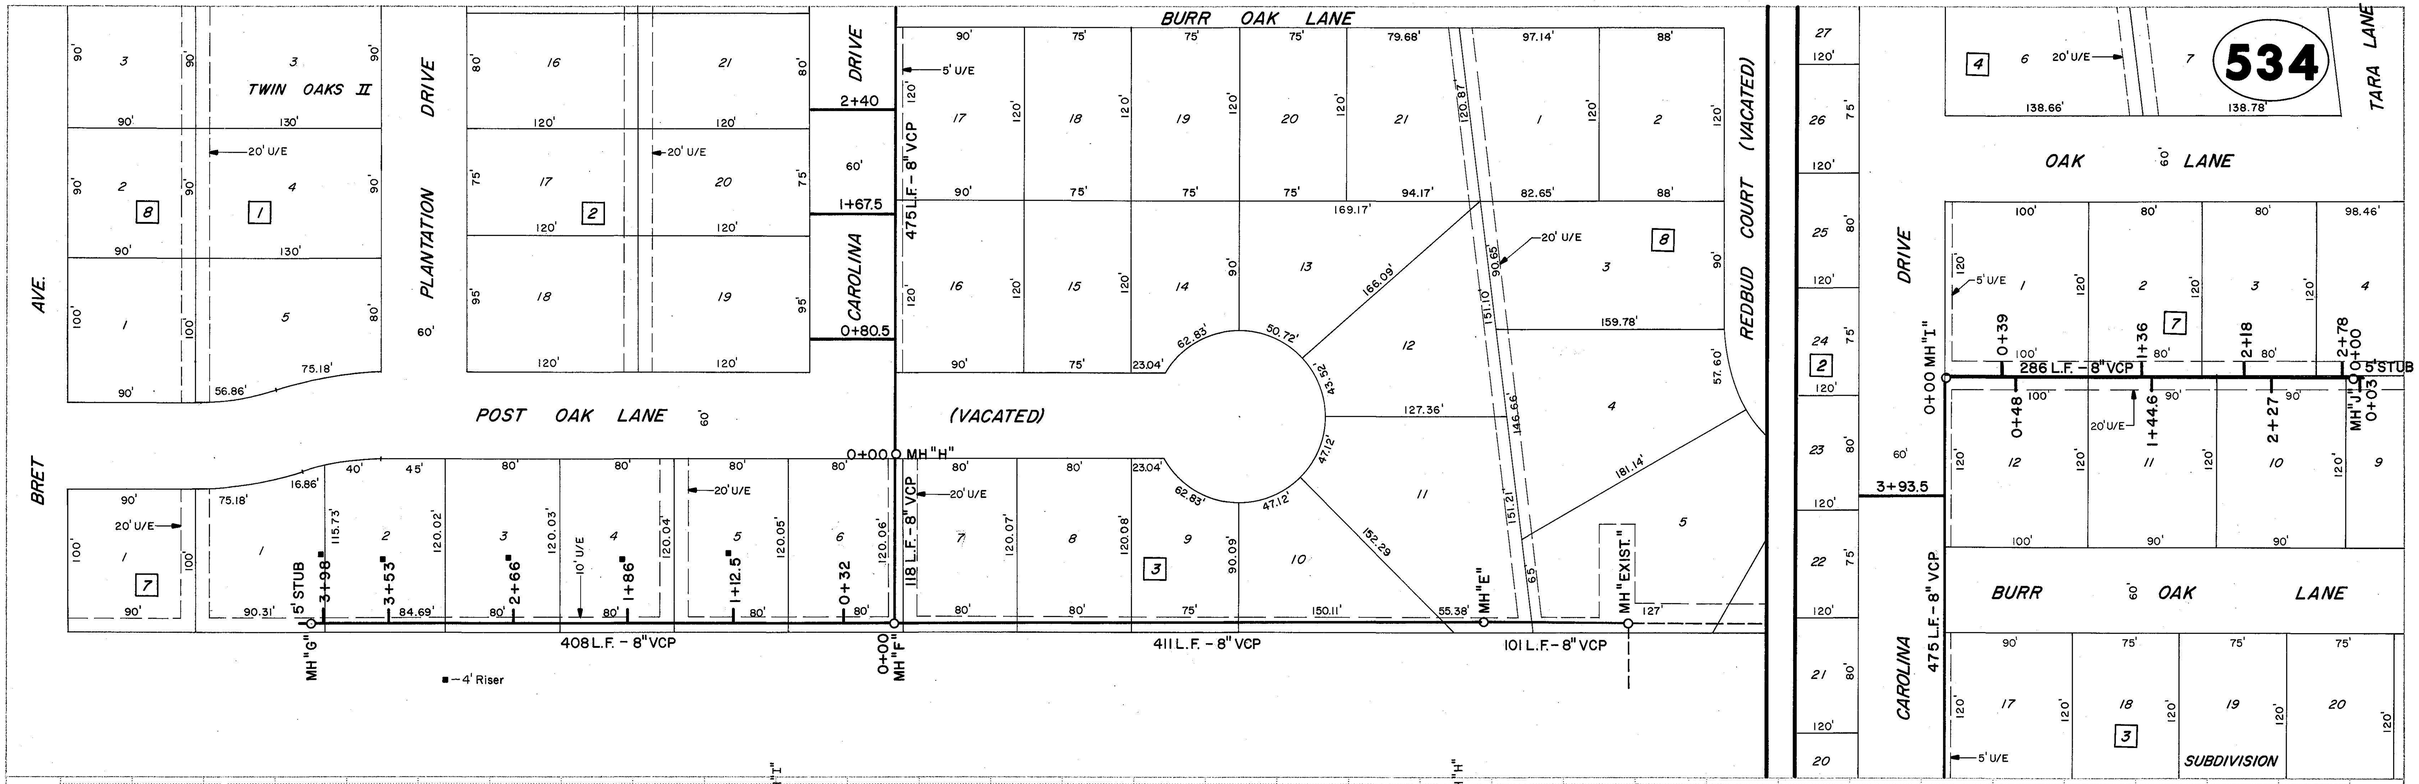

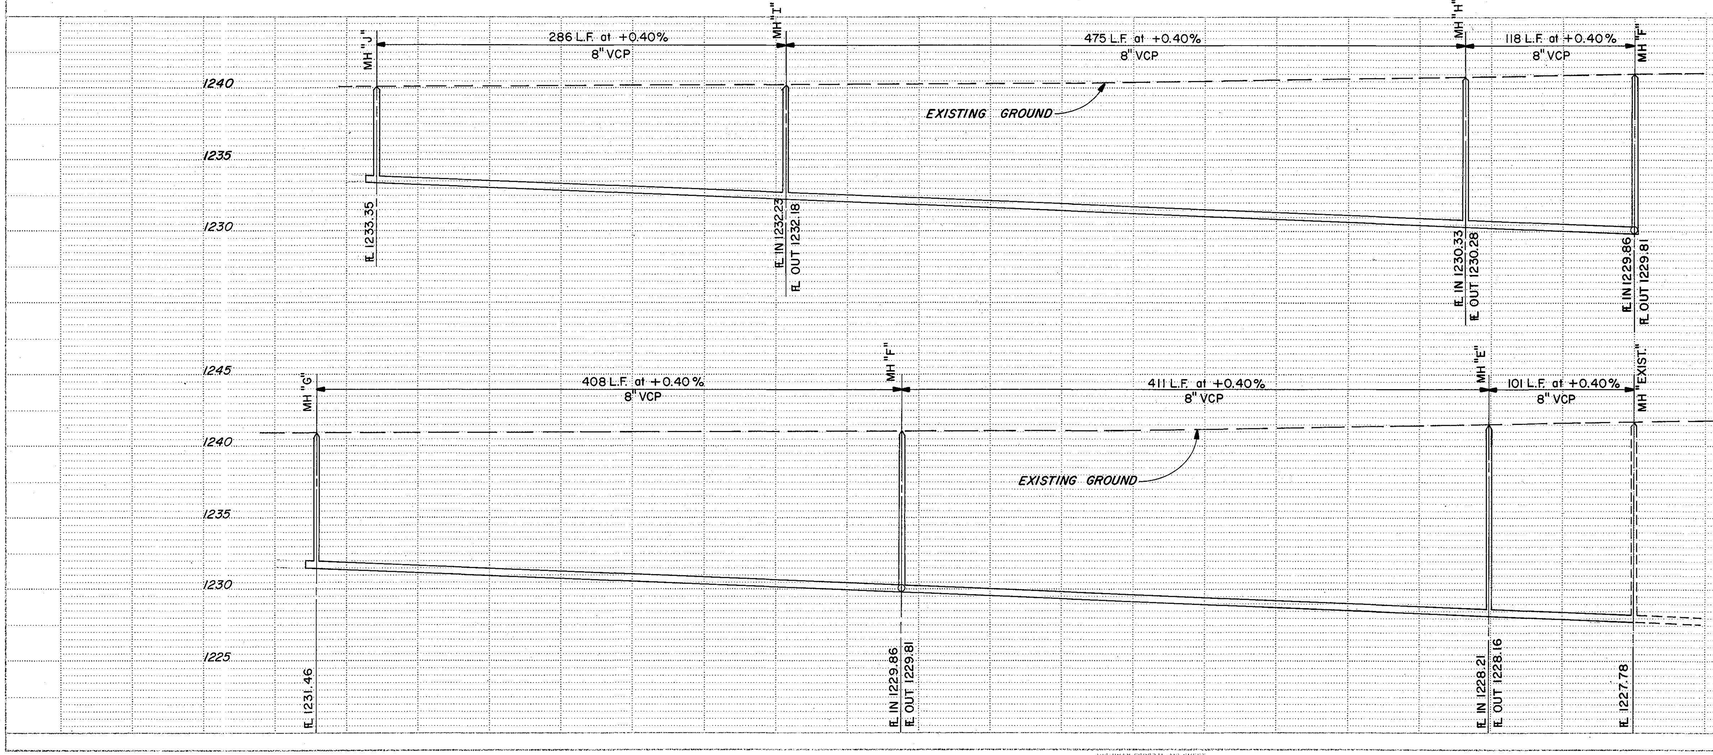

AS-BUILT PLANS
PROJECT NO. 87-752
WILSON CONST.
COMP. DATE 11/87

N

Scale 1"=50'

PLAN — SURVEYED, PLOTTED, ALIGNMENT CHECKED, RT. OF WAY CHECKED, NOTE BOOK NO., BY, DATE

PROFILE — SURVEYED, PLOTTED, GRADES CHECKED, B.M. NOTED, STRUCTURE DATA NOTED, NOTE BOOK NO., BY, DATE