535

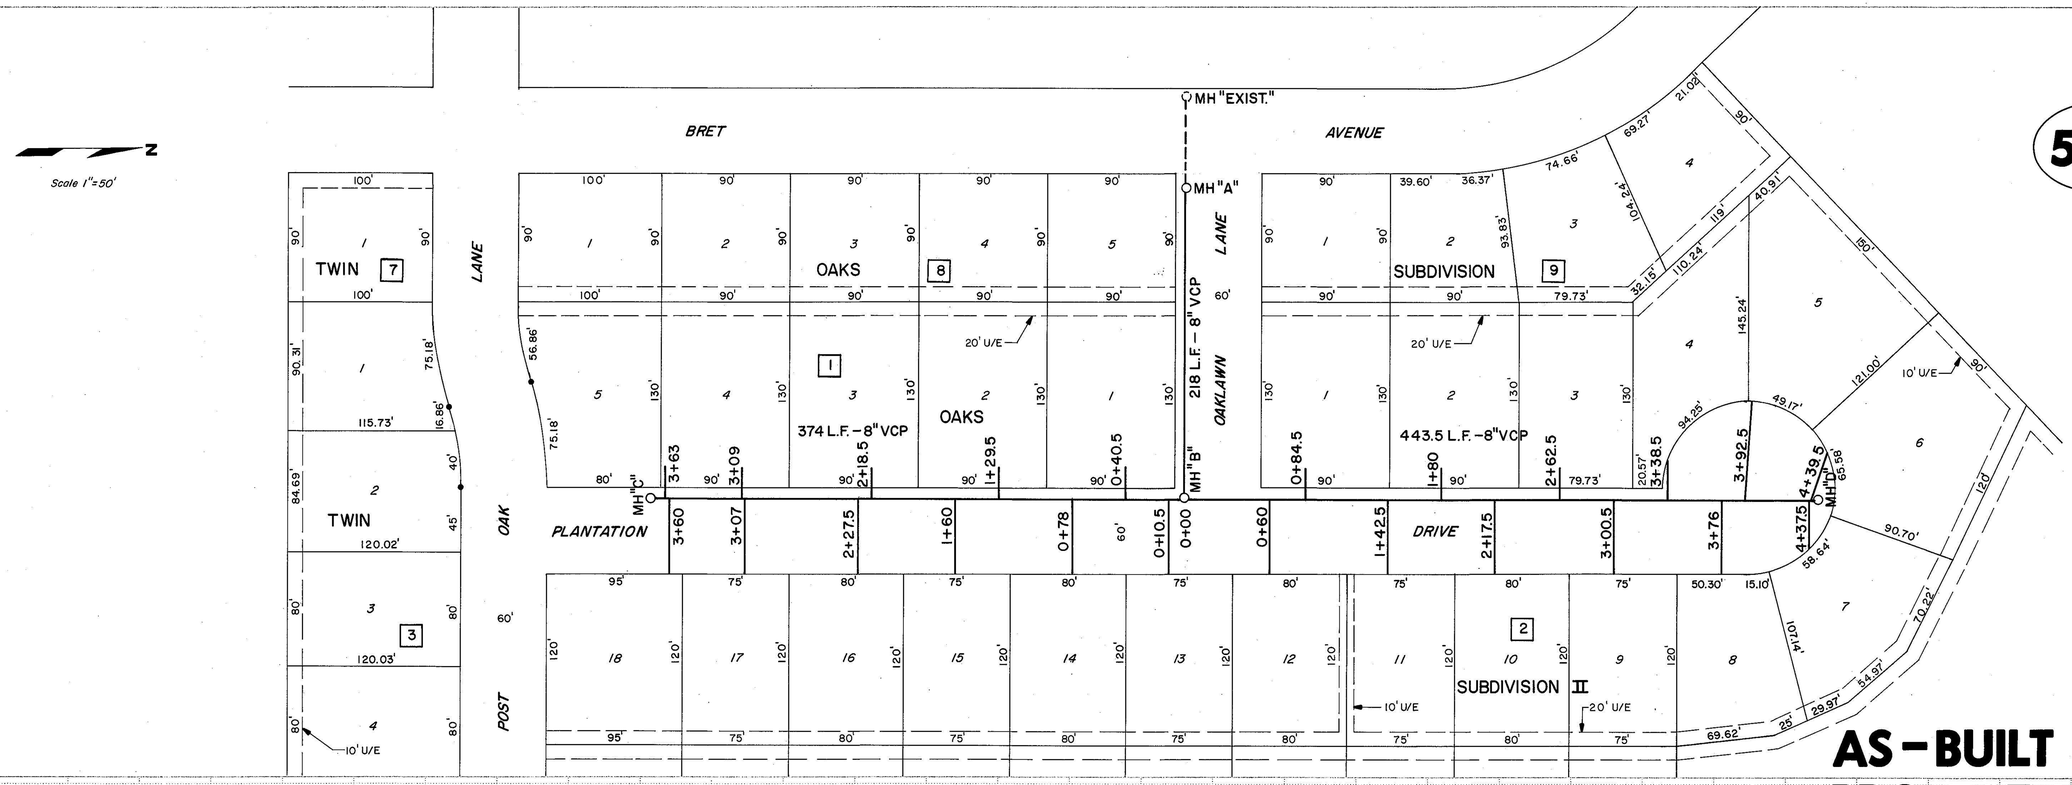

AS-BUILT PLANS
PROJECT NO. 87-752
WILSON CONST.
COMP. DATE 11/87

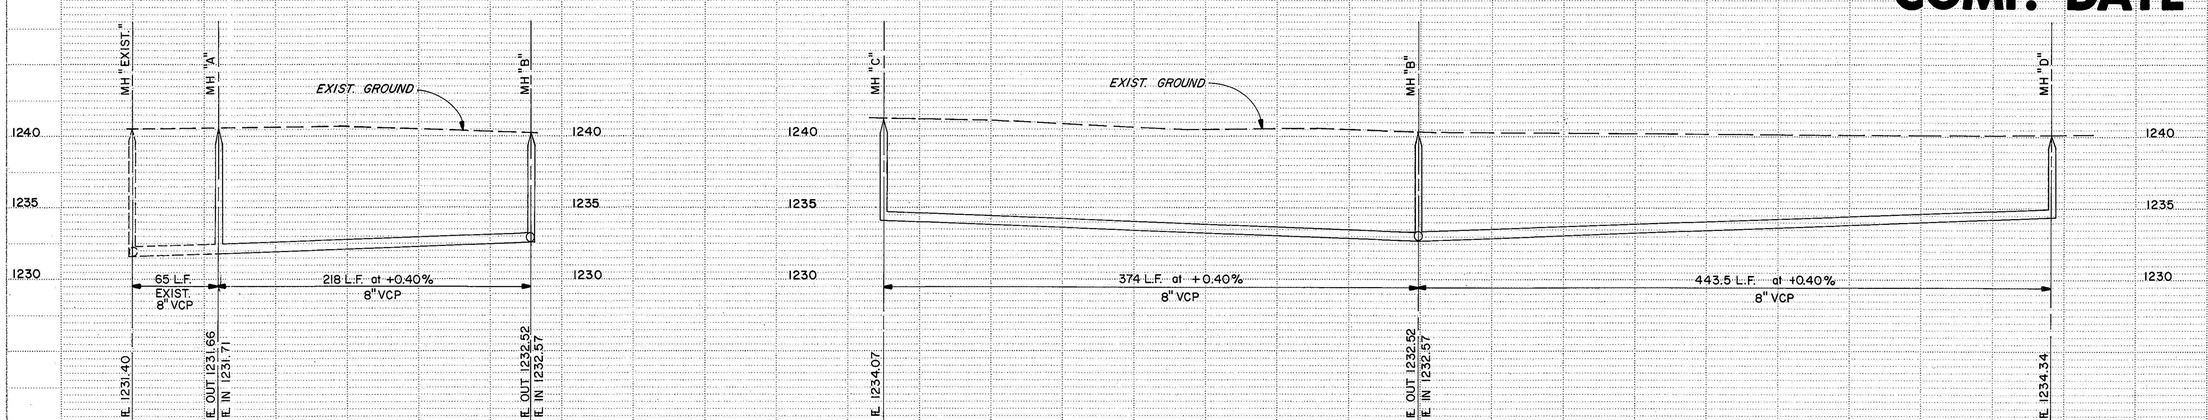

PLAN — SURVEYED, PLOTTED, ALIGNMENT CHECKED, RT. OF WAY CHECKED — NOTE BOOK NO. — BY — DATE

PROFILE — SURVEYED, PLOTTED, GRADES CHECKED, HORIZ. & VERT. STRUCTURE NOTATIONS CHKD. — NOTE BOOK NO. — BY — DATE