536

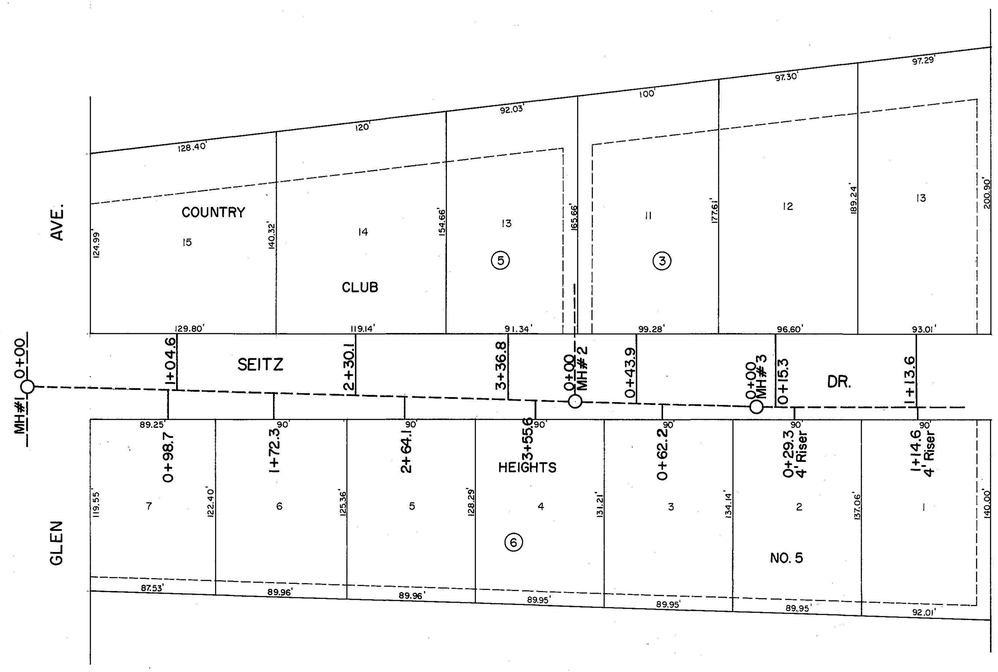

Scale 1"=50'

AS-BUILT PLANS
PROJECT NO. 88-763
WILSON CONSTRUCTOR
COMP. DATE 12/88

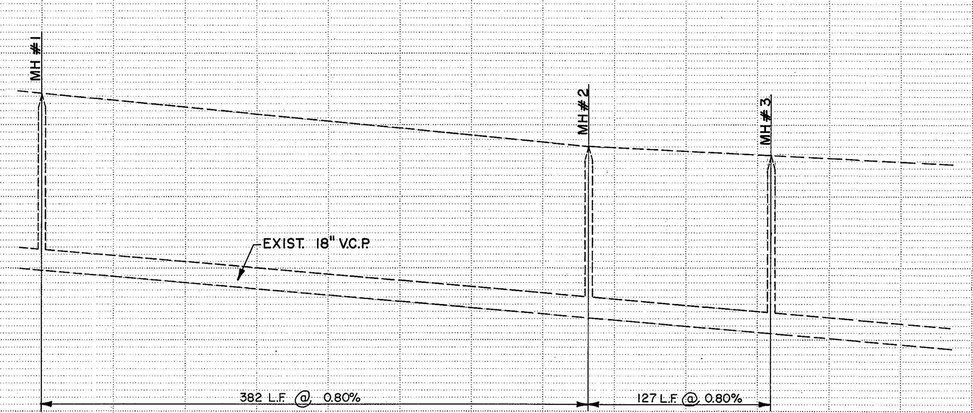

PLAN
SURVEYED
PLOTTED
NOTE BOOK
ALIGNMENT CHECKED
NO.
RT. OF WAY CHECKED
BY
DATE

PROFILE
SURVEYED
PLOTTED
NOTE BOOK
GRADES CHECKED
S. N. I. NOTED
NO.
STRUCTURE INFORMATION CHECKED
BY
DATE