537

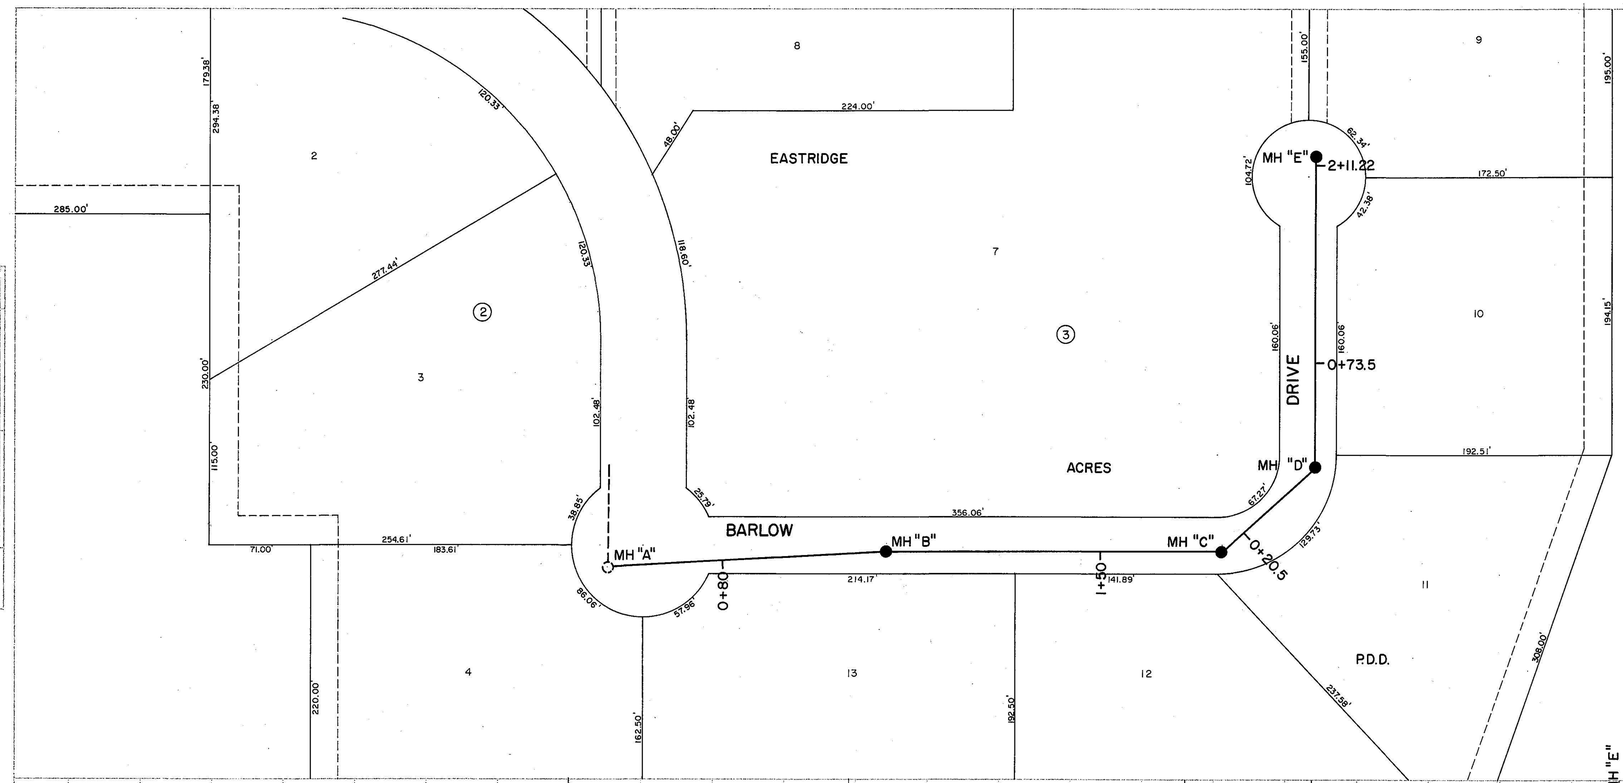

AS-BUILT PLANS
PROJECT NO. 88-763
WILSON CONSTRUCTOR
COMP. DATE 12/88

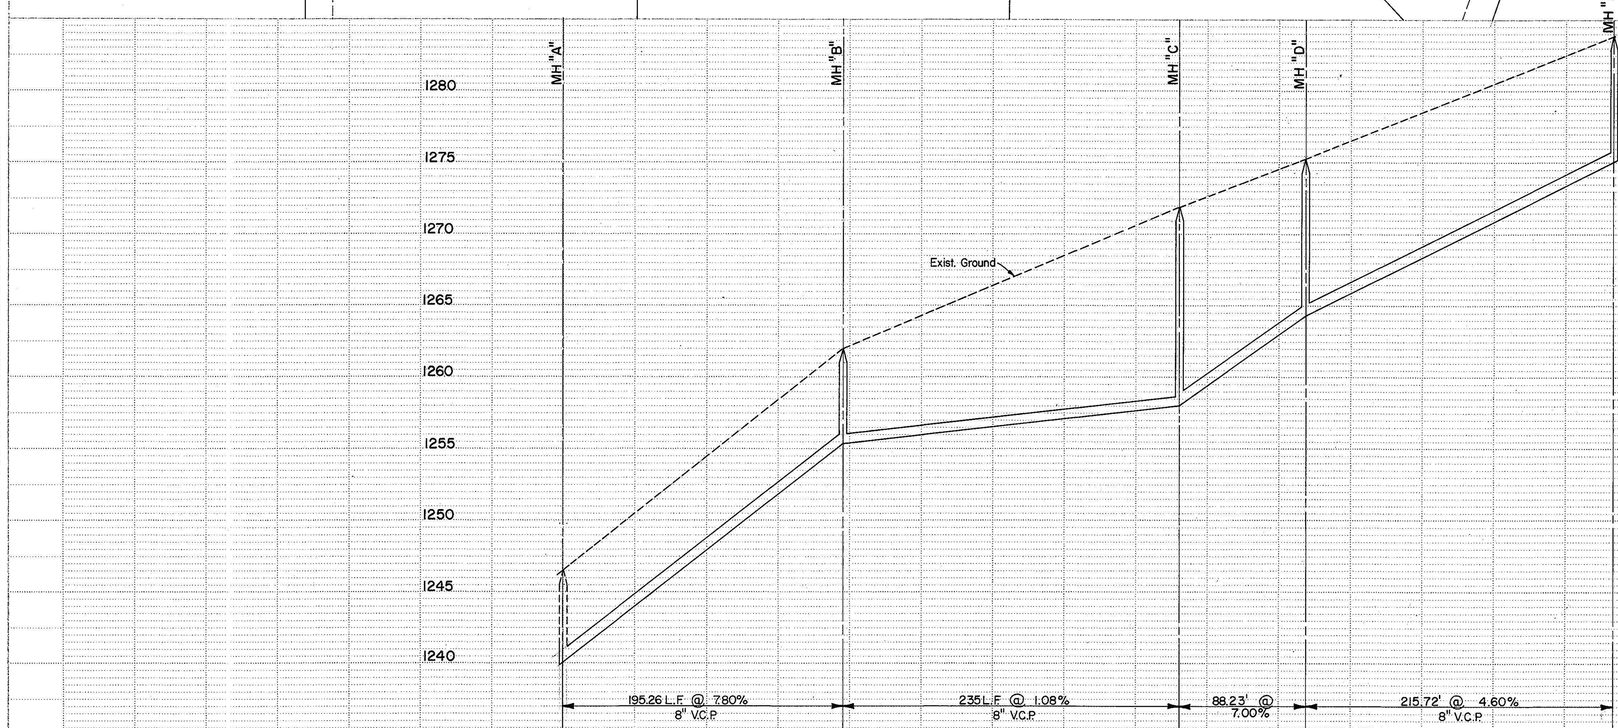

PLAN
SURVEYED
PLOTTED
NOTE BOOK
ALIGNMENT CHECKED
NO.
RT. OF WAY CHECKED
BY
DATE

PROFILE
SURVEYED
PLOTTED
NOTE BOOK
GRADES CHECKED
NO.
STRUCTURE NOTATIONS CHK'D
BY
DATE