538

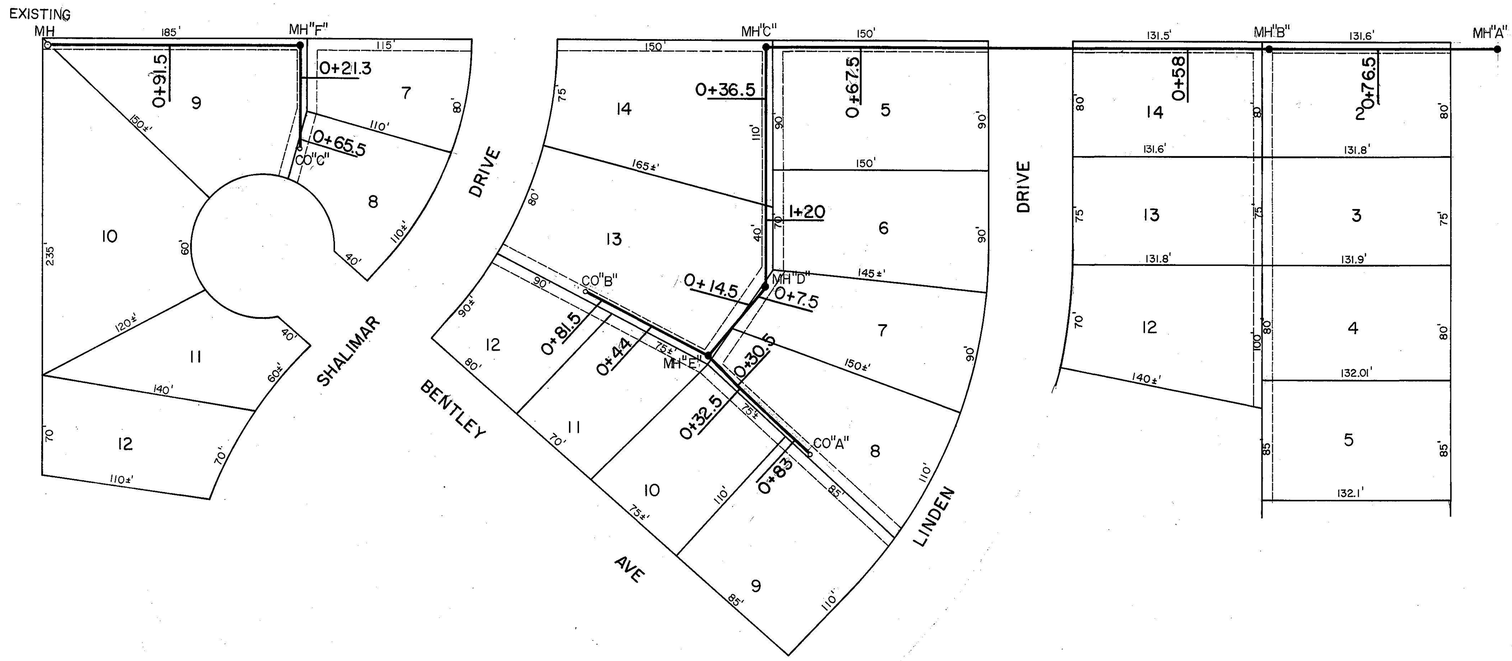

AS-BUILT PLAN
PROJECT NO. 88-763
WILSON CONST. INC.
COMP. DATE- 12/88

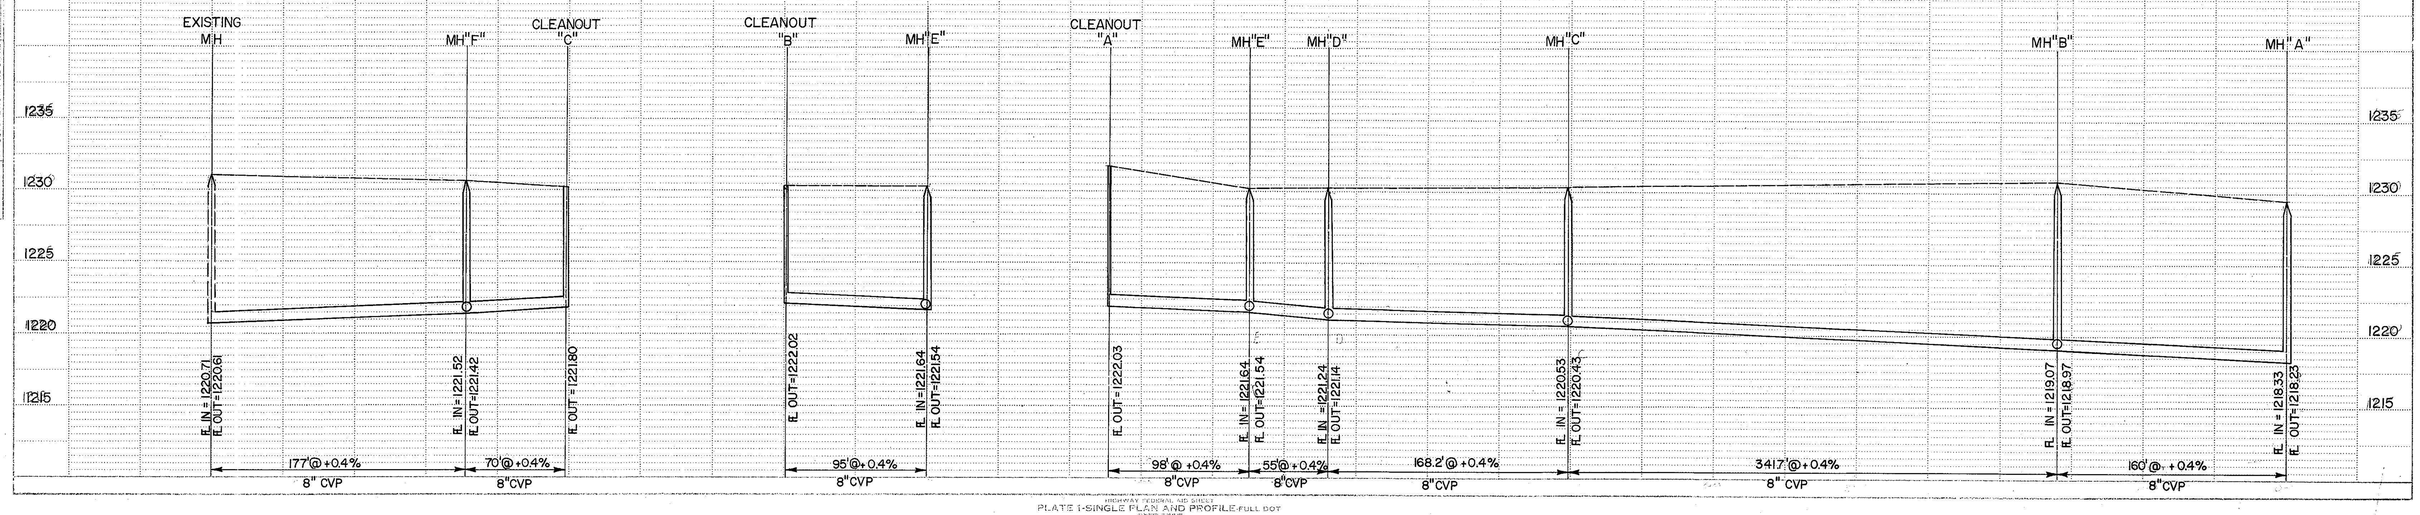

PLAN — SURVEYED / PLOTTED / ALIGNMENT CHECKED / PT OF INT CHECKED — NOTE BOOK NO. — BY — DATE

PROFILE — SURVEYED / PLOTTED / GRADES CHECKED / BM NOTED / STRUCTURE NOTES CHKD — NOTE BOOK NO. — BY — DATE