PLAN

	DATE
SURVEYED	
PLOTTED	
ALIGNMENT CHECKED	
AS-BUILT CHECKED	
NOTE BOOK	
NO.	

PROFILE

	BY	DATE
SURVEYED		
PLOTTED		
GRADES CHECKED		
AS-BUILT CHECKED		
NOTE BOOK		
NO.		
STRUCTURE ROTATIVS CHKD		

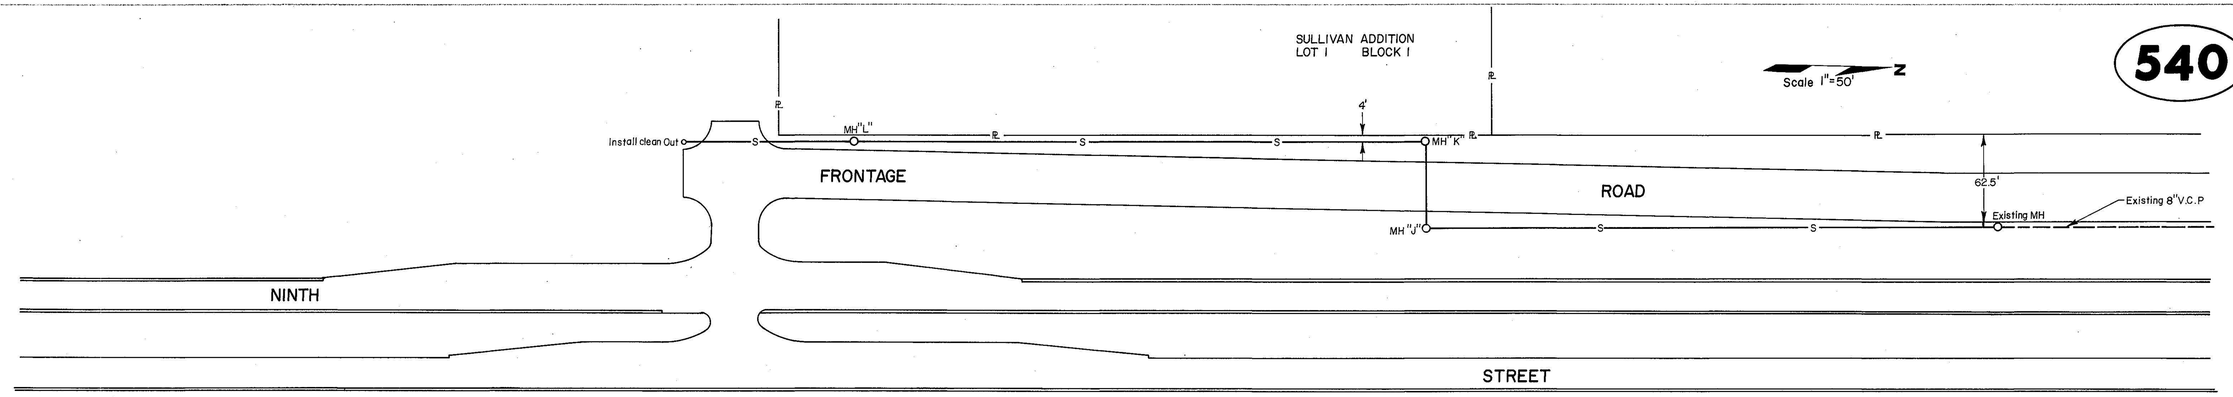

AS-BUILT PLAN
PROJECT NO. 84-717
SMOKY HILL INC.
COMP. DATE-2/85

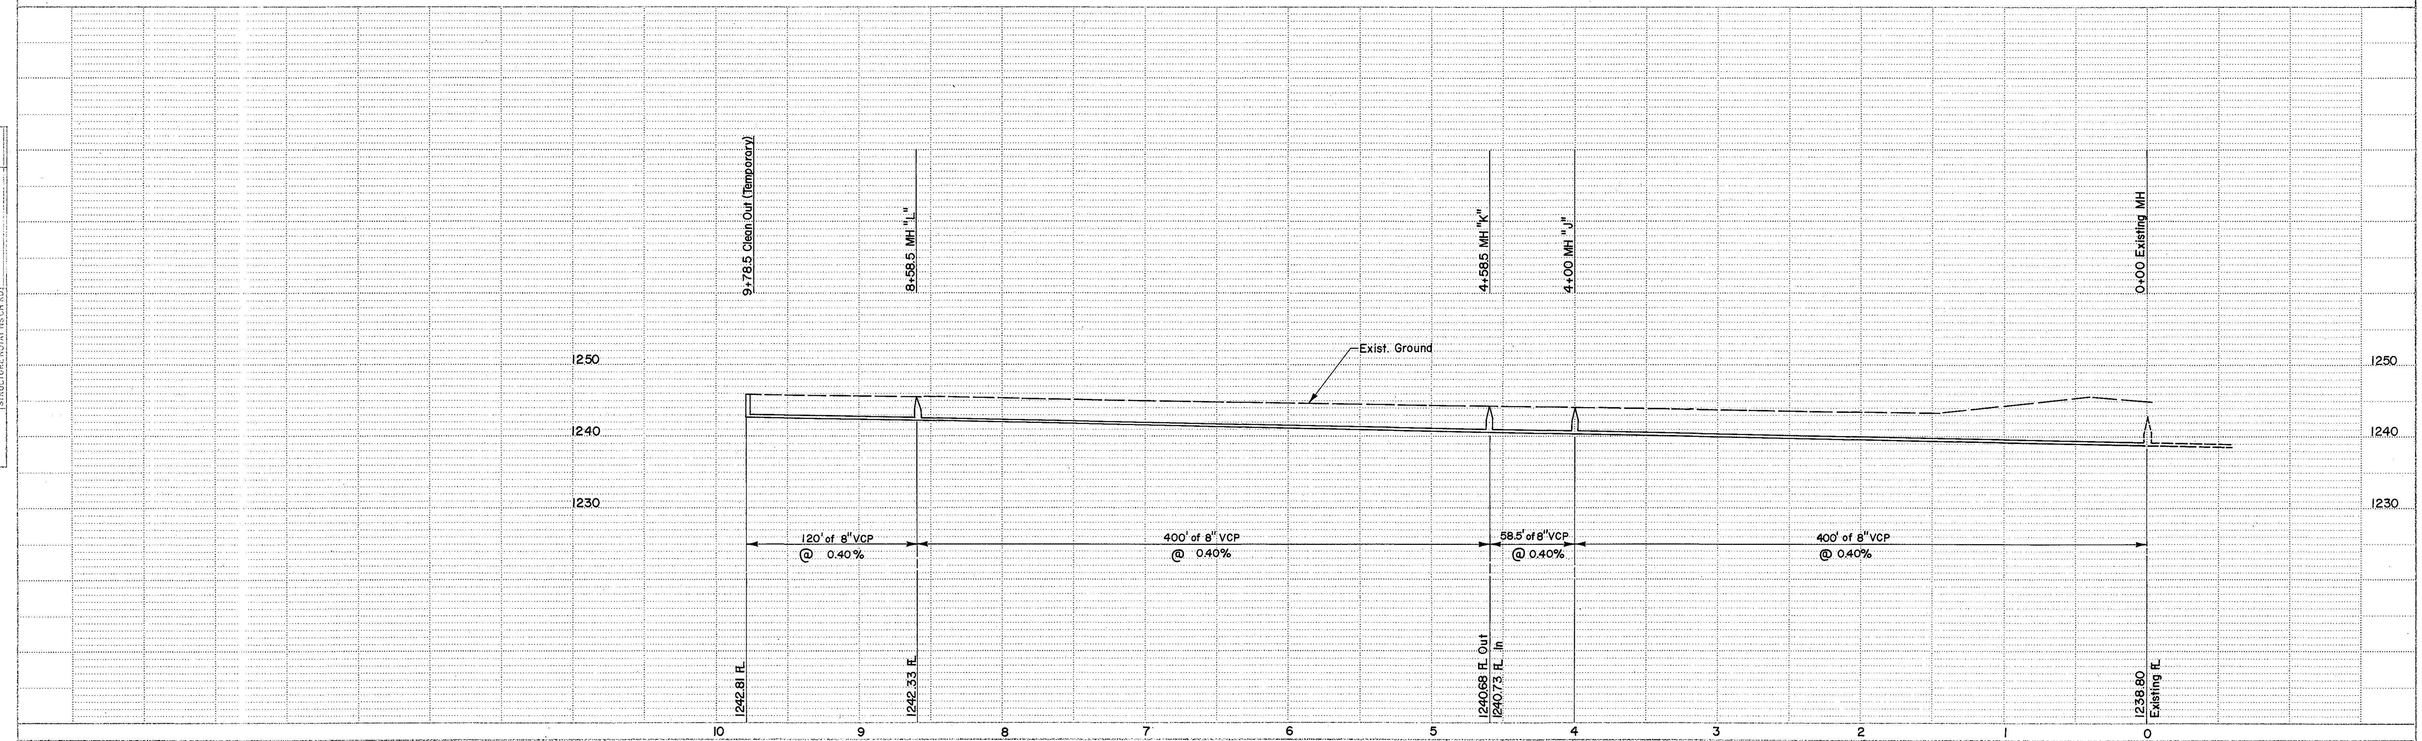

HIGHWAY FEDERAL AID SERIES
PLATE 1-SINGLE PLAN AND PROFILE-FULL DOT
STANDARD
PRINTED IN U.S.A.