541

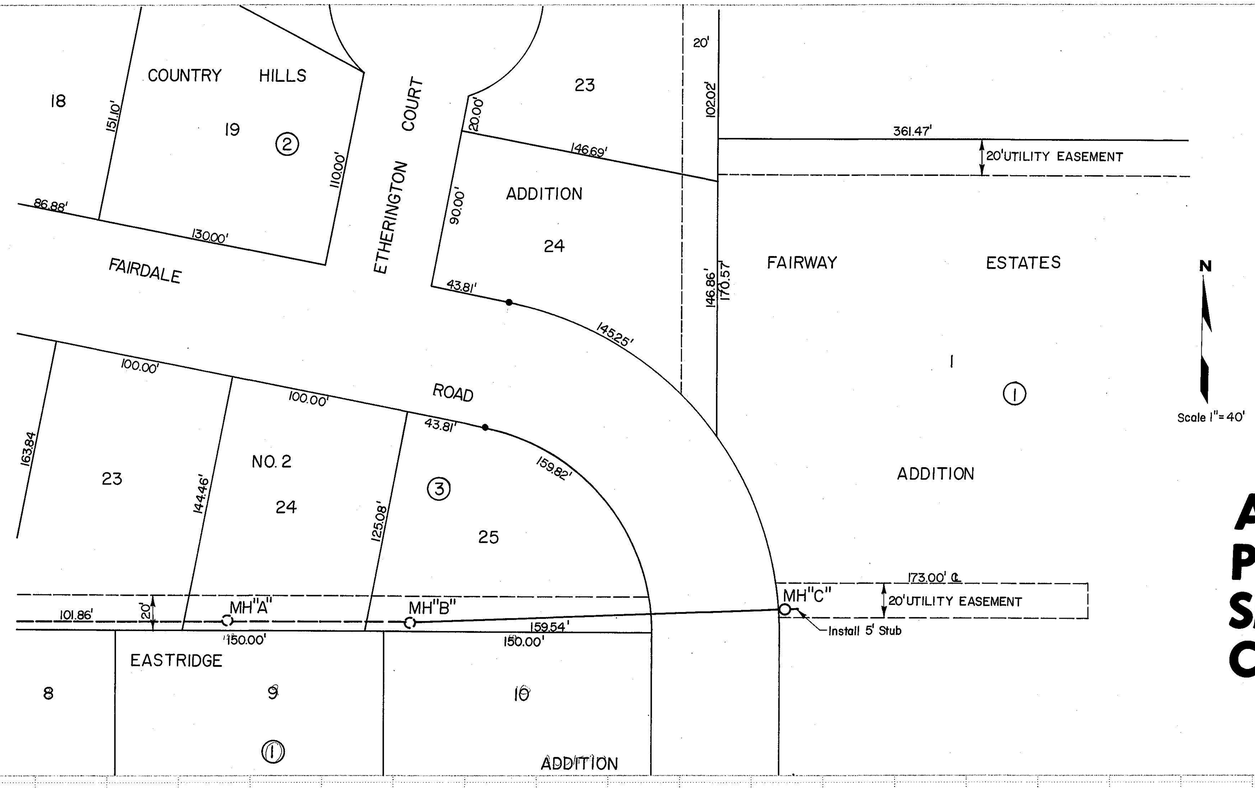

AS-BUILT PLAN
PROJECT NO. 84/717
SMOKY HILL INC.
COMP. DATE - 2/85

PLAN		BY	DATE
NOTE BOOK	SURVEYED		
	PLOTTED		
	ALIGNMENT CHECKED		
NO.	RT OF WAY CHECKED		
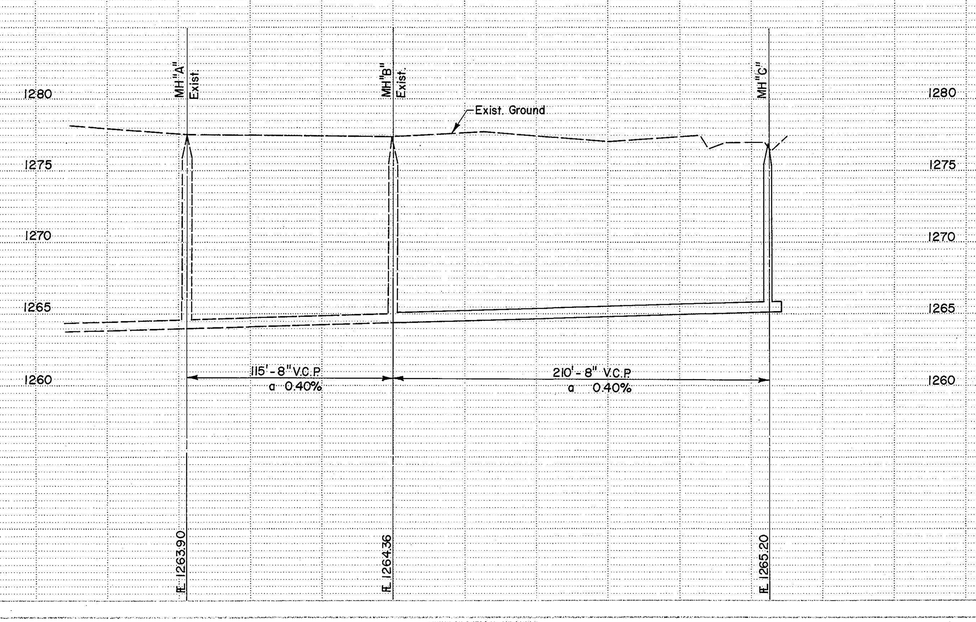
PROFILE		BY	DATE
NOTE BOOK	SURVEYED		
	PLOTTED		
	GRADES CHECKED		
NO.	B. & E NOTED		
	STRUCTURE NOTATIONS CHKD