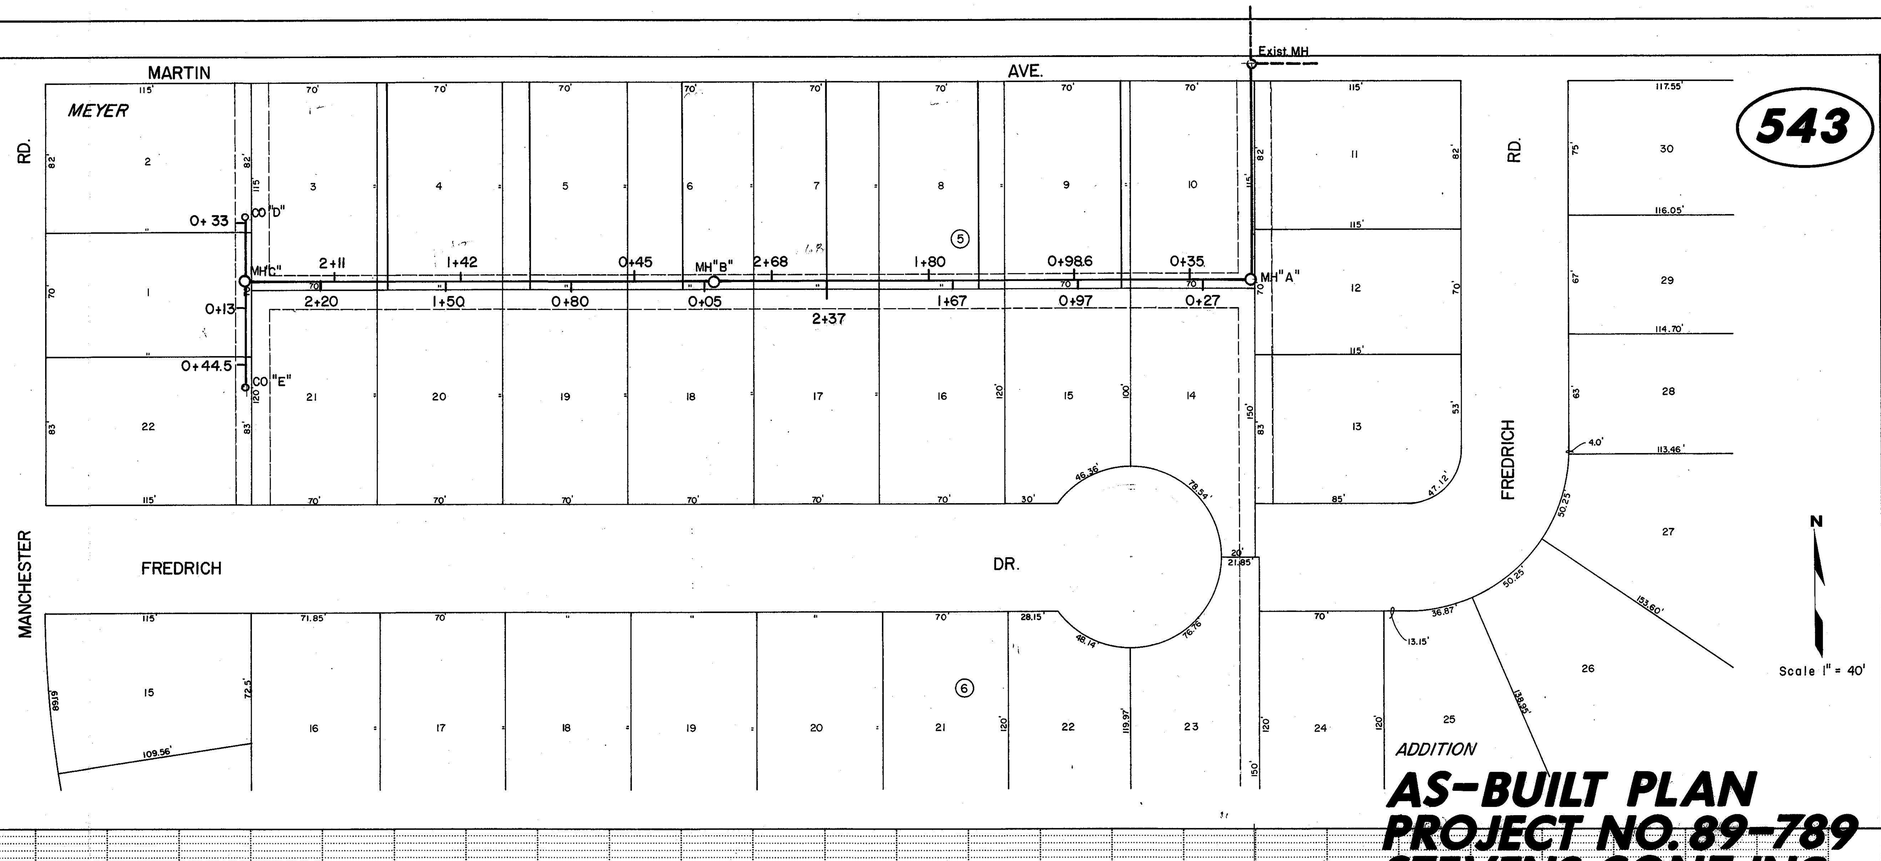

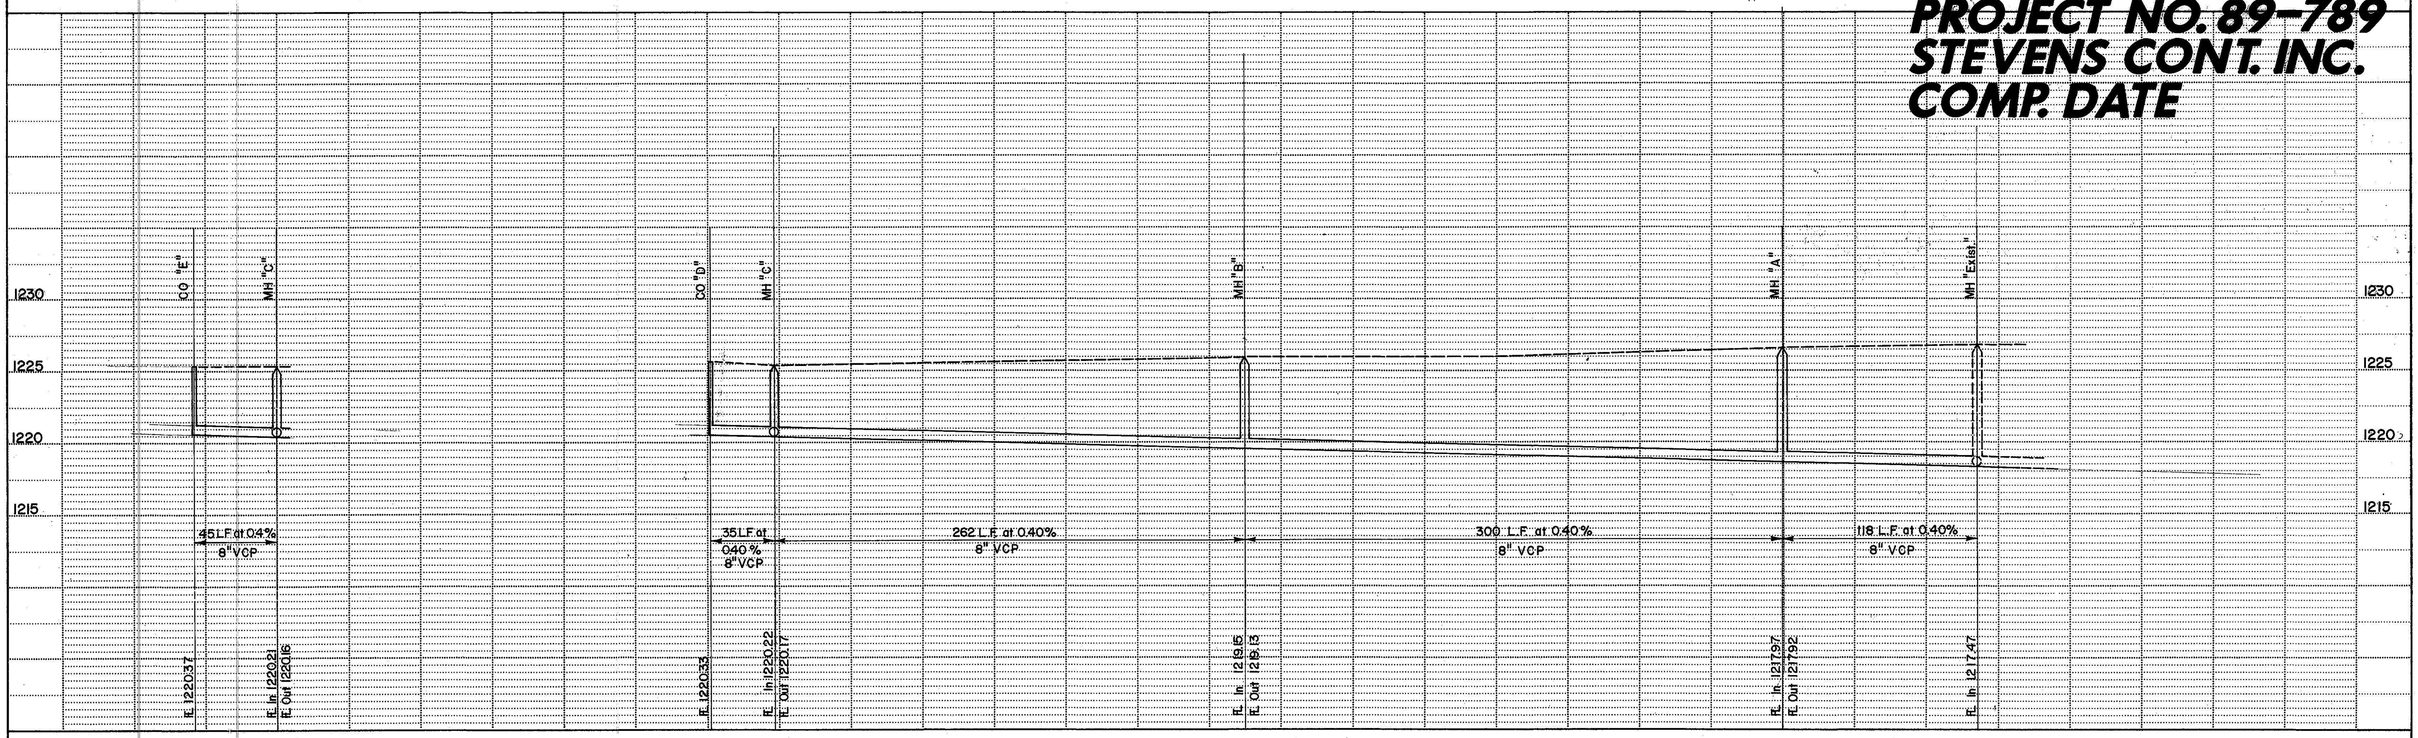

PLAN		BY	DATE
NOTE BOOK NO.	SURVEYED PLOTTED ALIGNMENT CHECKED RT. OF WAY CHECKED		

PROFILE		BY	DATE
NOTE BOOK NO.	SURVEYED PLOTTED GRADES CHECKED B.M. NOTED STRUCTURE NOTATNS CHKD		