544

AS-BUILT PLAN
PROJECT NO. 89-789
STEVENS CONST. INC.
COMP. DATE

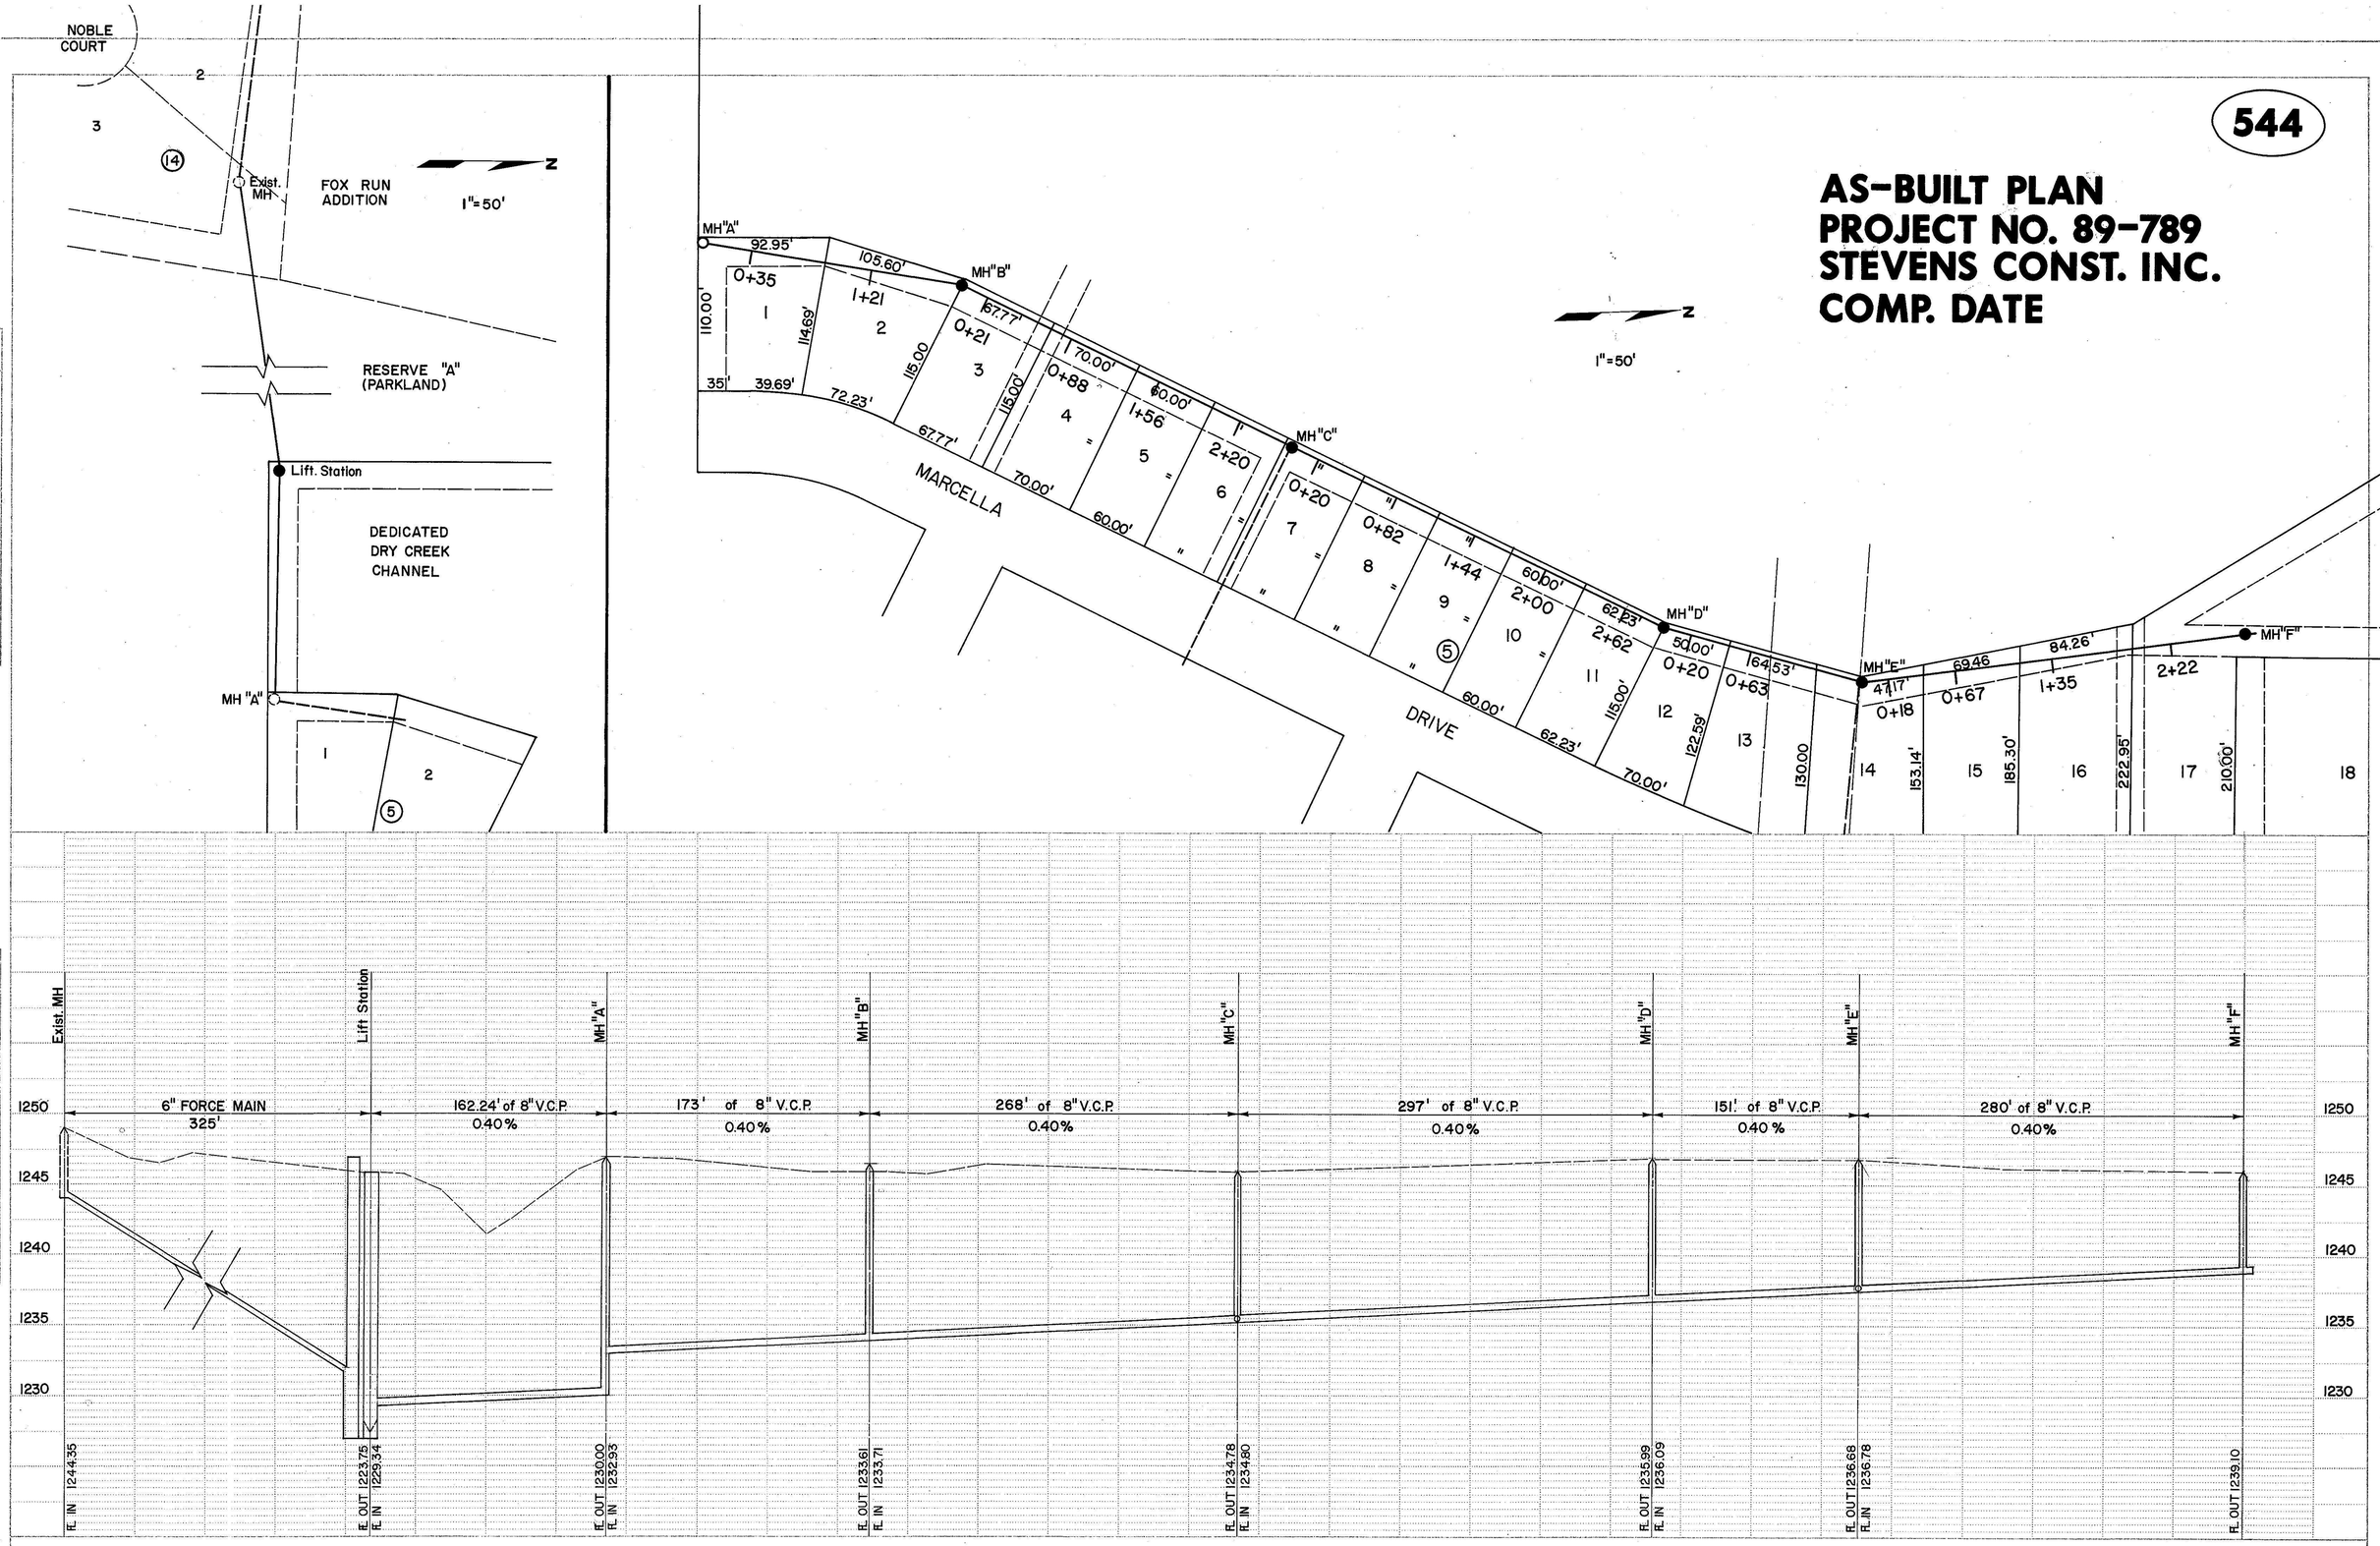

PLAN — SURVEYED, PLOTTED, ALIGNMENT CHECKED, BY: OF INV. CHECKED — NOTE BOOK NO. — BY — DATE

PROFILE — SURVEYED, PLOTTED, GRADES CHECKED, BY: OF INV. CHECKED, STRUCTURE NO. 1-7-13-CH-KO — BY — DATE

SURVEY TRIAL AND ABLEY
PLATE 1-SINGLE PLAN AND PROFILE-FULL DOT
12" TELECOPIE
PRINTED IN U.S.A.