545

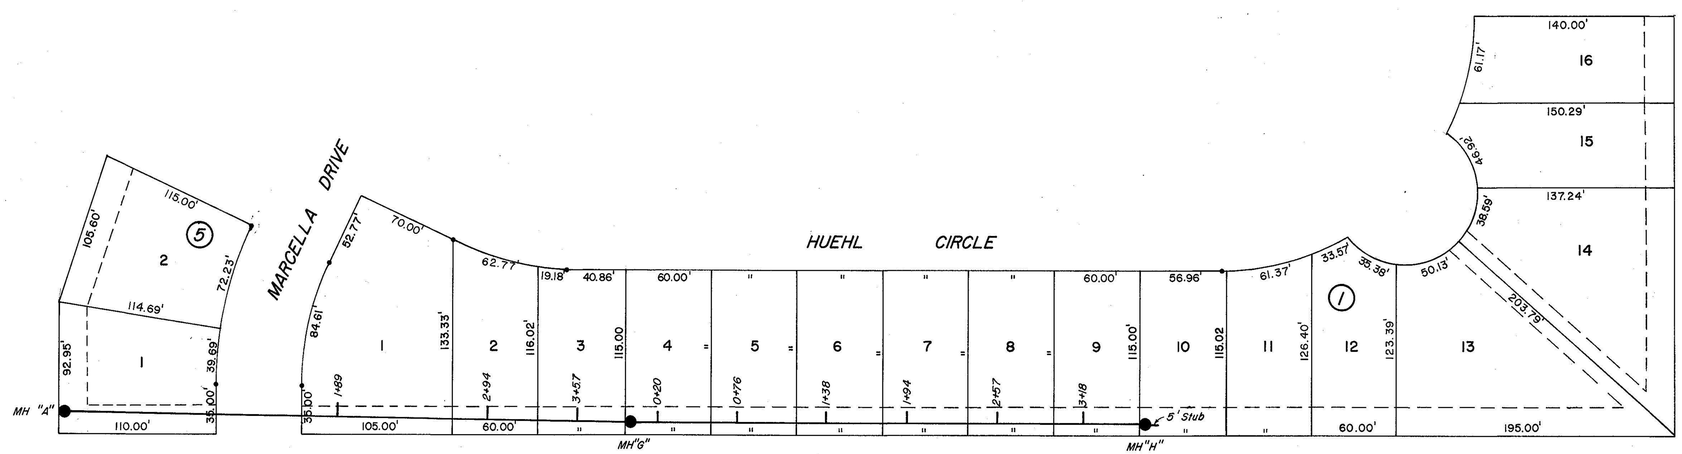

AS-BUILT PLAN
PROJECT NO. 89-789
STEVENS CONST. INC.
COMP. DATE : MAY, 1990

PLAN
SURVEYED
PLOTTED
NOTE BOOK
NO.
GRADES CHECKED
BASE MAPS CHECKED
ALIGNMENT CHECKED
PT. OF WAY CHECKED
BY
DATE

PROFILE
SURVEYED
PLOTTED
GRADES CHECKED
BASE MAPS CHECKED
NOTE BOOK
NO.
STRUCTURE NOTATIONS DITTO
BY
DATE

HIGHWAY FEDERAL AID SHEET
PLATE 1-SINGLE PLAN AND PROFILE-FULL DOT
STEREOTYPE
PRINTED IN U.S.A.