AS-BUILT PLAN
PROJECT NO. 89-789
STEVENS CONST. INC.
COMP. DATE: MAY, 1990

546

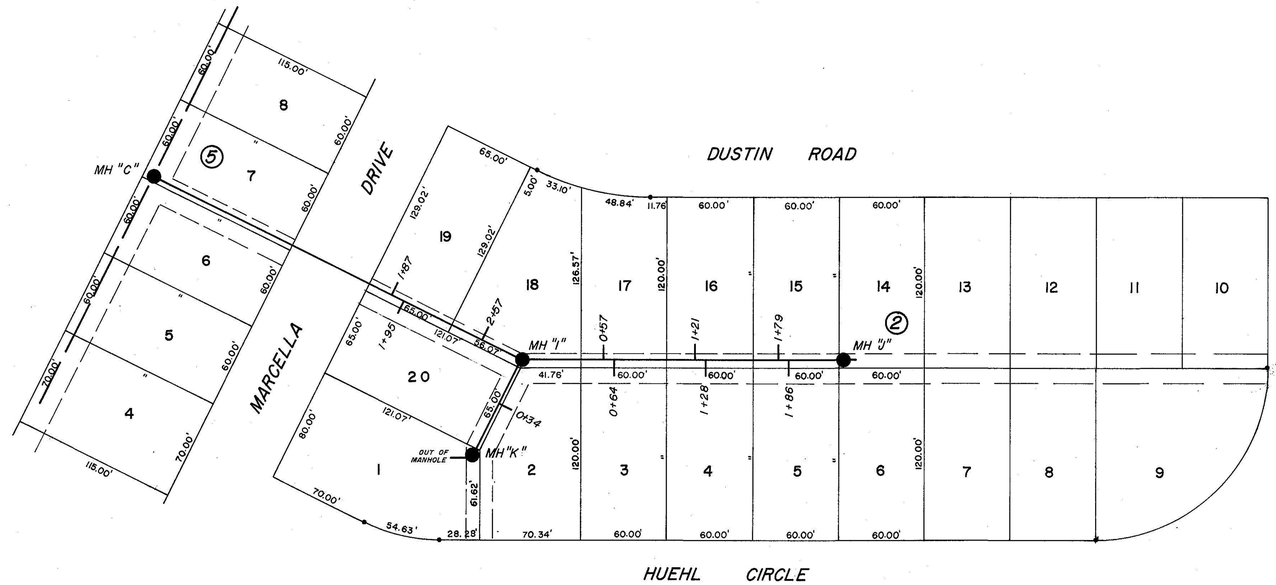

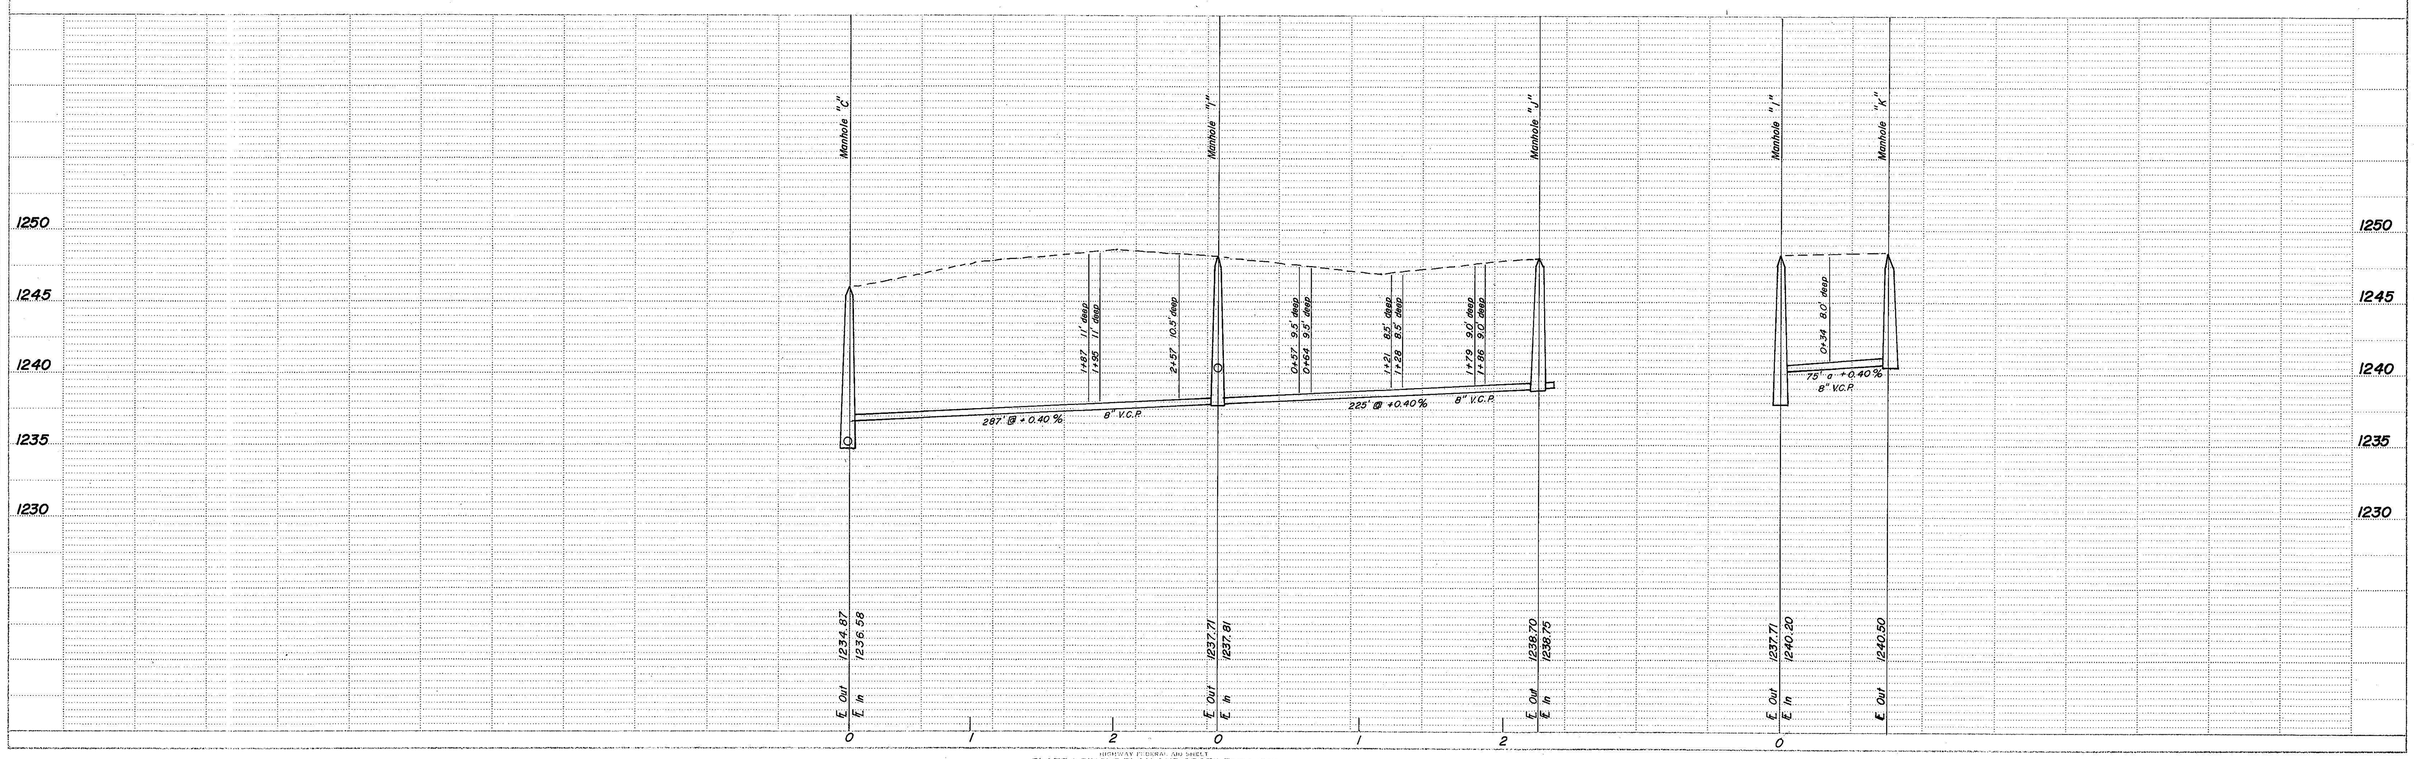

PLAN
SURVEYED
PLOTTED
ROUTE
ALIGNMENT CHECKED
RT. OF WAY CHECKED
NOTE BOOK
NO.
BY
DATE

PROFILE
SURVEYED
PLOTTED
GRADES CHECKED
B.M. NOTE
STRUCTURE NOTATIONS CHKD
NOTE BOOK
NO.
BY
DATE