547

AS-BUILT PLAN
PROJECT NO. 89-789
STEVENS CONST. INC.
COMP. DATE: MAY, 1990

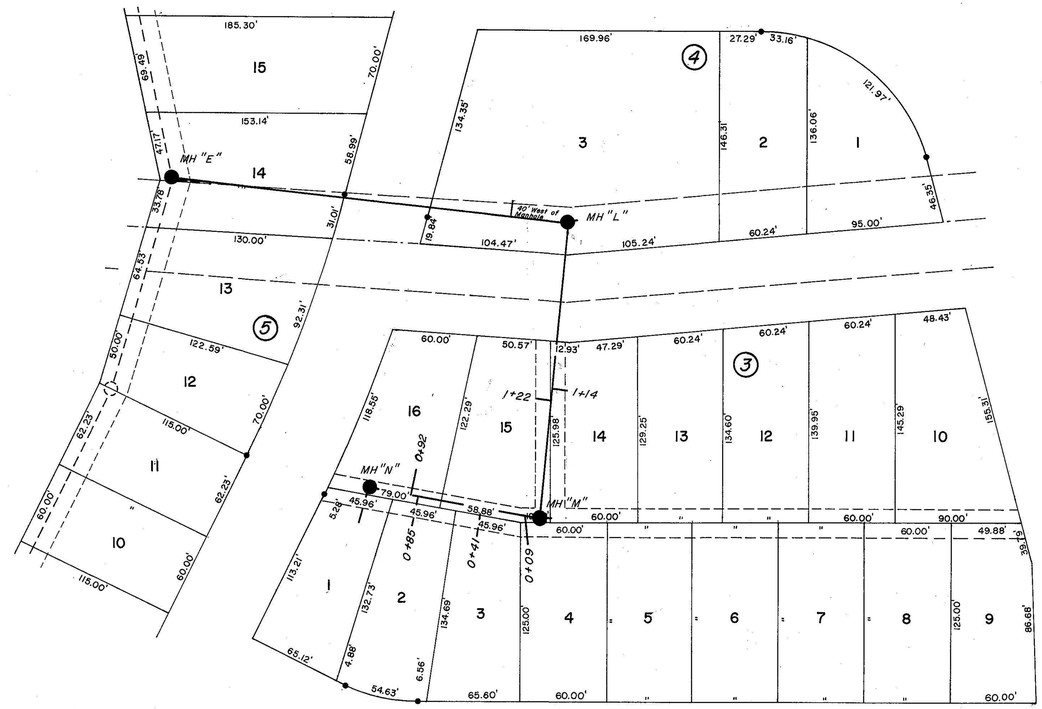

PLAN
SURVEYED
PLOTTED
ALIGNMENT CHECKED
BY
DATE
NOTE BOOK
NO.

PROFILE
SURVEYED
PLOTTED
GRADES CHECKED
BY
DATE
NOTE BOOK
NO.
STRUCTURE NOTATIONS CHKD