As-Built Plan
Project No. 89-789
Stevens Const. Inc.
Comp. Date: May, 1990

548

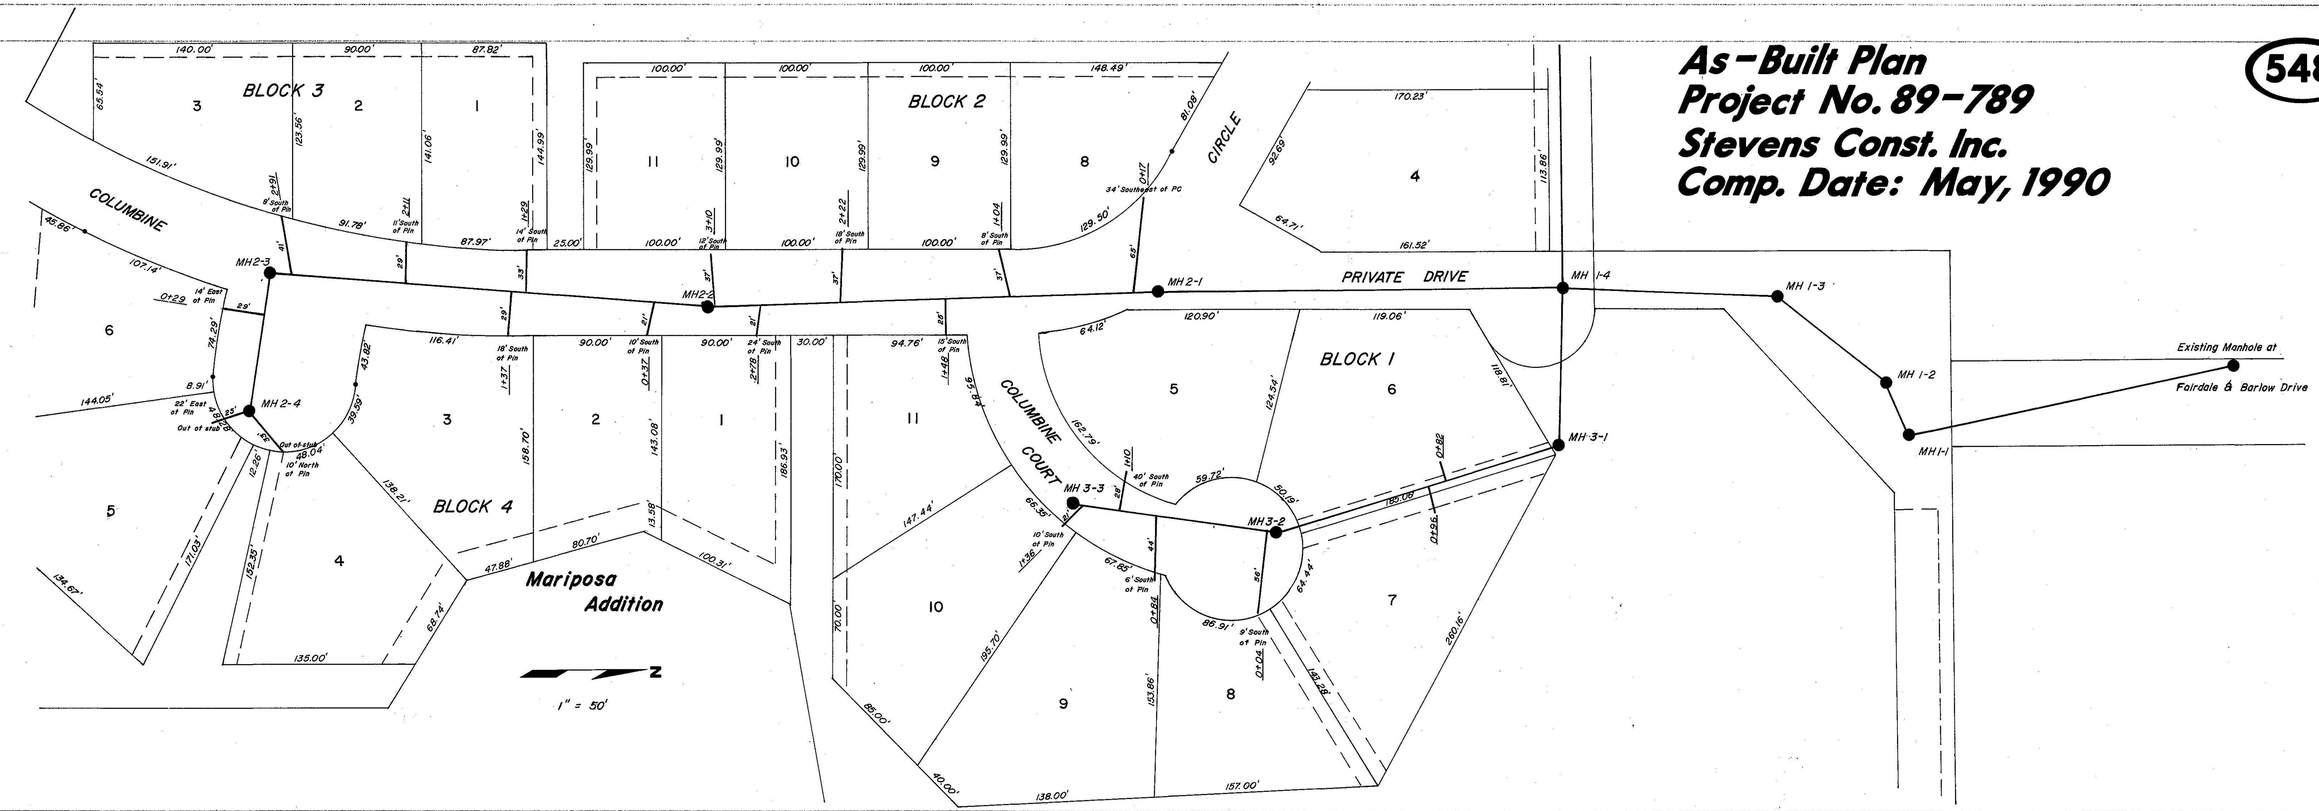

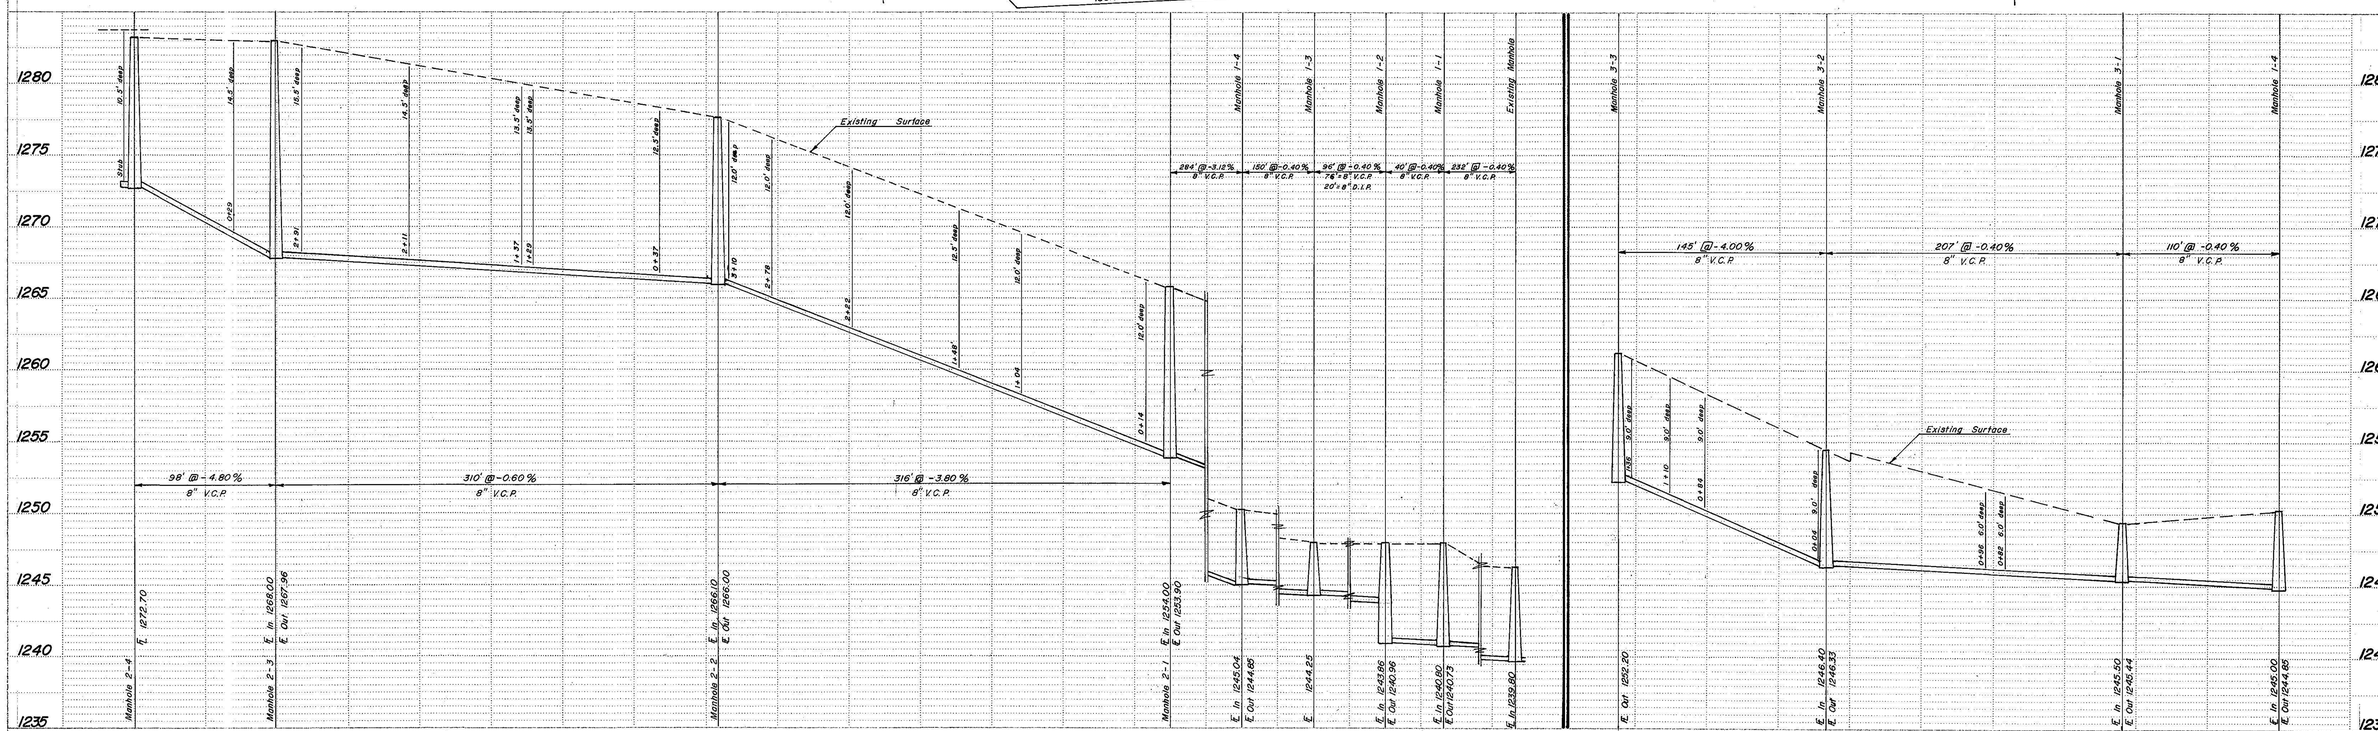

PLAN
SURVEYED
DRAWN
NOTE BOOK
NO.
ALIGNMENT CHECKED
R/W CHECKED
BY
DATE

PROFILE
SURVEYED
DRAWN
GRADES CHECKED
B.M. NOTED
STRUCTURE LOCATIONS CHECKED
NOTE BOOK
NO.
BY
DATE

HIGHWAY FEDERAL AID SHEET
PLATE 1-SINGLE PLAN AND PROFILE-FULL DOT
W. TELDWINE
PRINTED IN U.S.A.