549

As-Built Plan
Project No. 89-789
Stevens Const. Inc.
Comp. Date: May, 1990

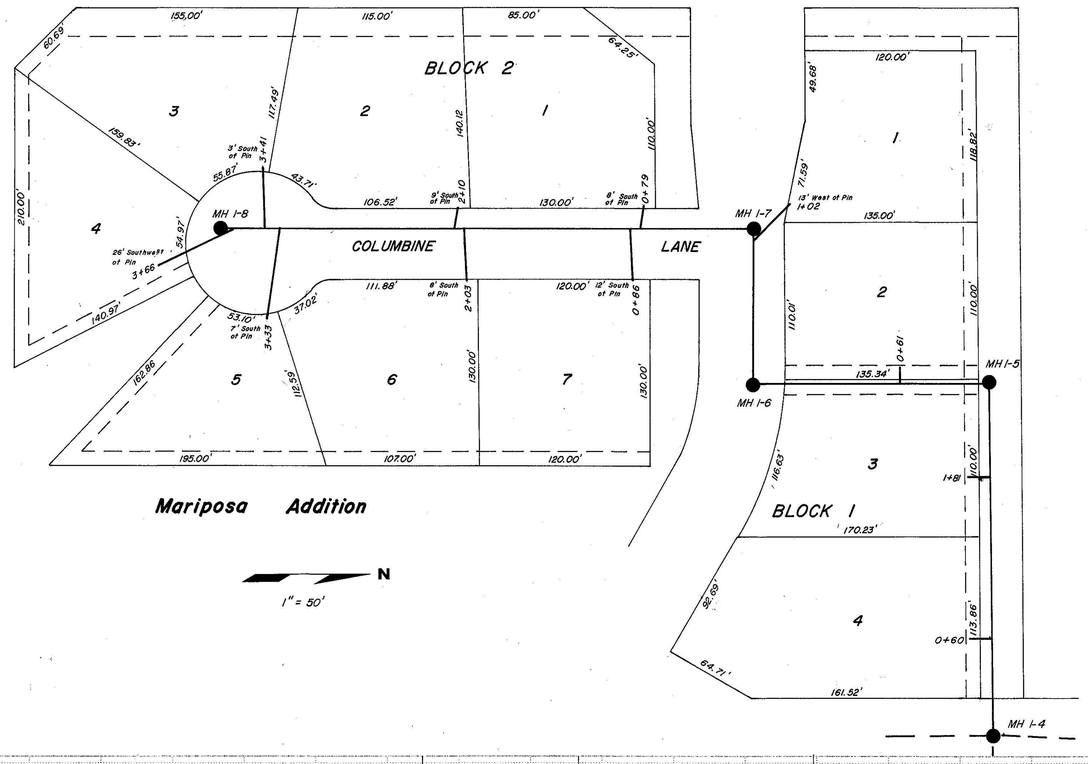

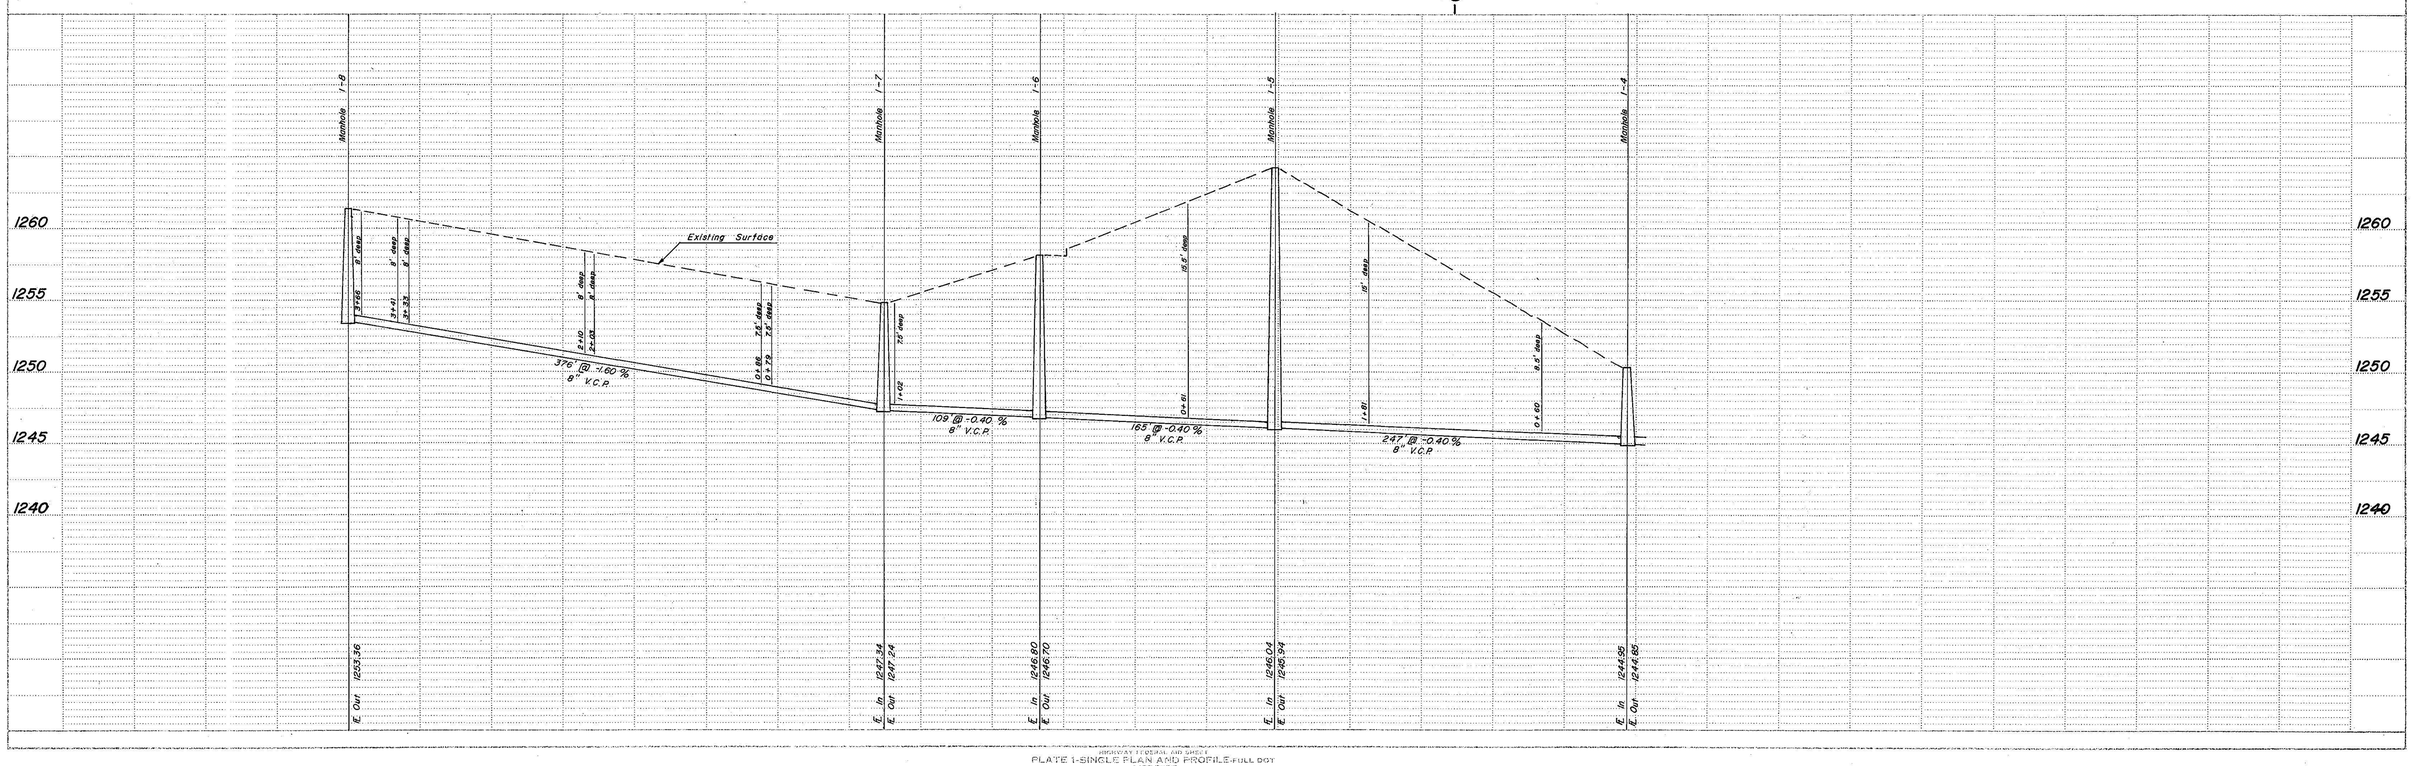

PLAN — SURVEYED / PLOTTED / ALIGNMENT CHECKED / RT. OF WAY CHECKED — NOTE BOOK NO. — BY — DATE

PROFILE — SURVEYED / PLOTTED / GRADES CHECKED / B.M. & STA. VERIFIED / STRUCTURE NOTATIONS CHKD — NOTE BOOK NO. — BY — DATE

HIGHWAY FEDERAL AID SHEET
PLATTE 1-SINGLE PLAN AND PROFILE-FULL DOT
2-7-8-5SHE
PRINTED IN U.S.A.