As-Built Plan
Project No. 89-789
Stevens Const. Inc.
Comp. Date: May, 1990

551

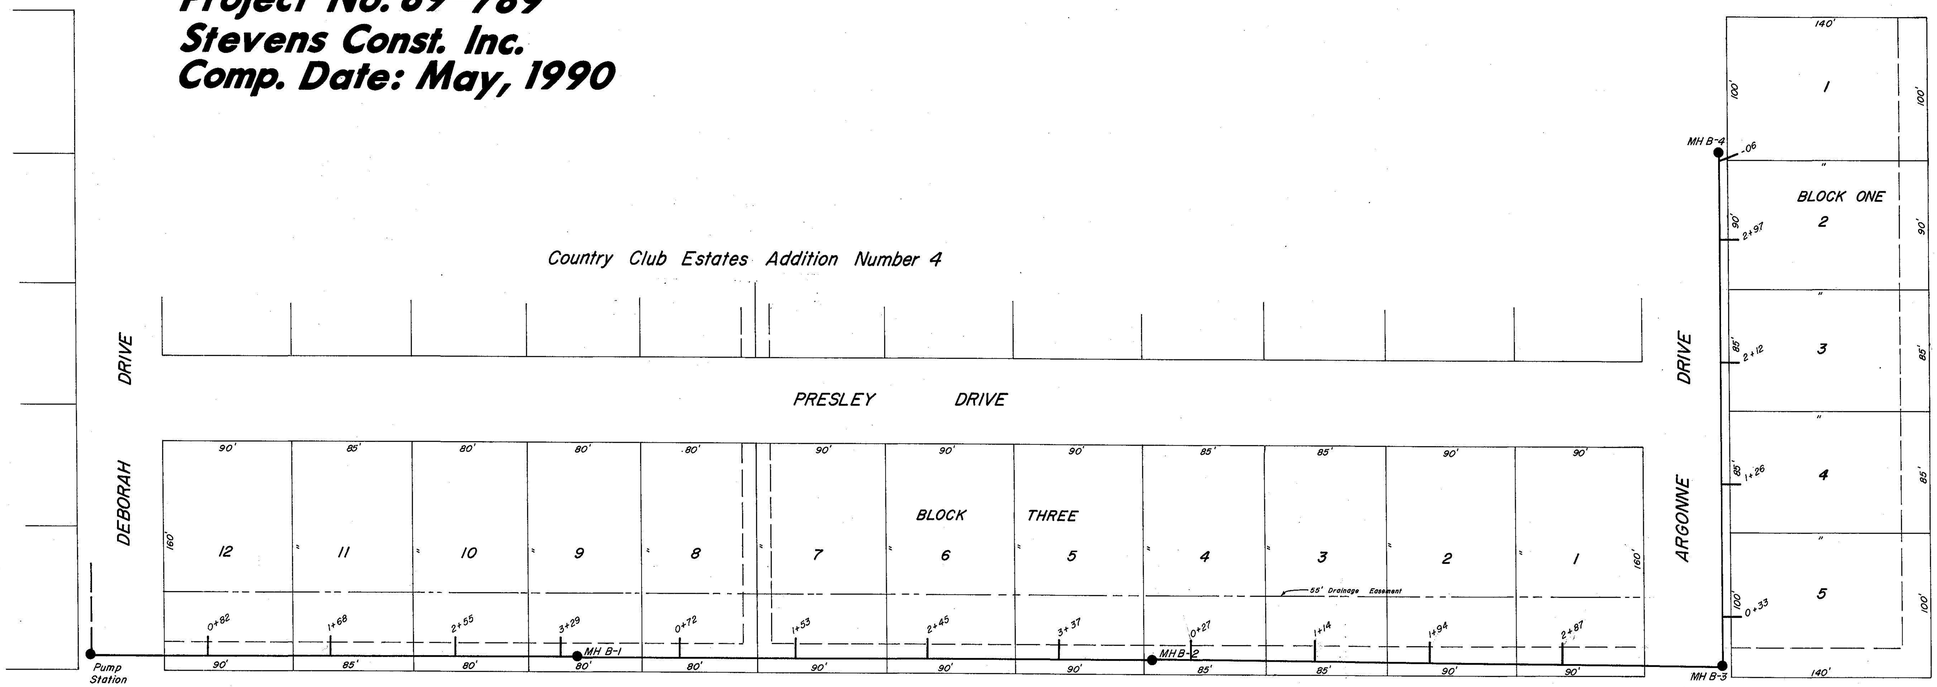

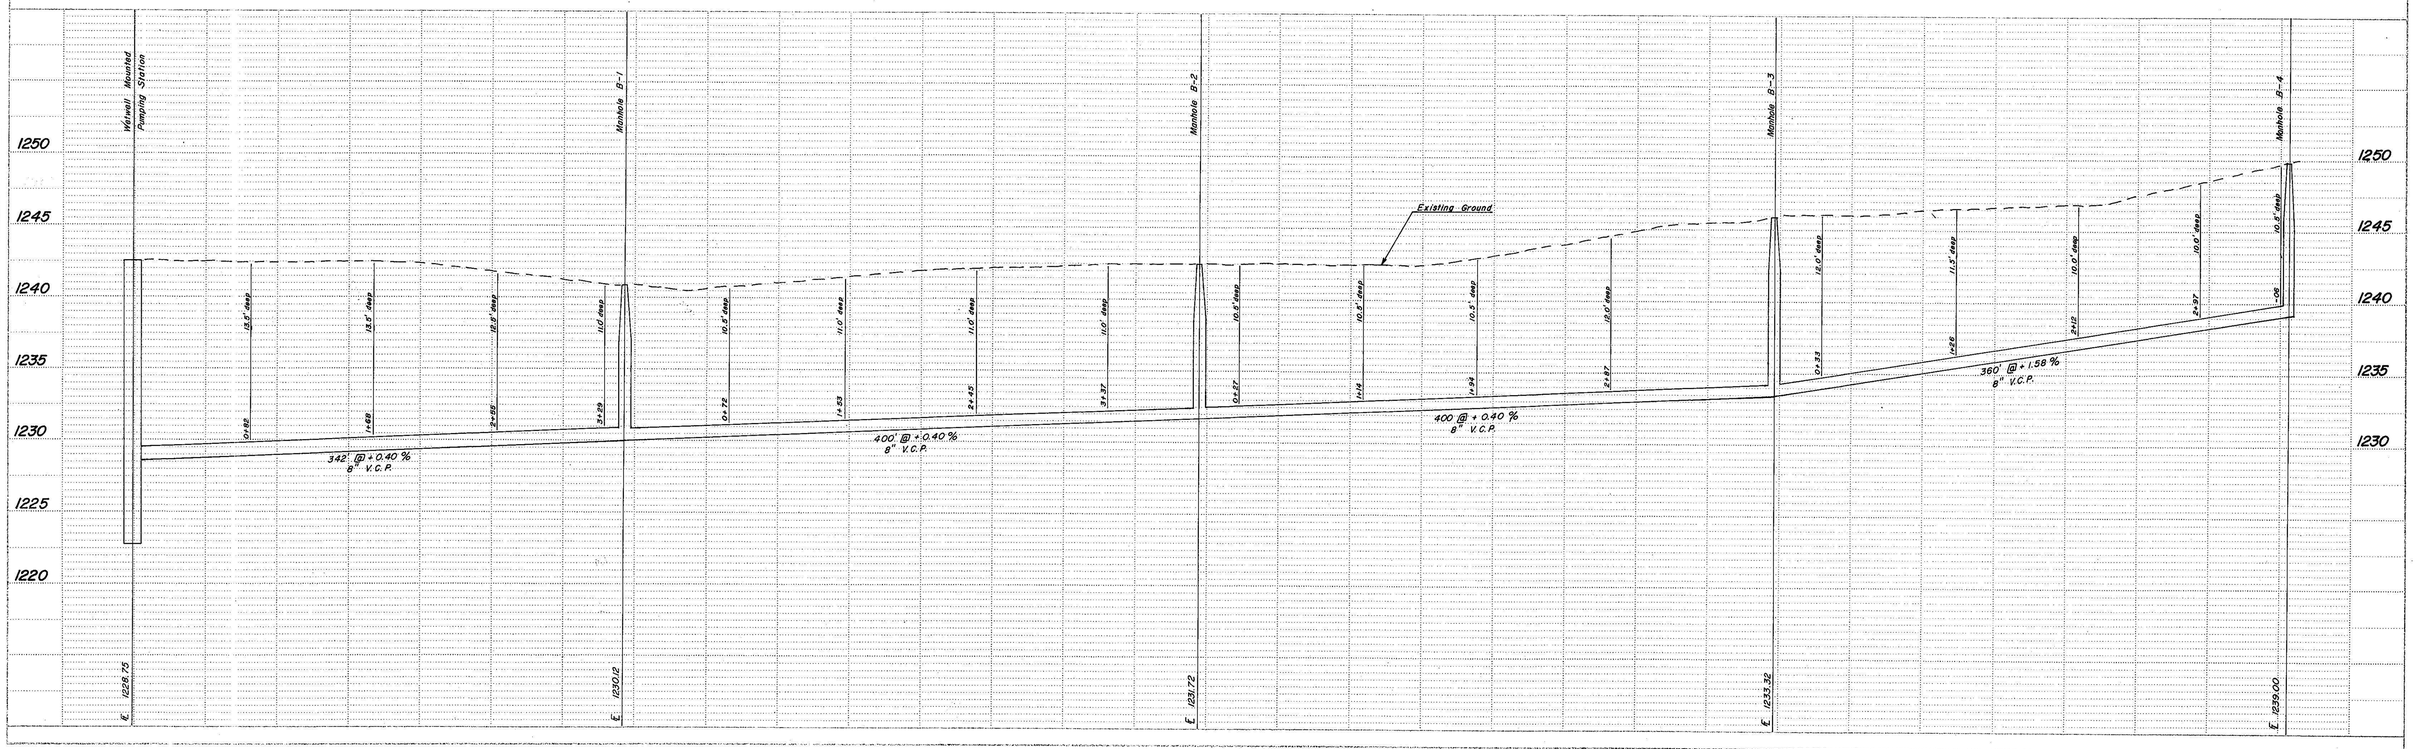

PLATE 1-SINGLE PLAN AND PROFILE-FULL DOT