552

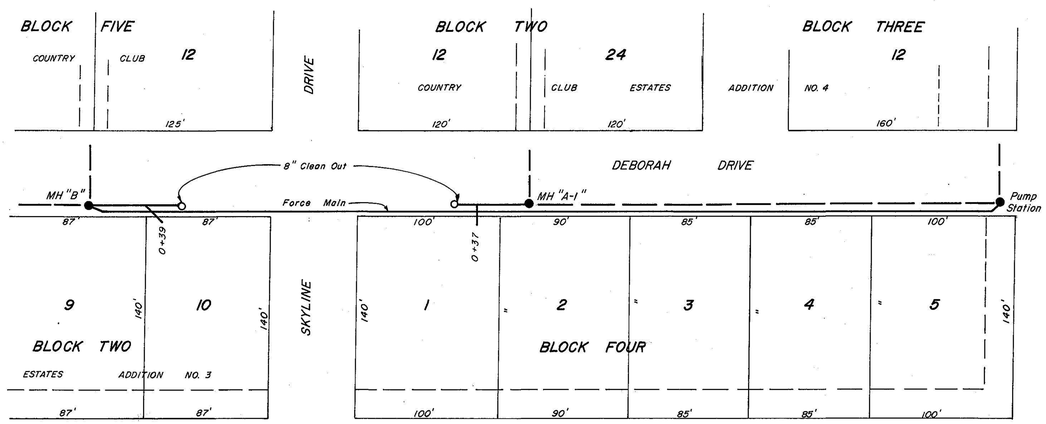

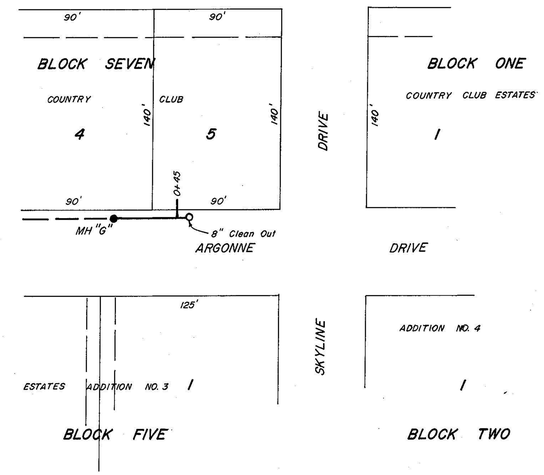

As-Built Plan
Project No. 89-789
Stevens Const. Inc.
Comp. Date: May, 1990

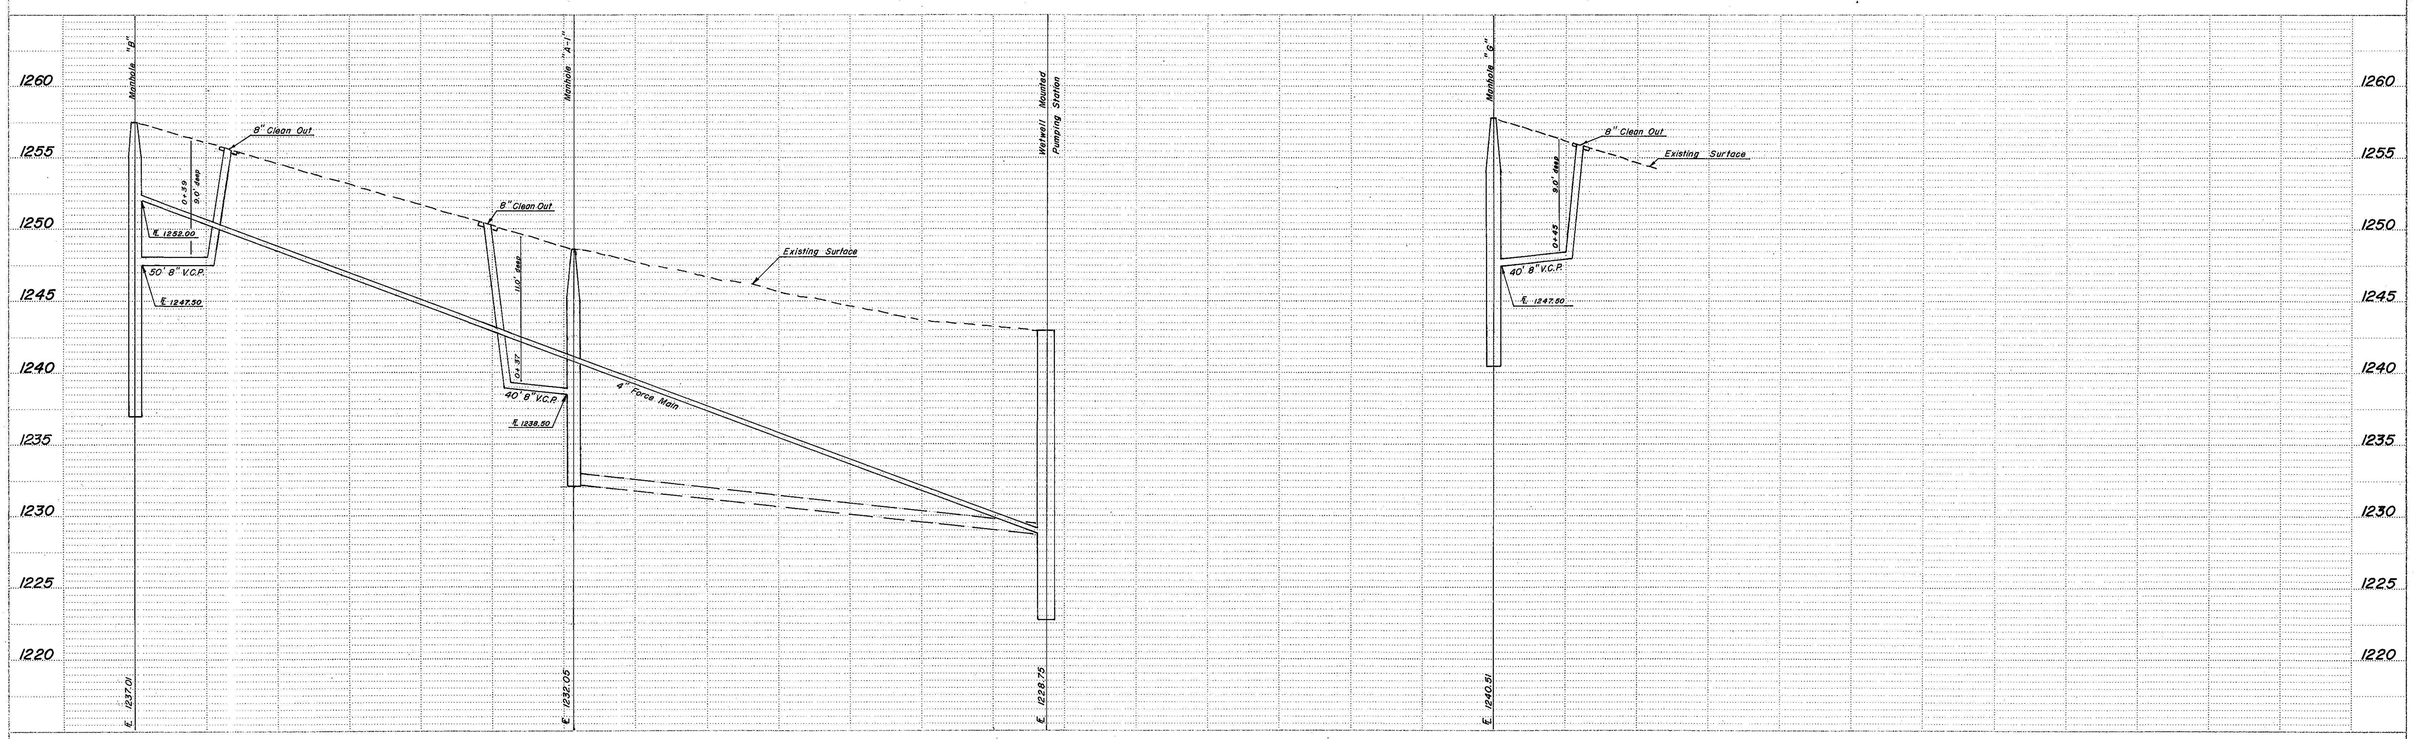

PLAN
NOTE BOOK NO.
SURVEYED
PLOTTED
ALIGNMENT CHECKED
BY
DATE
BY

PROFILE
NOTE BOOK NO.
SURVEYED
PLOTTED
GRADES CHECKED
BY
STRUCTURE NOTATIONS CHKD
BY
DATE