553

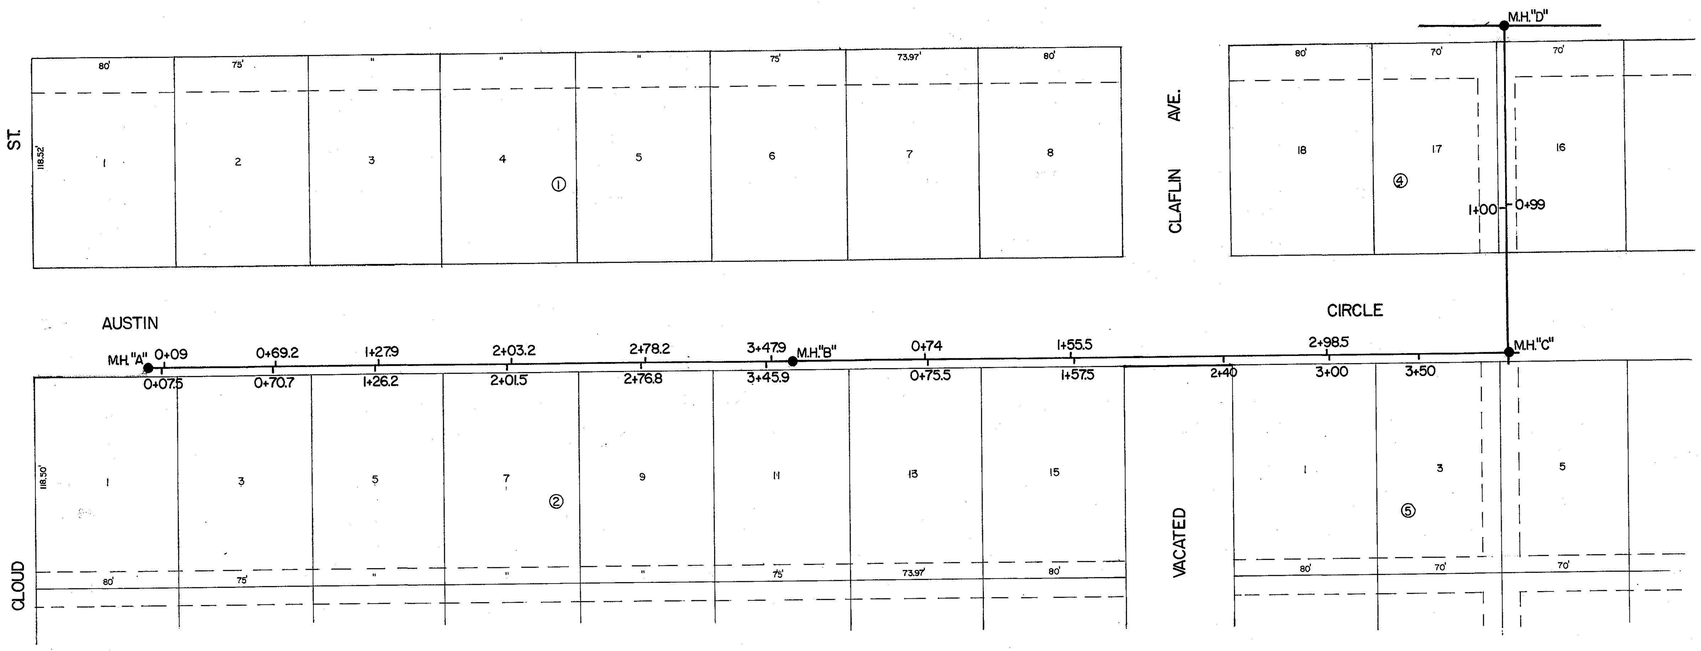

As-Built Plan
Project No. 92-859
Stevens Const. Inc.
Comp. Date: Dec. 1992

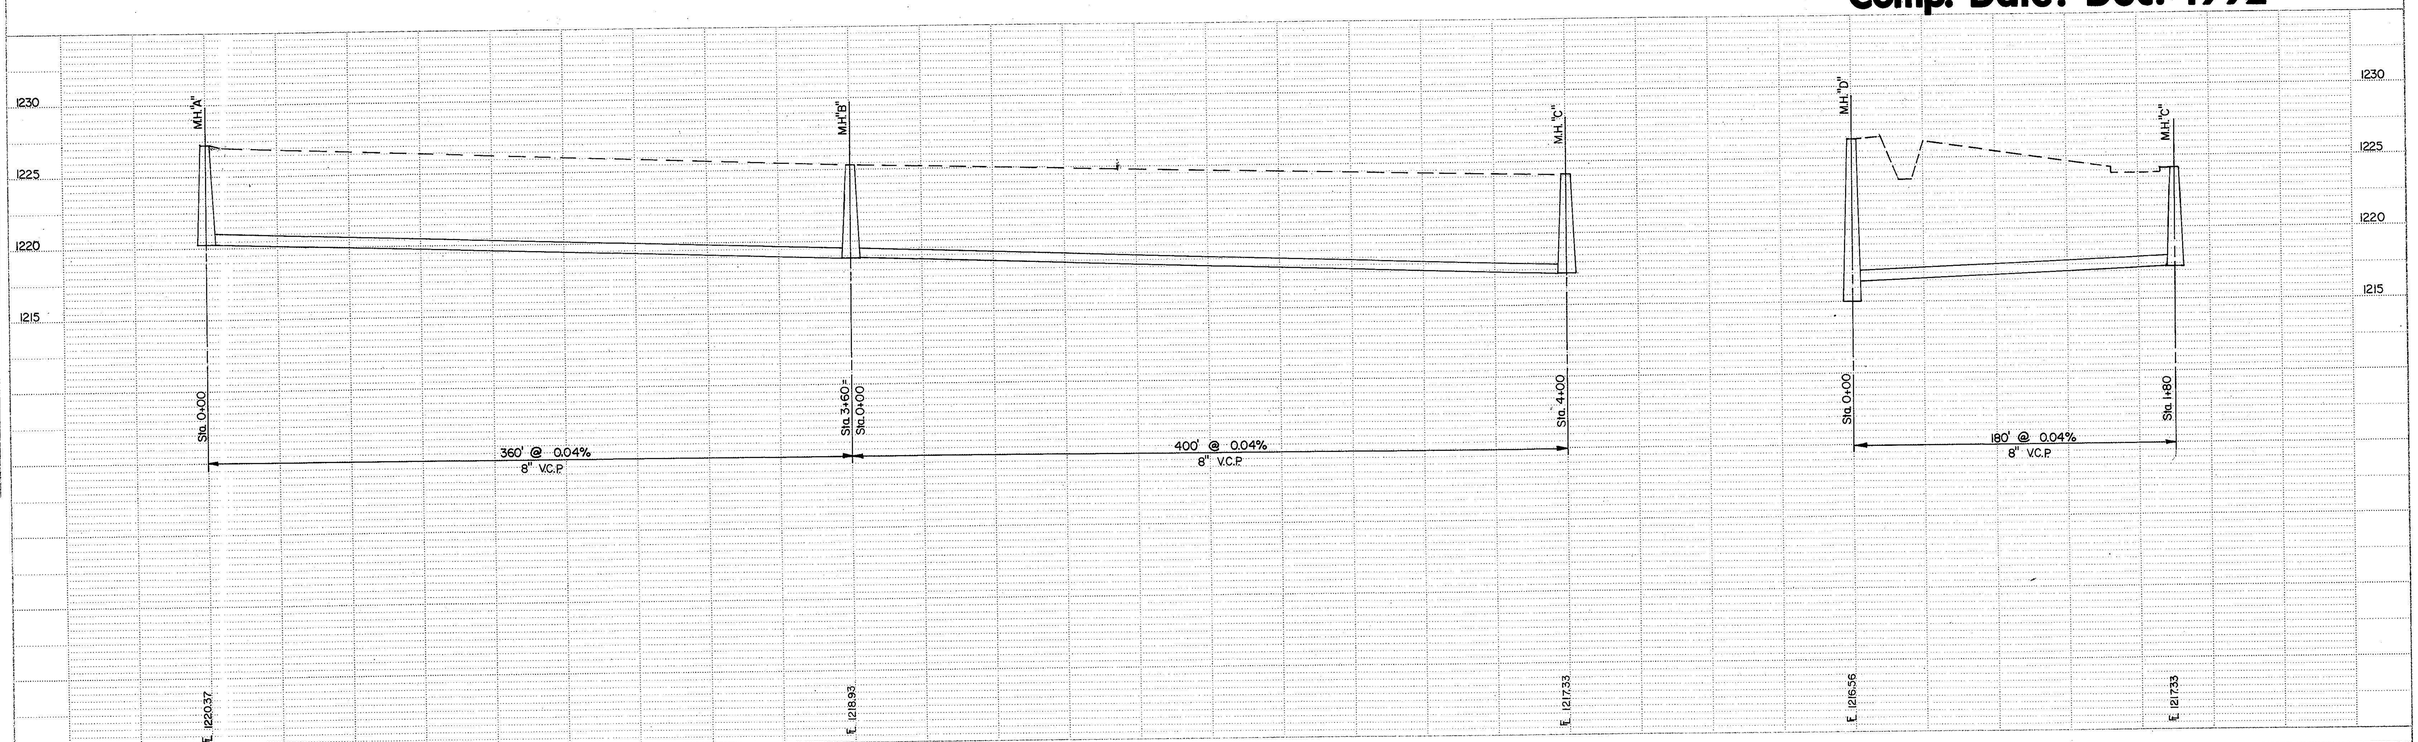

PLAN
SURVEYED
PLOTTED
ALIGNMENT CHECKED
RT. OF WAY CHECKED
NOTE BOOK NO.
BY
DATE

PROFILE
SURVEYED
PLOTTED
GRADES CHECKED
B.M. & NOTED
STRUCTURE NOTATIONS CHECKED
NOTE BOOK NO.
BY
DATE