PLAN

NO.	DATE	BY
NOTE BOOK	SURVEYED	
	PLOTTED	
	ALIGNMENT CHECKED	
	PT. OF WAY CHECKED	

PROFILE

NO.	DATE	BY
NOTE BOOK	SURVEYED	
	PLOTTED	
	GRADES CHECKED	
	R.P. & MONTED	
	STRUCTURE LOCATIONS CHKD.	

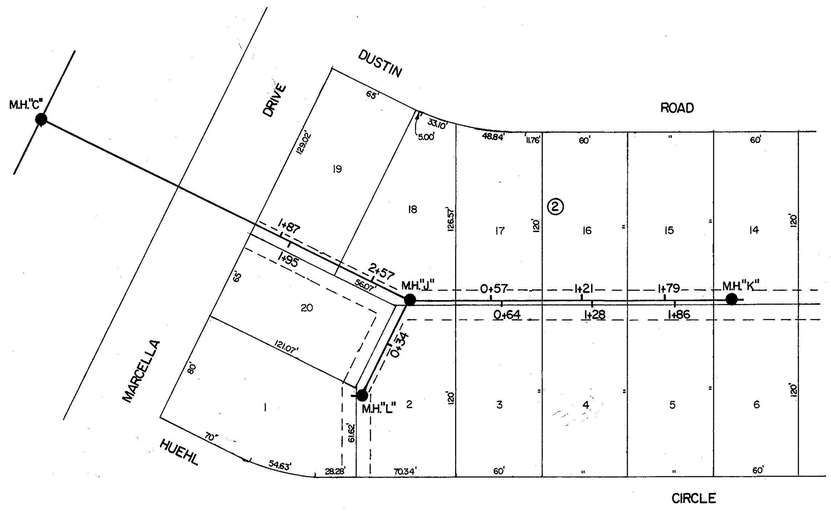

N

Scale: 1" = 50'

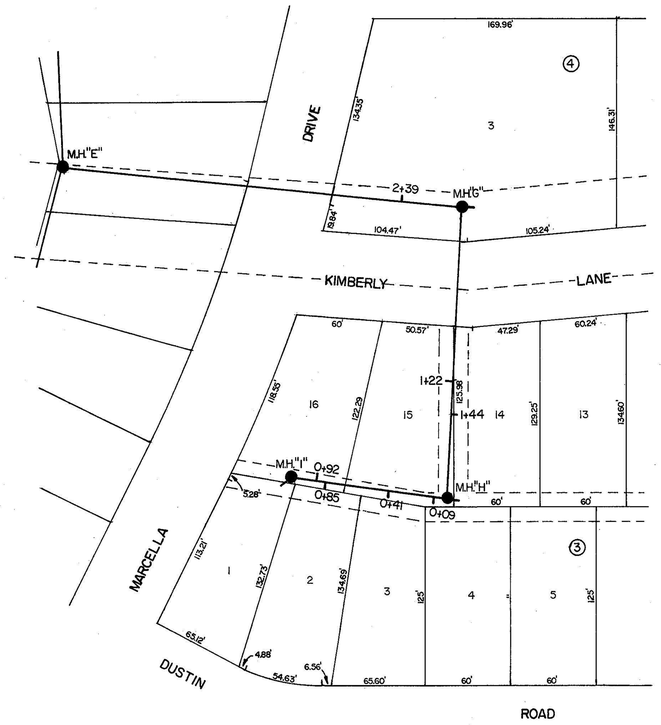

554

As-Built Plan
Project No. 89-789
Stevens Const. Inc.
Comp. Date: June 1990

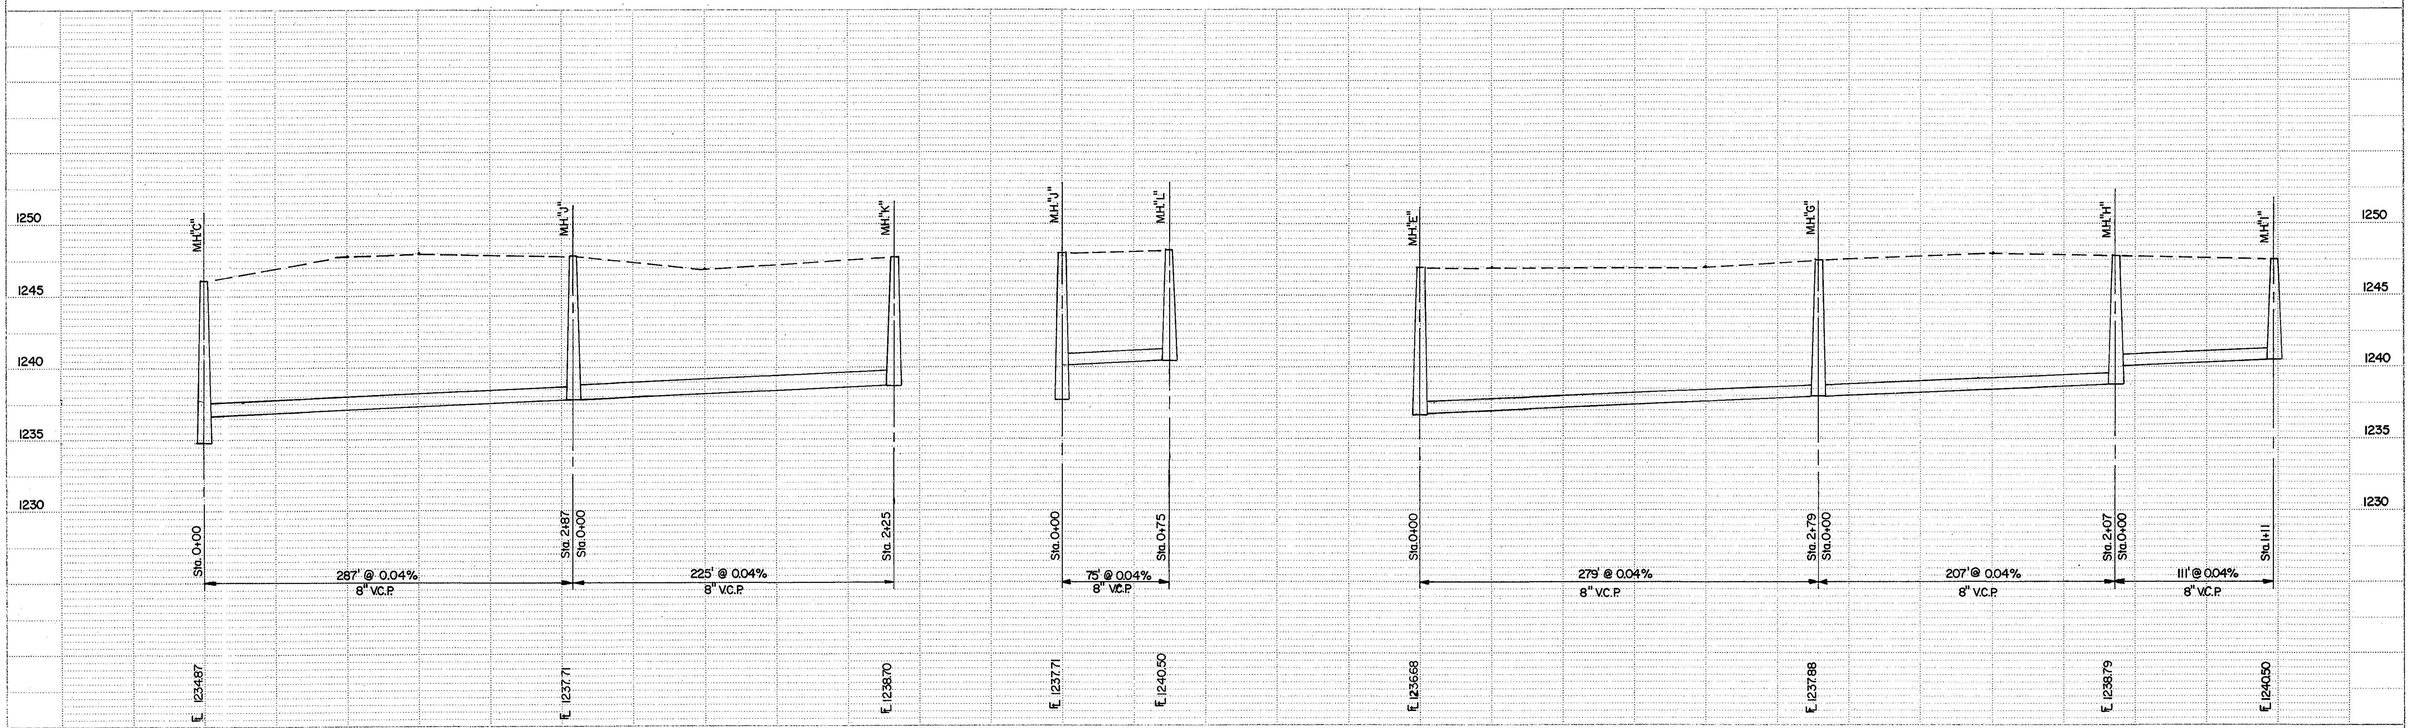

PLATE 1-SINGLE PLAN AND PROFILE-FULL SCT