555

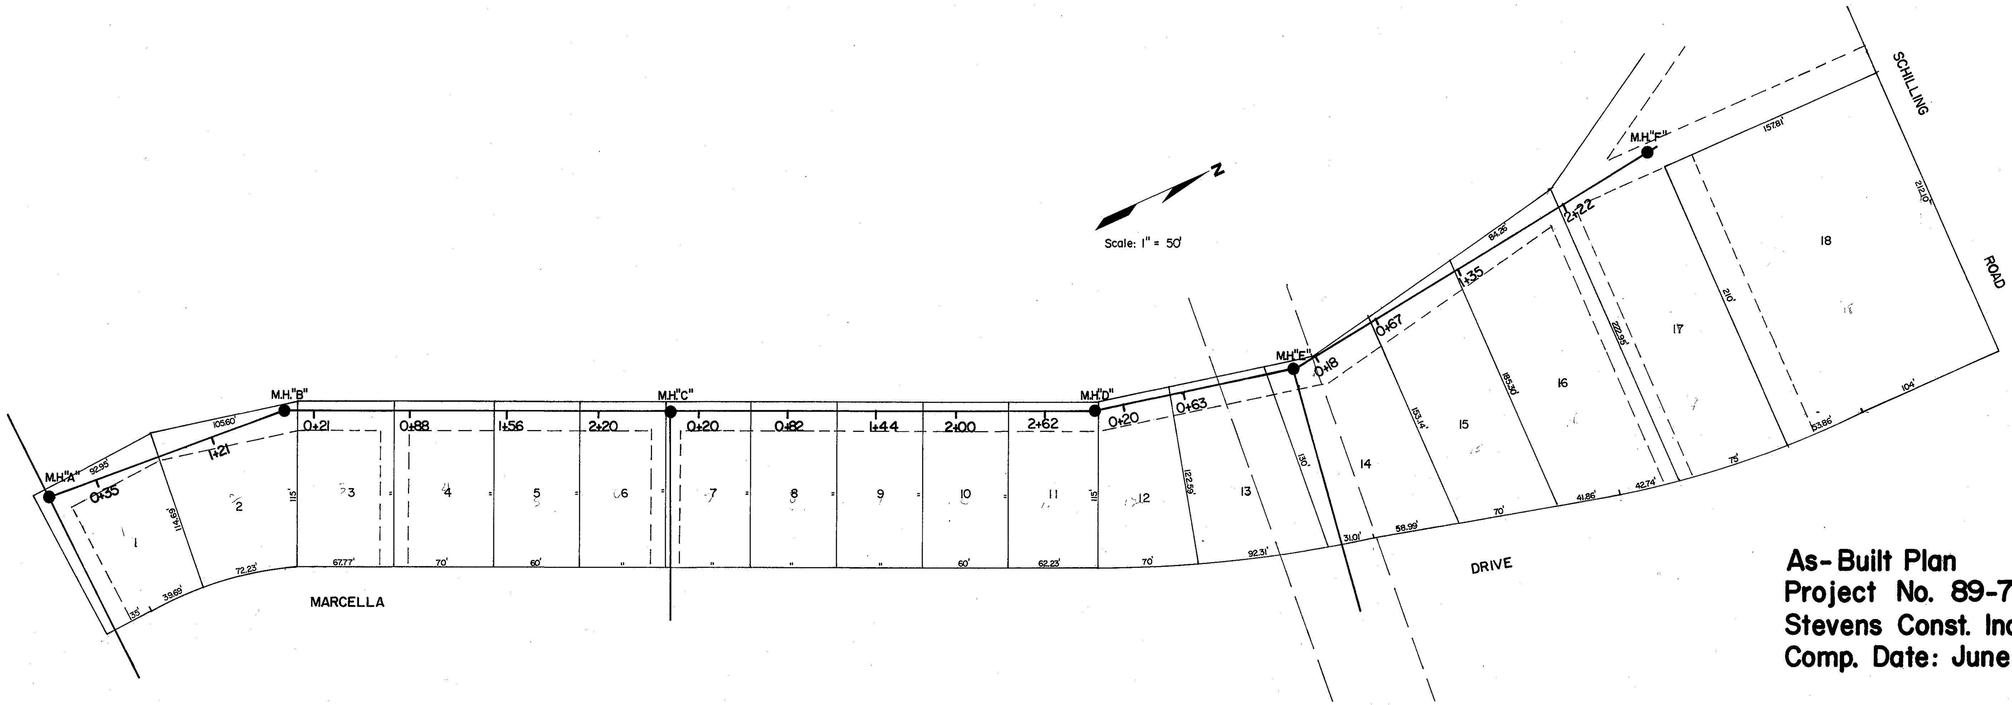

As-Built Plan
Project No. 89-789
Stevens Const. Inc.
Comp. Date: June 1990

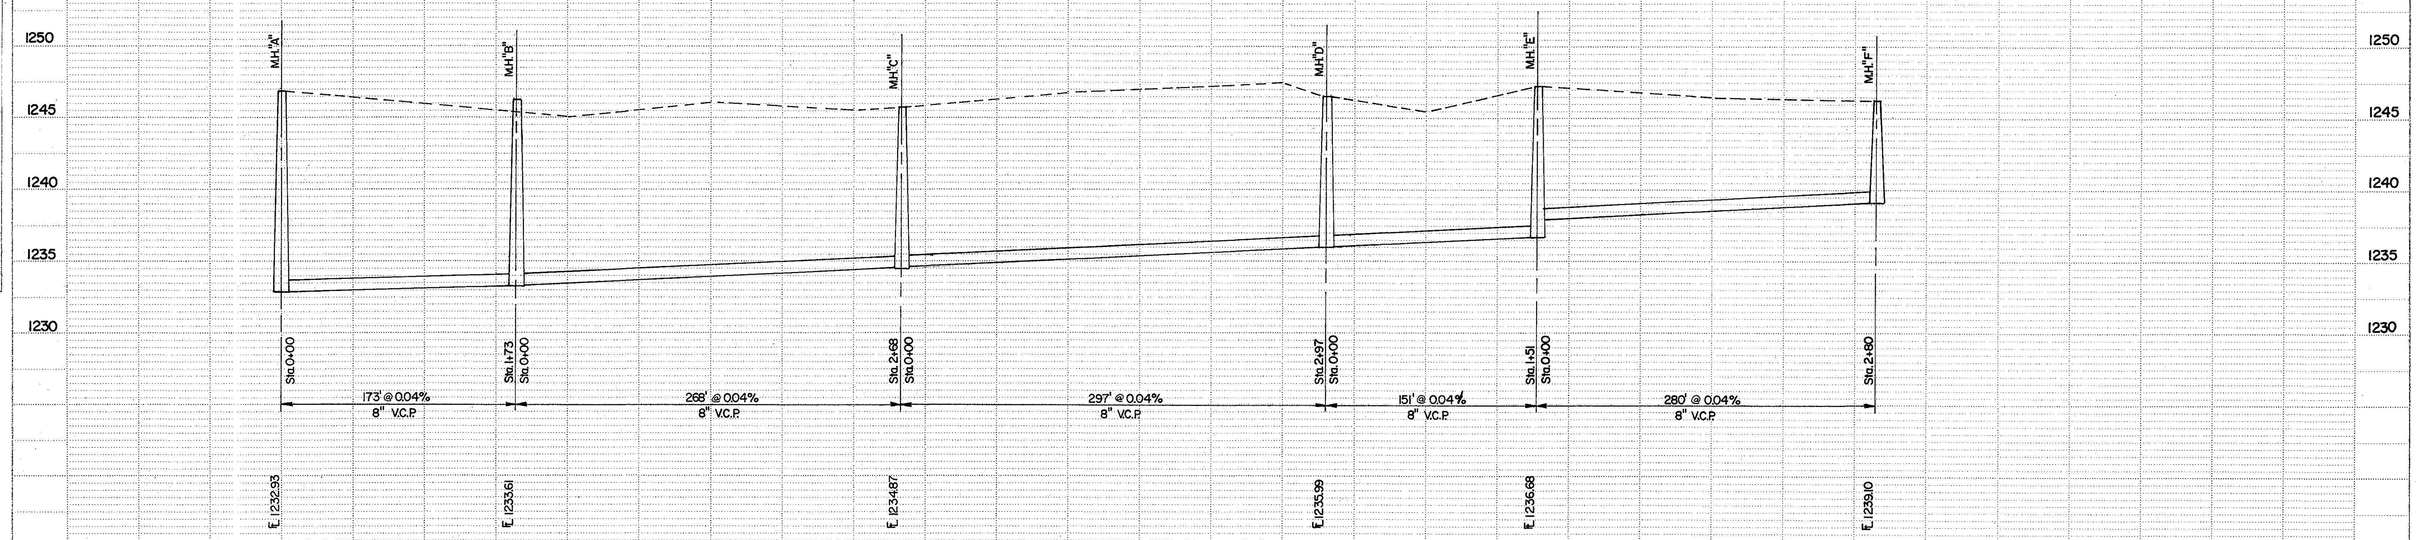

PLATE 1-SINGLE PLAN AND PROFILE-FULL DOT