558

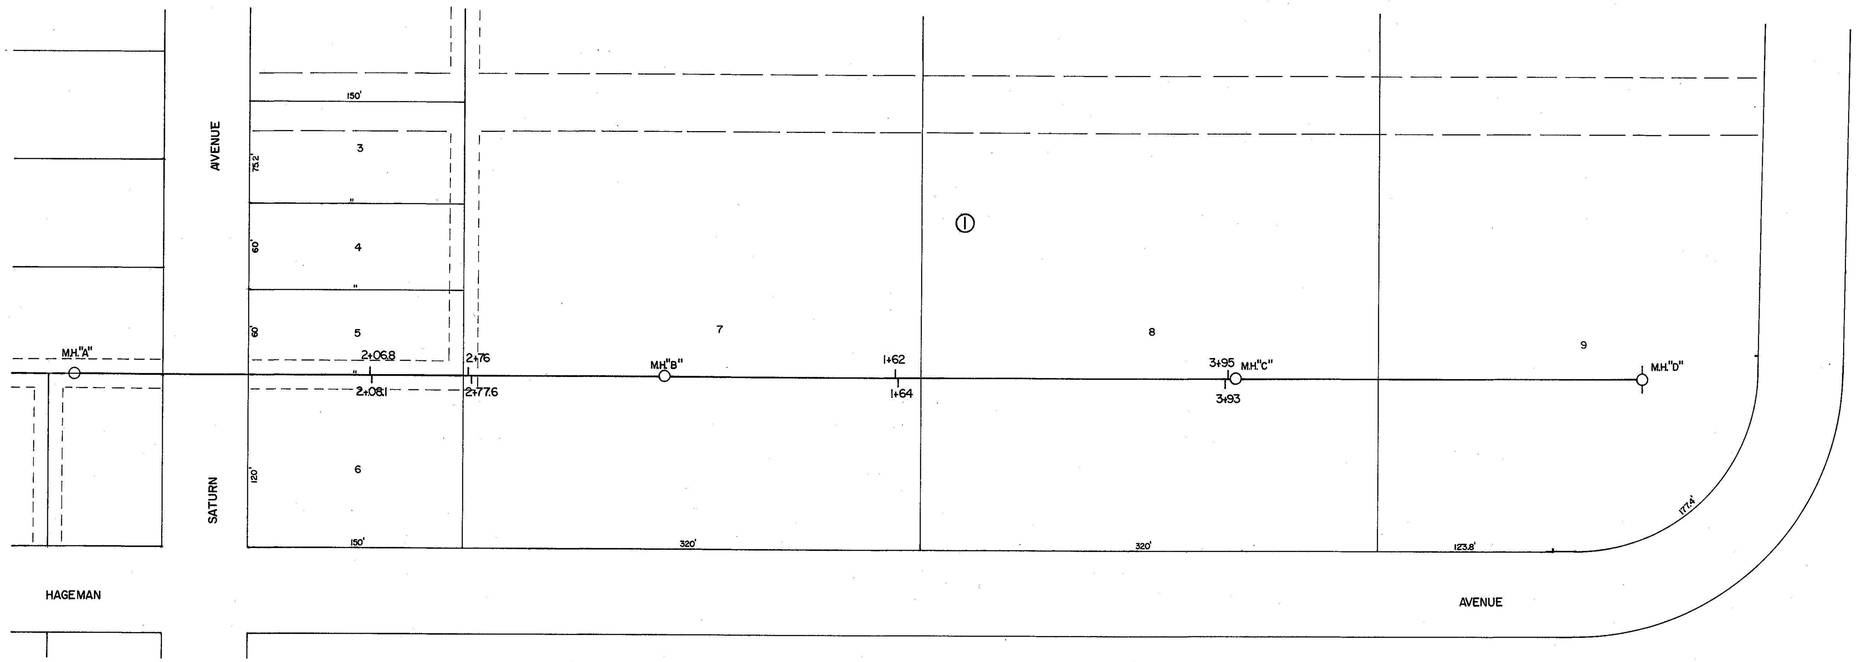

N

Scale: 1" = 50'

As-Built Plan
Project No. 92-852

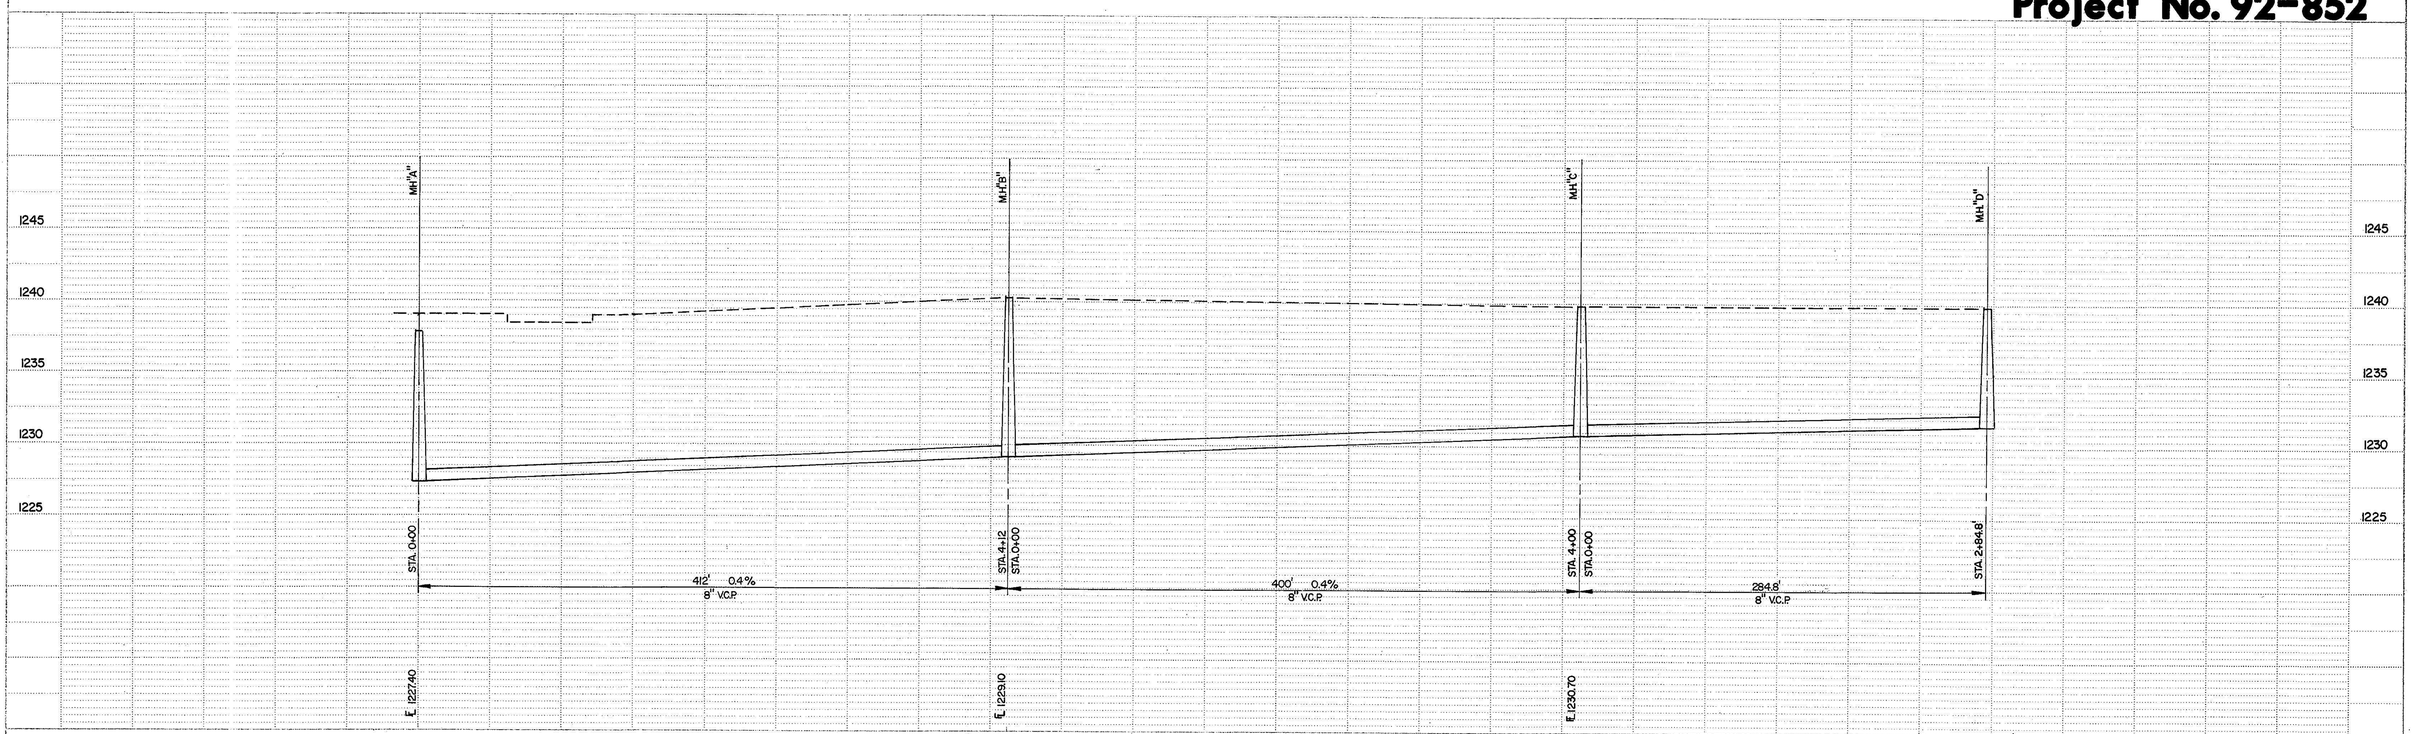

PLAN | SURVEYED | PLOTTED | ALIGNMENT CHECKED | R/W CHECKED | NOTE BOOK | NO. | BY | DATE

PROFILE | SURVEYED | PLOTTED | GRADES CHECKED | R/W CHECKED | STRUCTURE NO(S) & TYPE(S) CHECKED | NOTE BOOK | NO. | BY | DATE