559

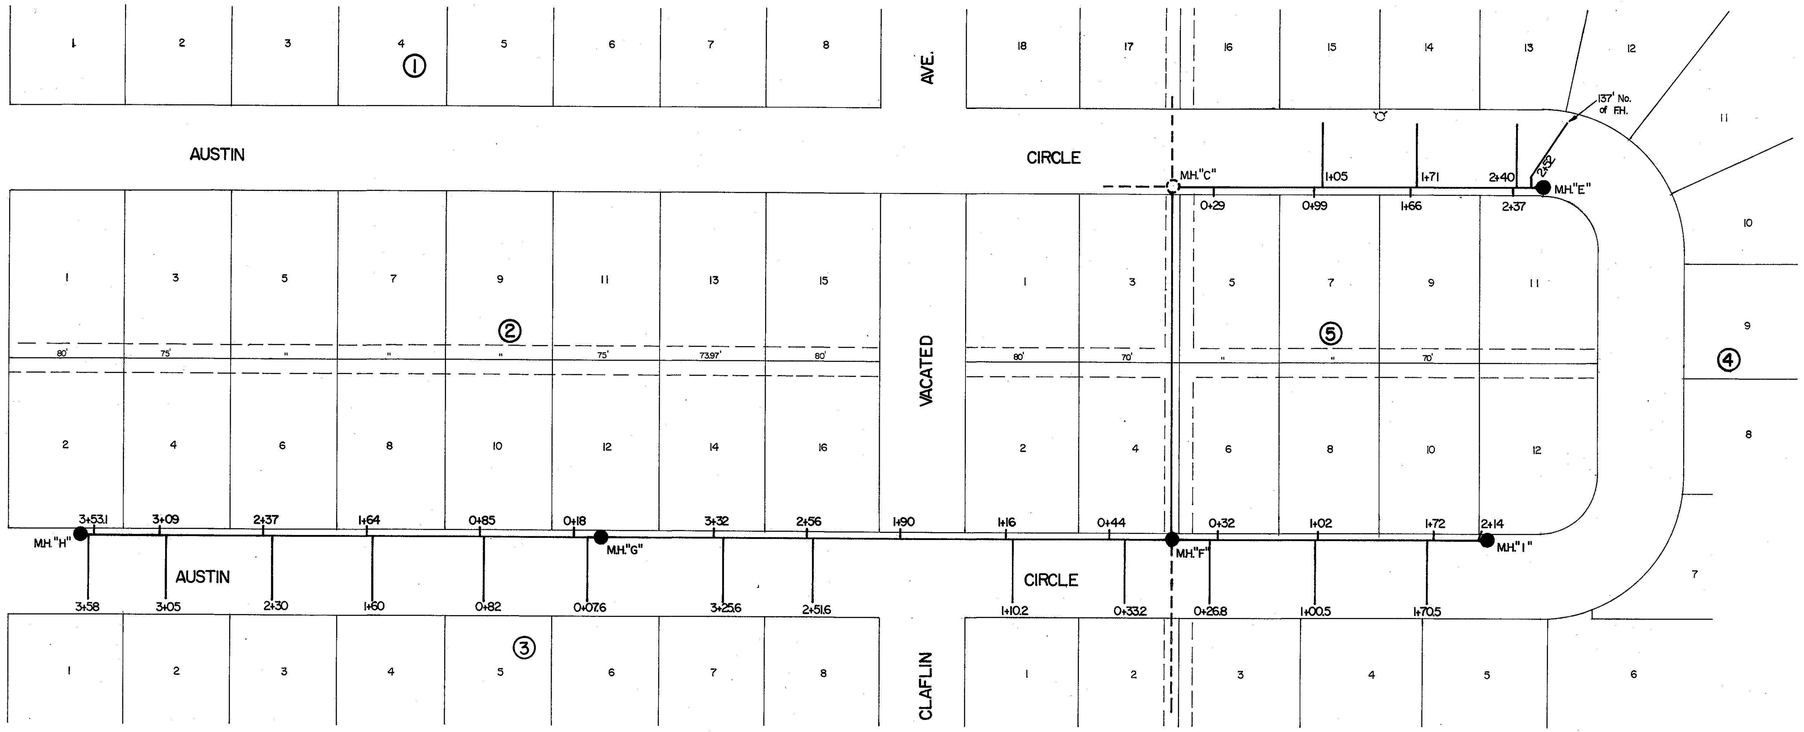

Scale: 1" = 50'

As-Built Plan
Project No. 93-872

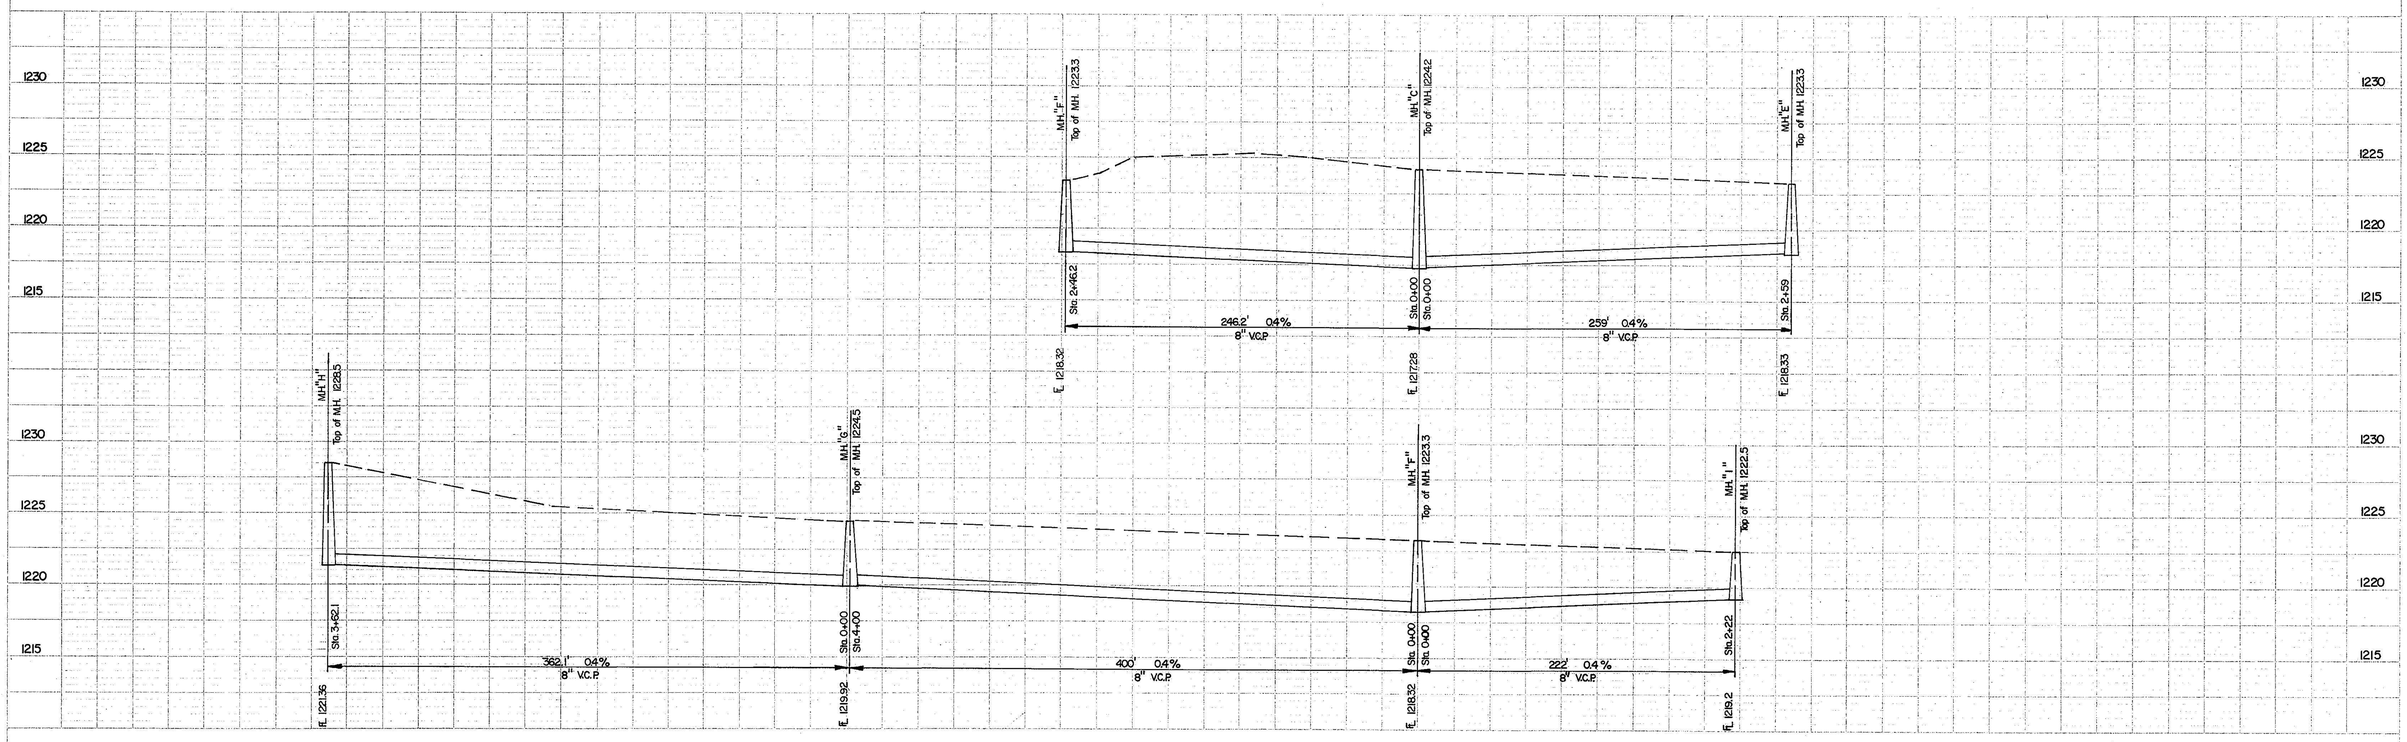

PLATE 1-SINGLE PLAN AND PROFILE-FULL LINE