560

Scale: 1" = 50'

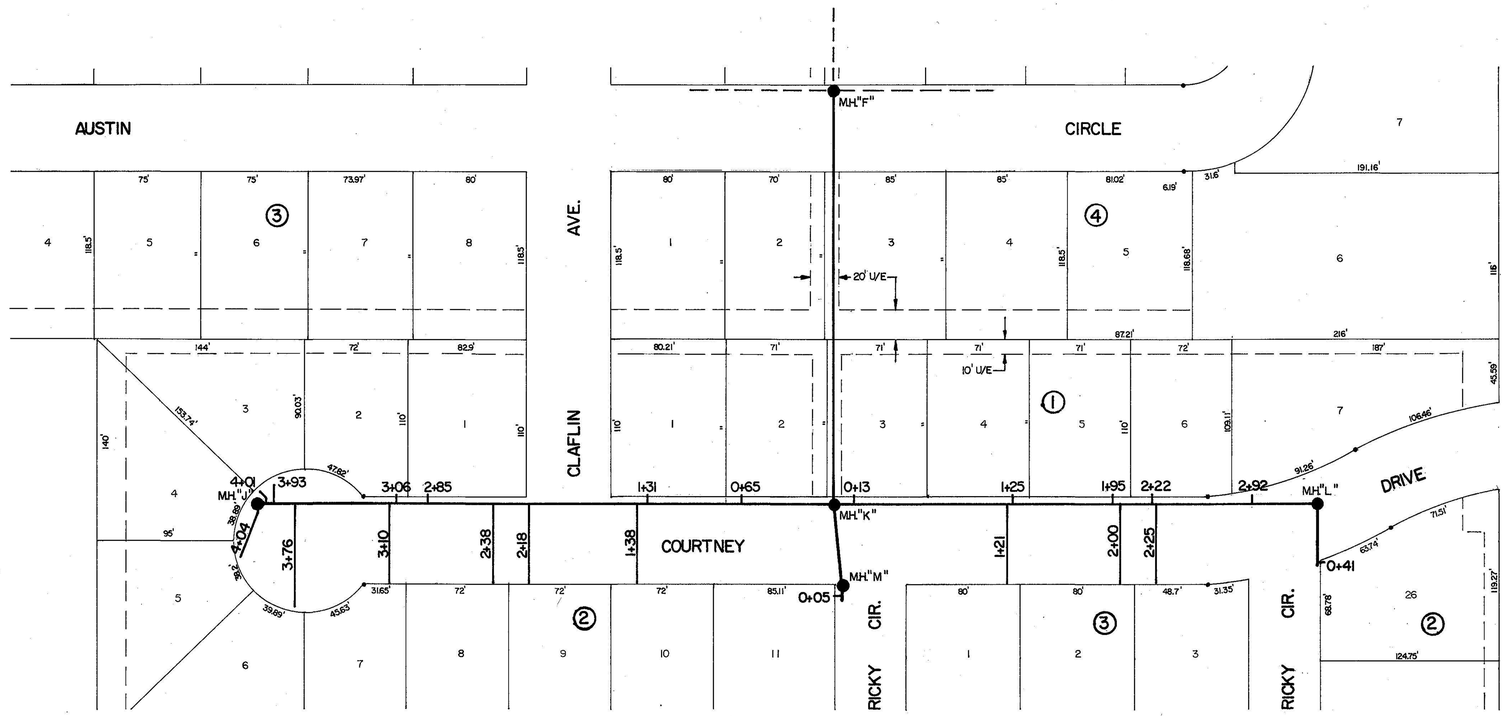

As-Built Plan
Project No. 93-873

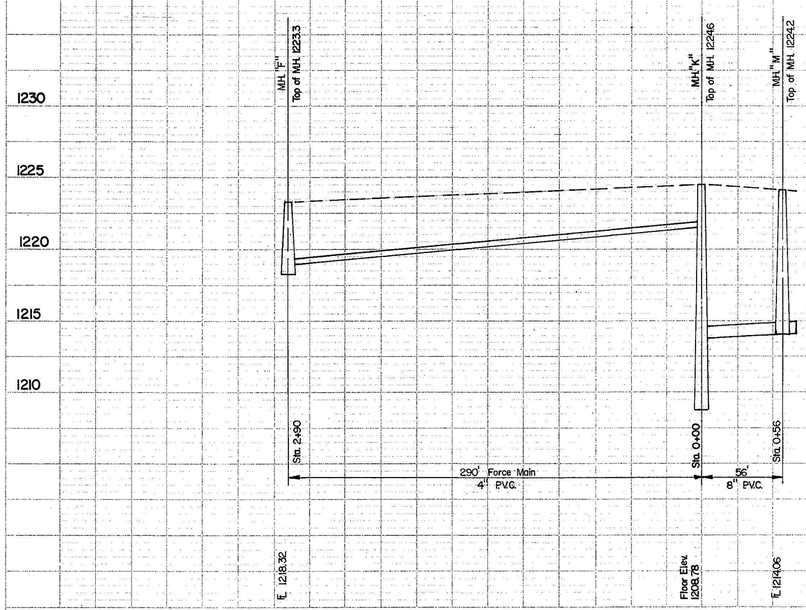

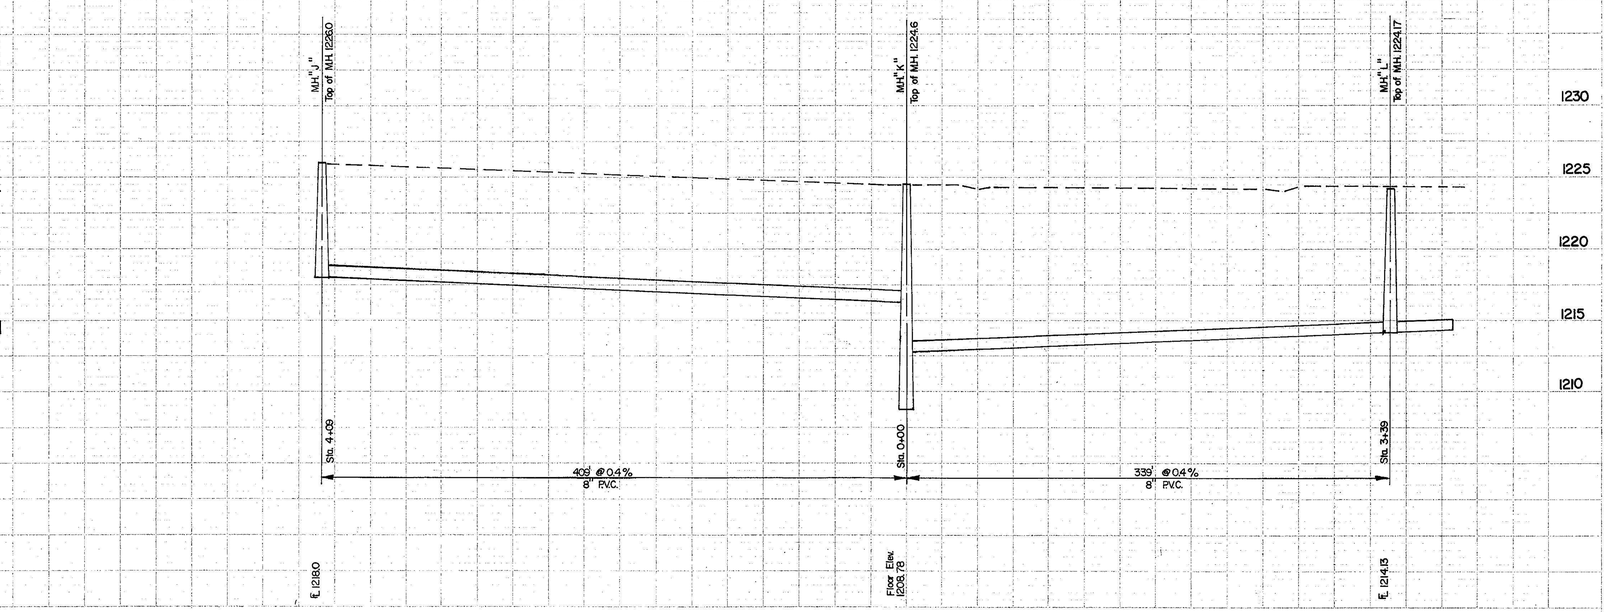

			DATE
			BY