561

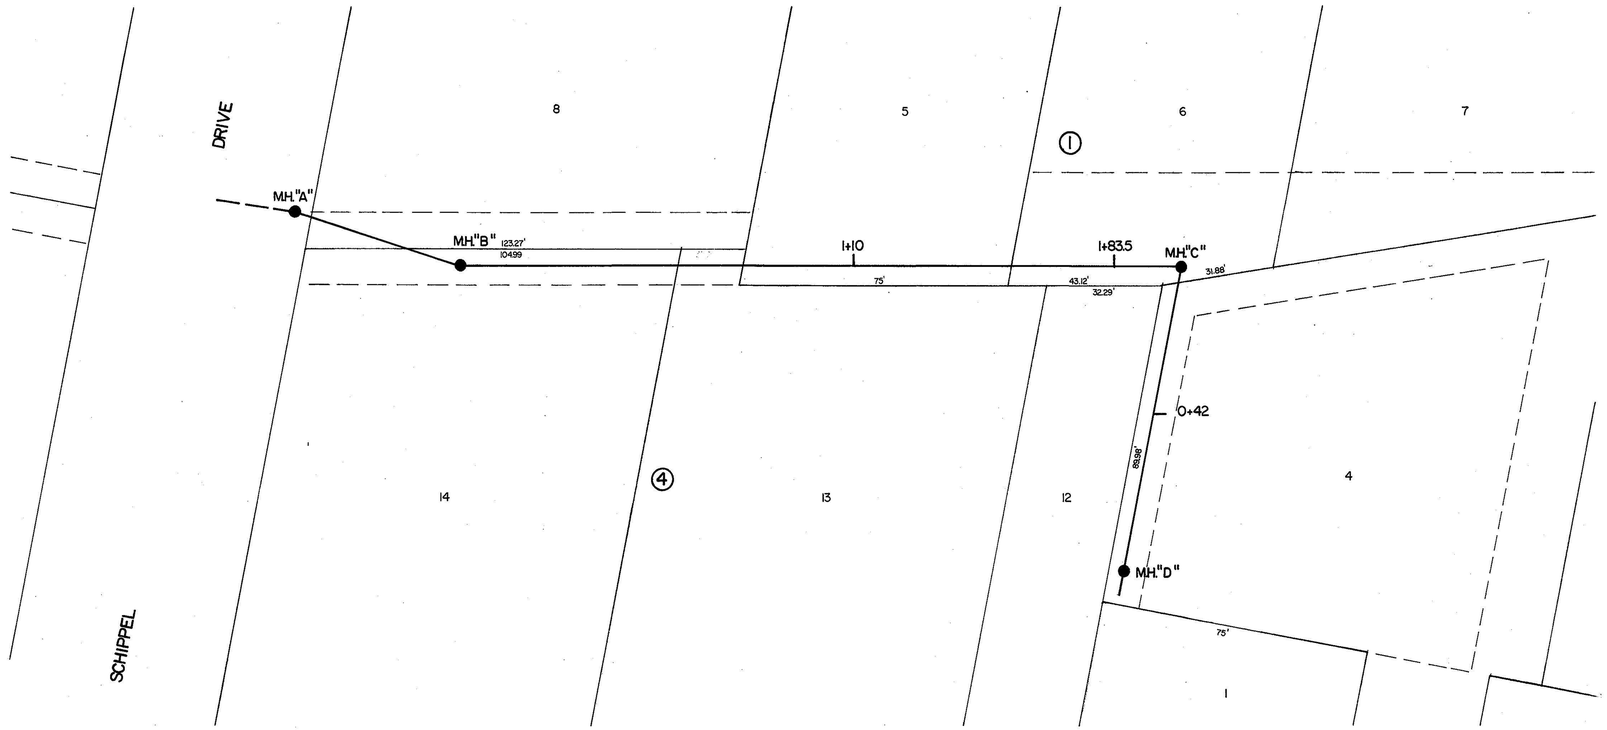

Scale: 1" = 20'
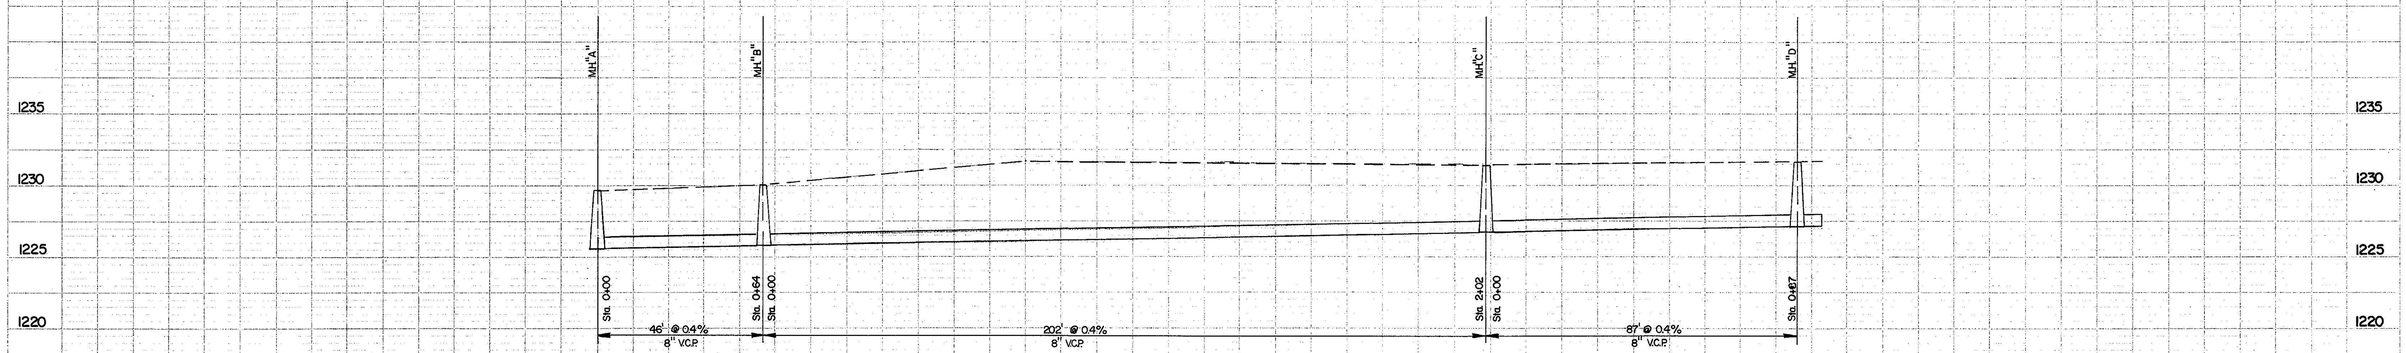
As-Built Plan
Project No. 91-836