562

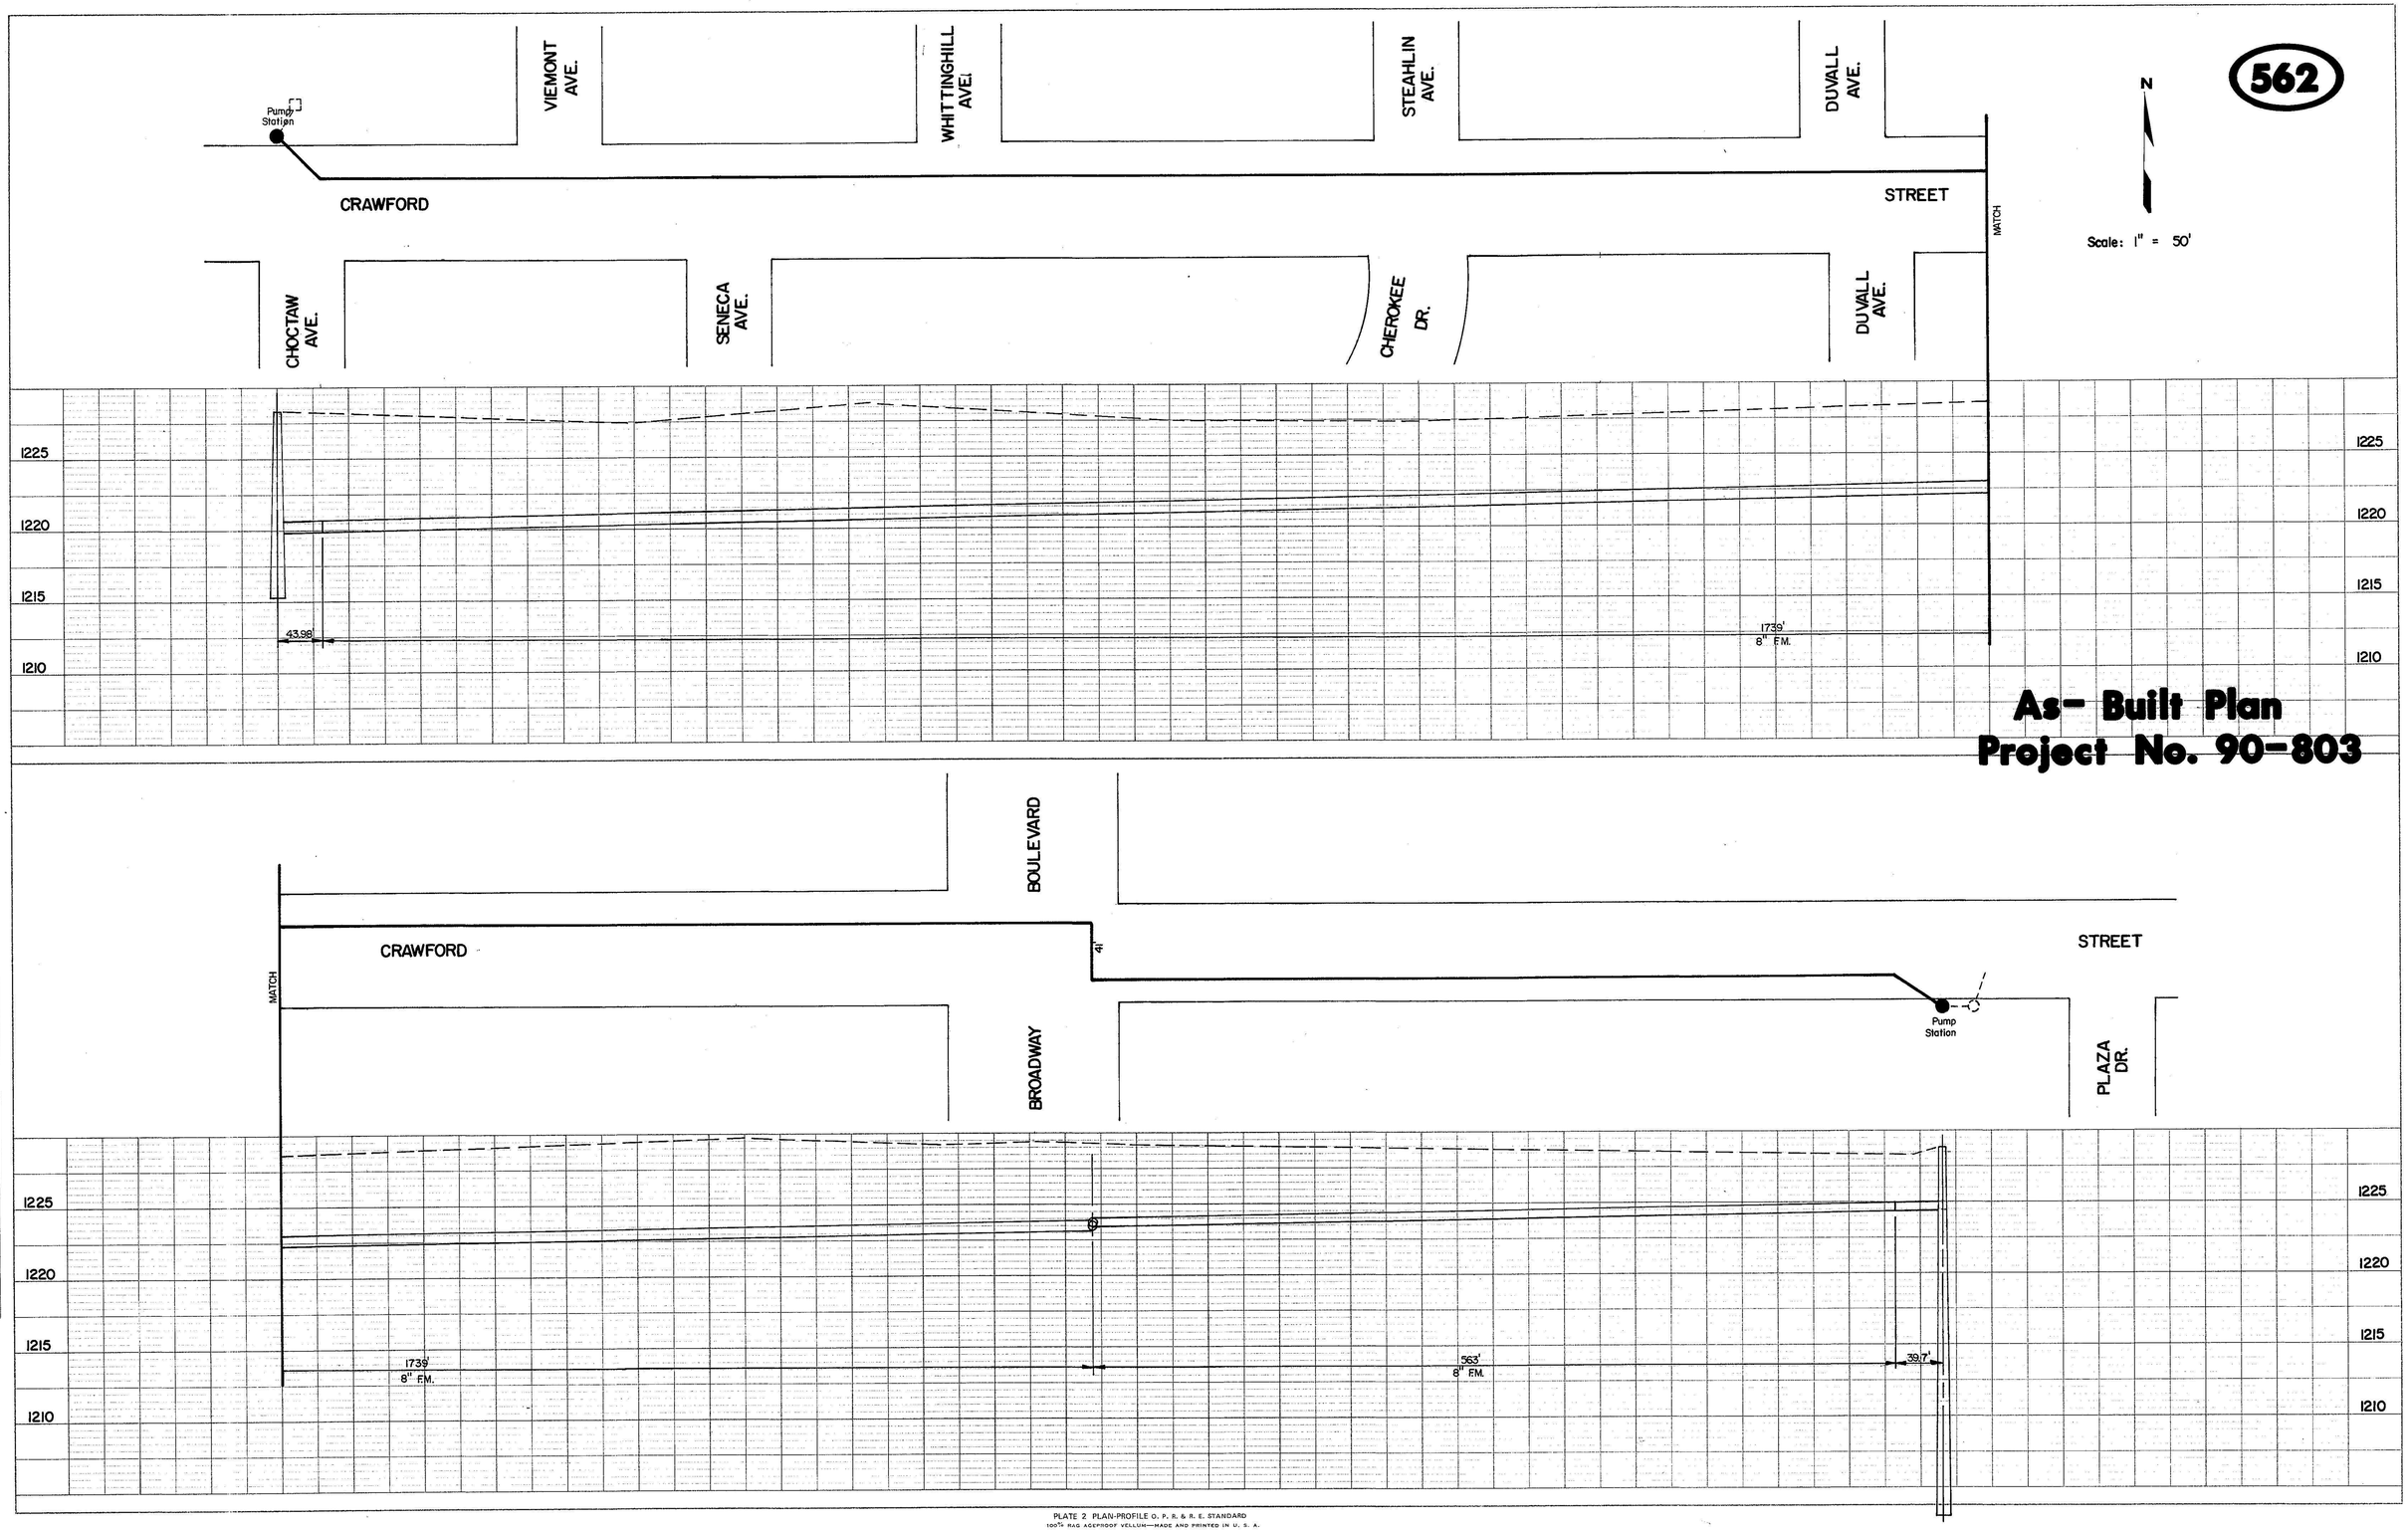

As- Built Plan
Project No. 90-803

PLAN		BY	DATE
NOTE BOOK	SURVEYED		
	PLOTTED		
	ALIGNMENT CHECKED		
NO.	RE. OF WAY PREPARED		

PROFILE		BY	DATE
NOTE BOOK	SURVEYED		
	PLOTTED		
	GRADES CHECKED		
NO.	B. MS. NOTED		
	STRUCTURE NOTATNS CH'KD.		

PLATE 2 PLAN-PROFILE O. P. R. & R. E. STANDARD
100TH RAG AGEPROOF VELLUM—MADE AND PRINTED IN U. S. A.
EUGENE DIETZGEN CO.