563

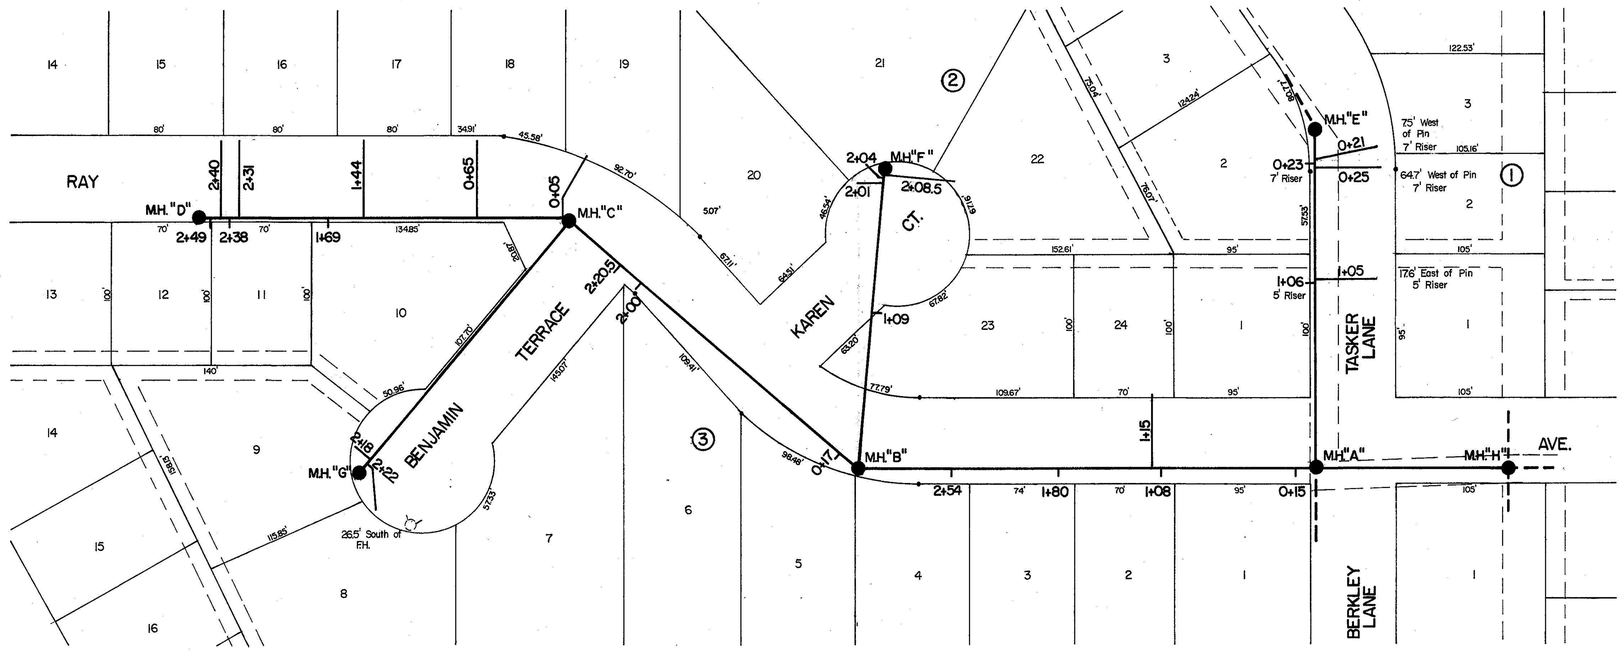
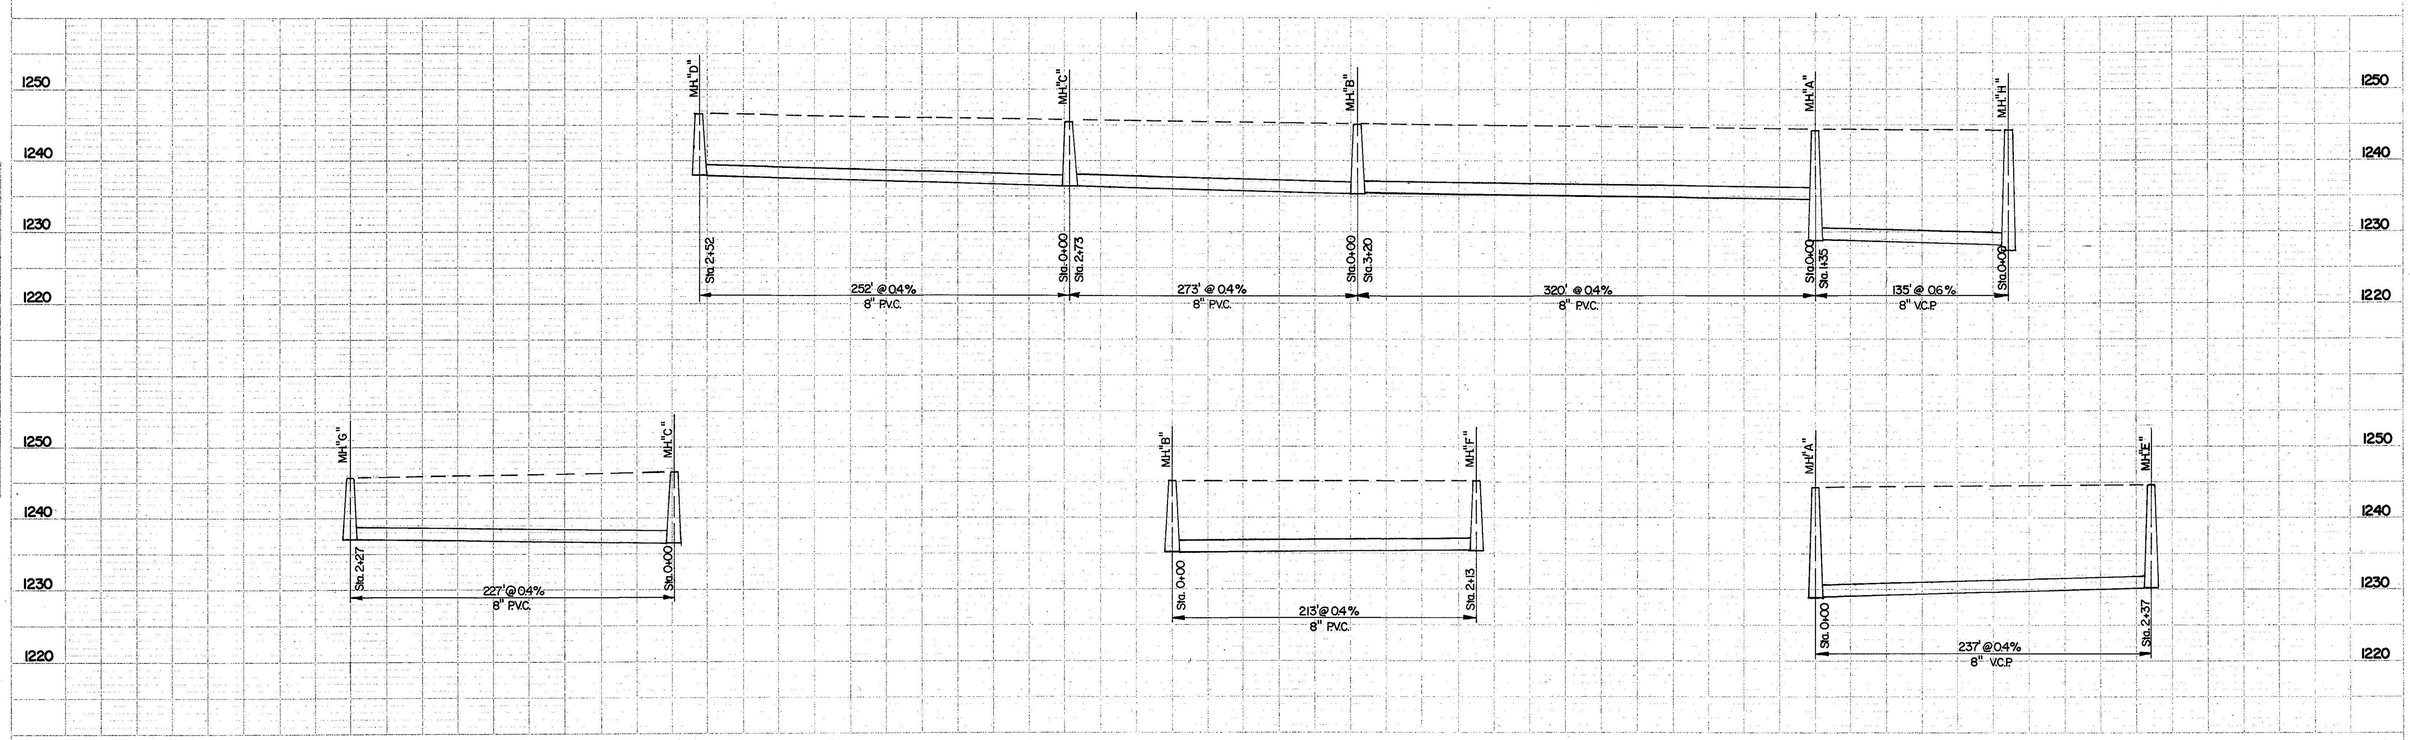
As-Built Plan
Project No. 93-873