564

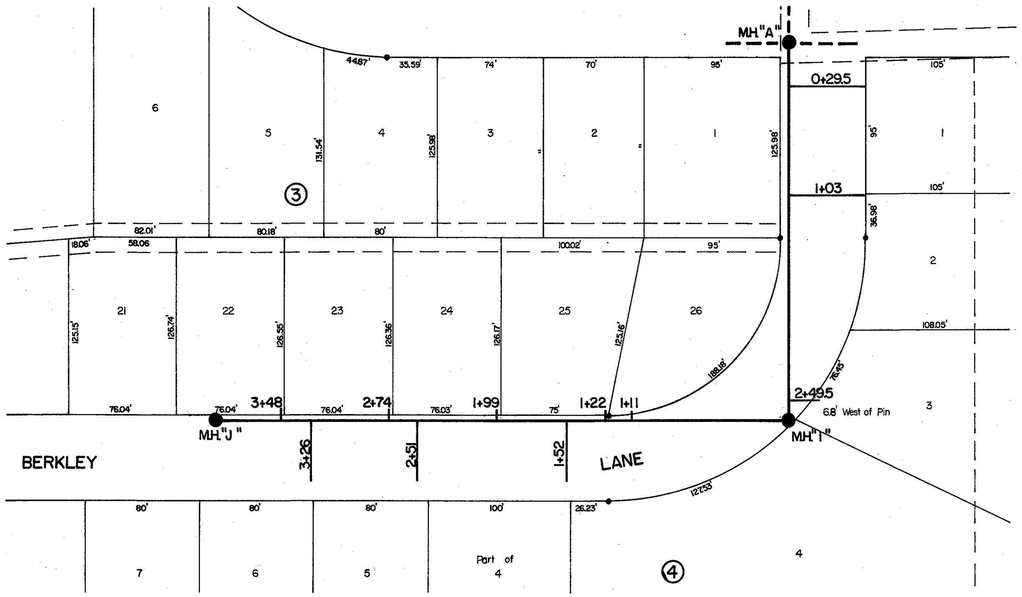

As- Built Plan
Project No. 93-873

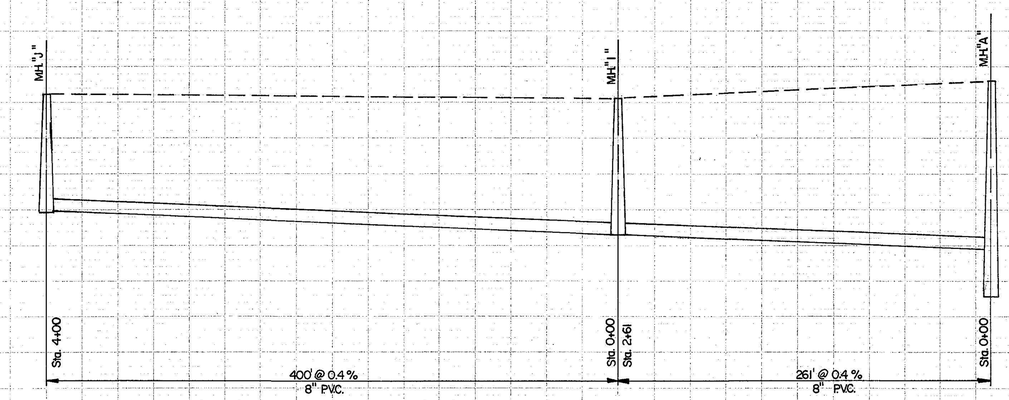

PLATE 1-SINGLE PLAN AND PROFILE-CAULLUME