565

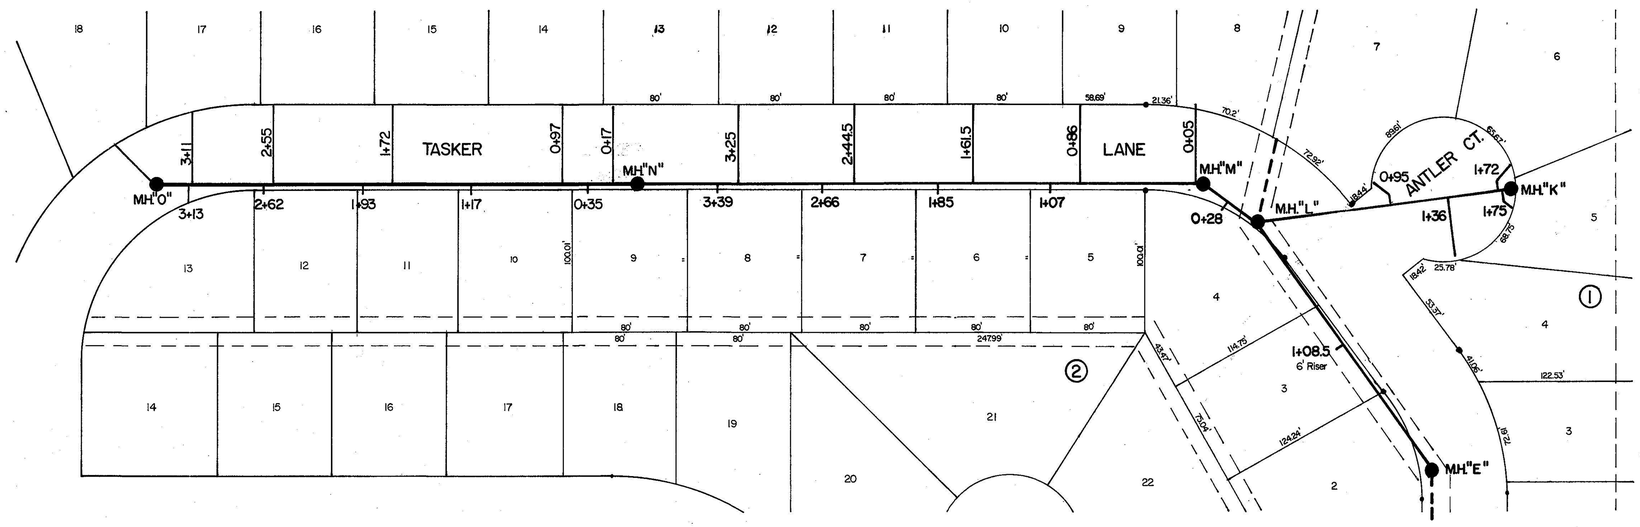

Scale: 1" = 50'

As- Built Plans
Project No. 93-873

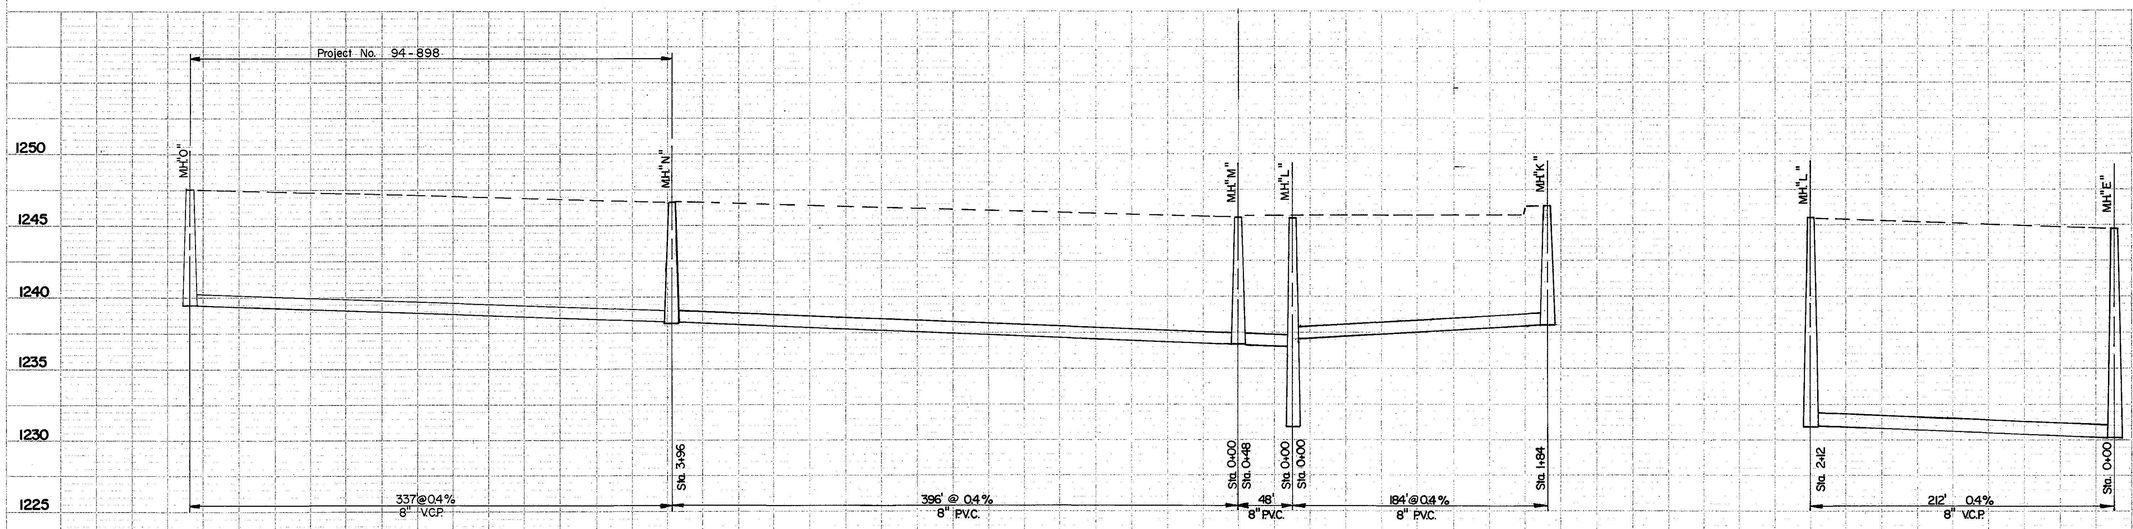

PLAN
SURVEYED
DRAWN
NOTE BOOK
CADD CHECKED
AUGMENT CHECKED
BY OF WAY CHECKED
No.

PROFILE
SURVEYED
DRAWN
NOTE BOOK
CADD CHECKED
S. W.S. NOTED
ELEVATION LOCATIONS CHECKED
No.