566

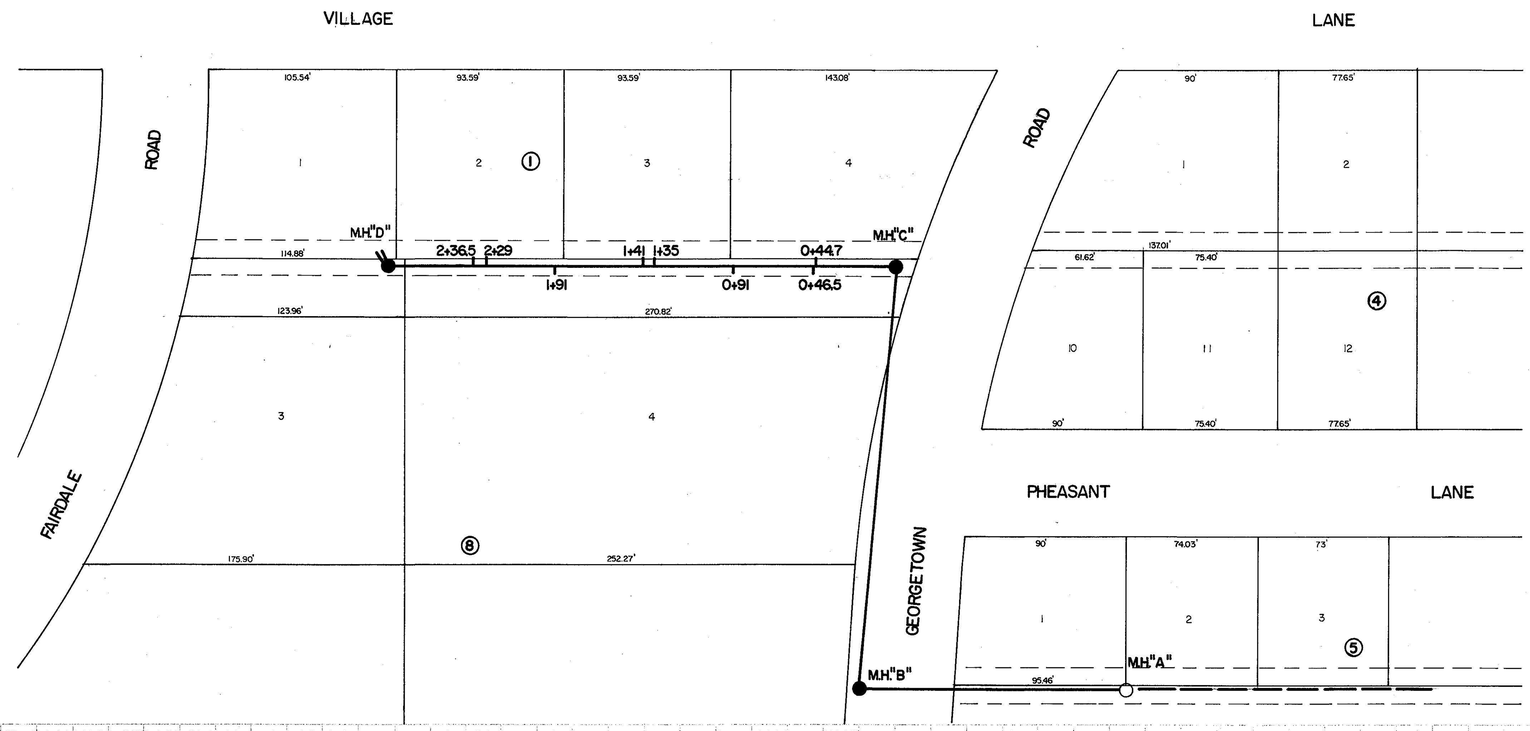

N

Scale: 1" = 40'
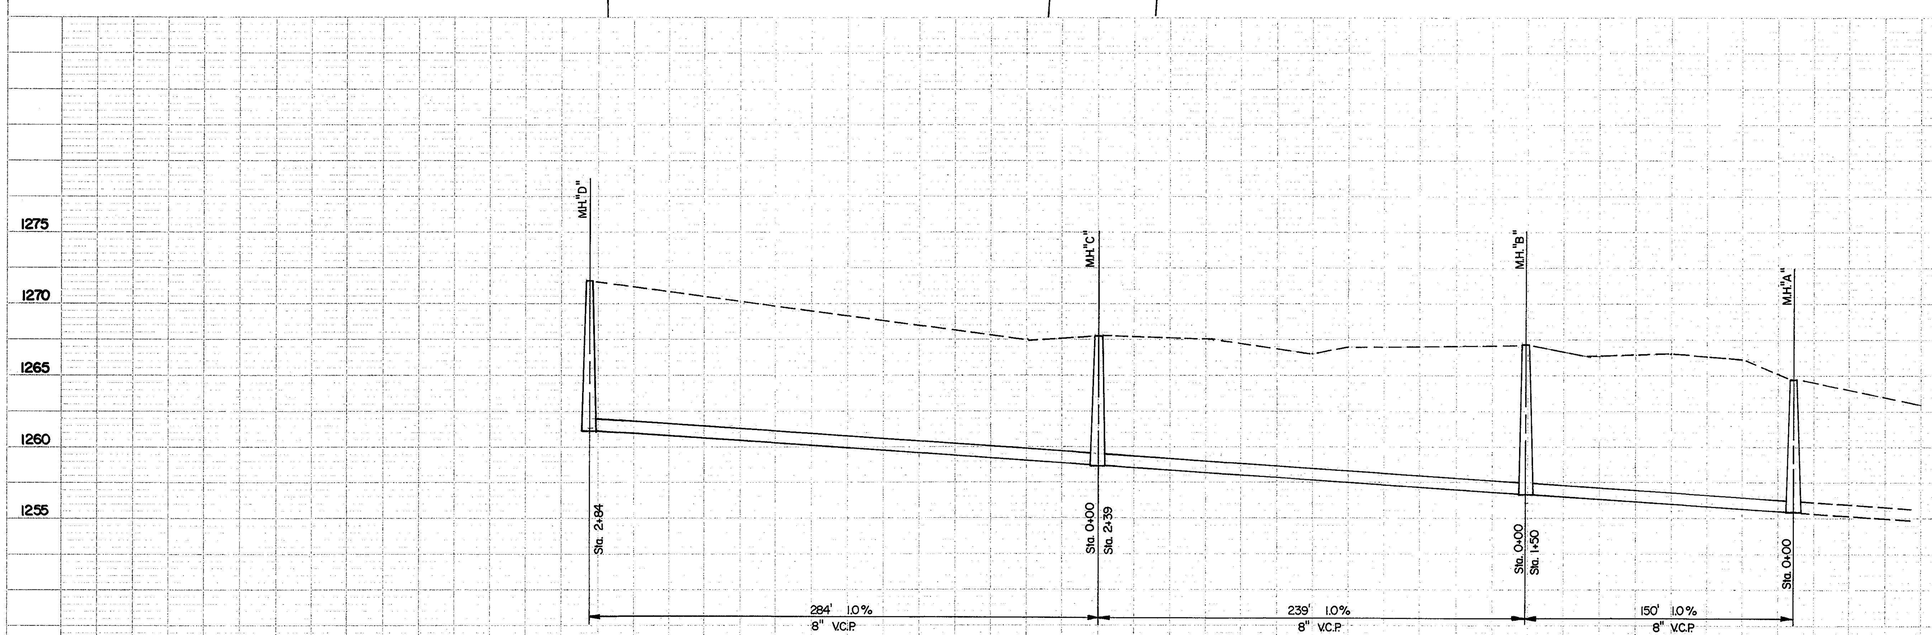
As – Built Plans
Village Place Townhomes Add. (Sewer Ext.)