567

LEGEND

- *MB — Mail Box
- Wood Fence
- Existing Manhole & Sewer
- Proposed Manhole & Sewer
- Structure

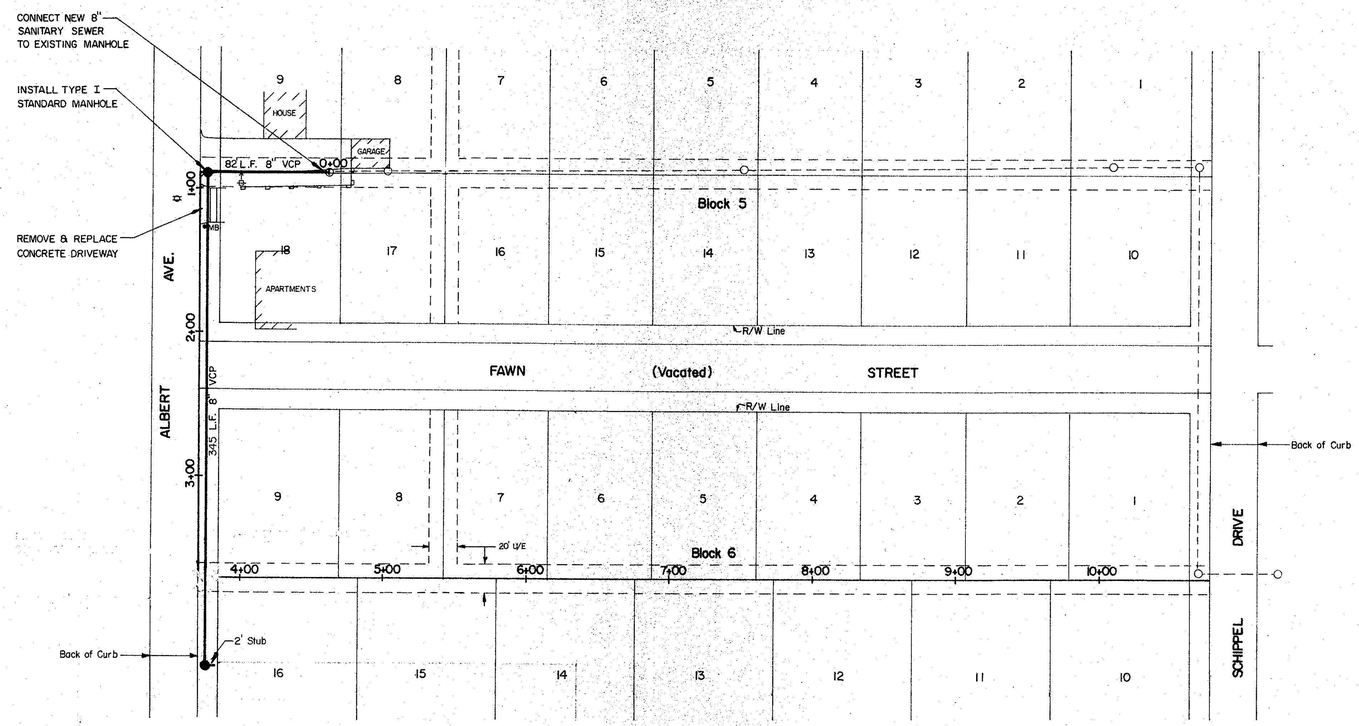

Scale: Hort. 1" = 50'
Vert. 1" = 5'

As- Built Plan
Project No. 93-878

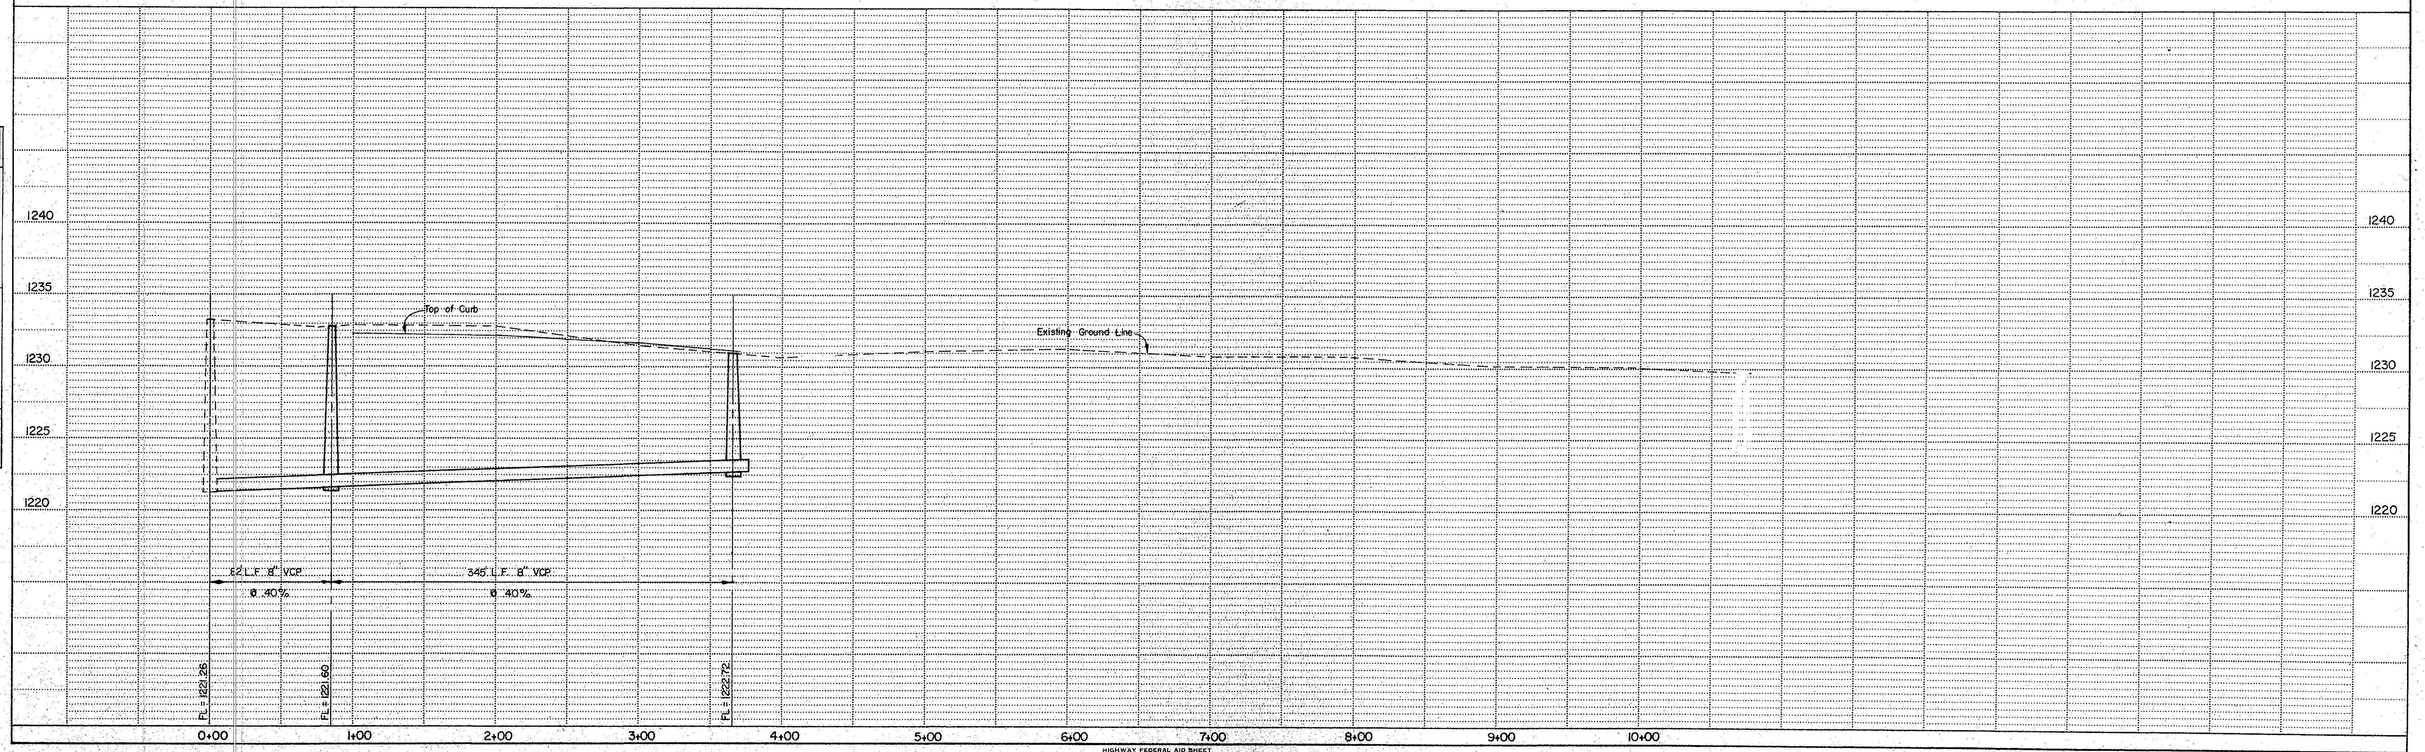

PLAN — SURVEYED, PLOTTED, ALIGNMENT CHECKED, RT. OF WAY CHECKED — NOTE BOOK NO. — BY — DATE

PROFILE — SURVEYED, PLOTTED, GRADES CHECKED, RT. OF WAY CHECKED, STRUCTURE NOTAT'NS CH'KD. — NOTE BOOK NO. — BY — DATE