568

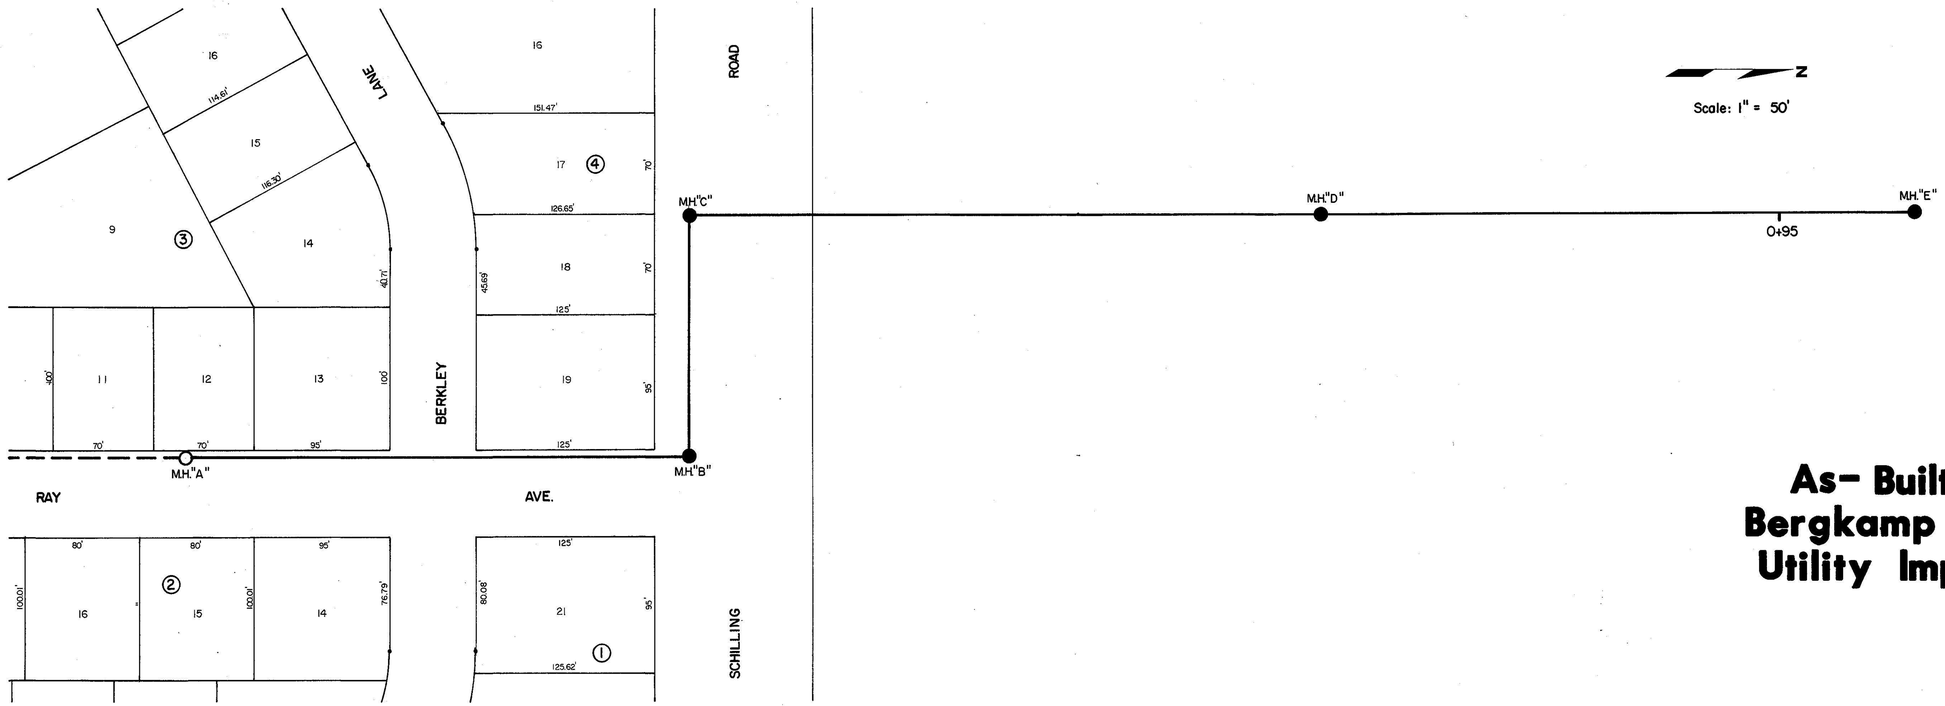
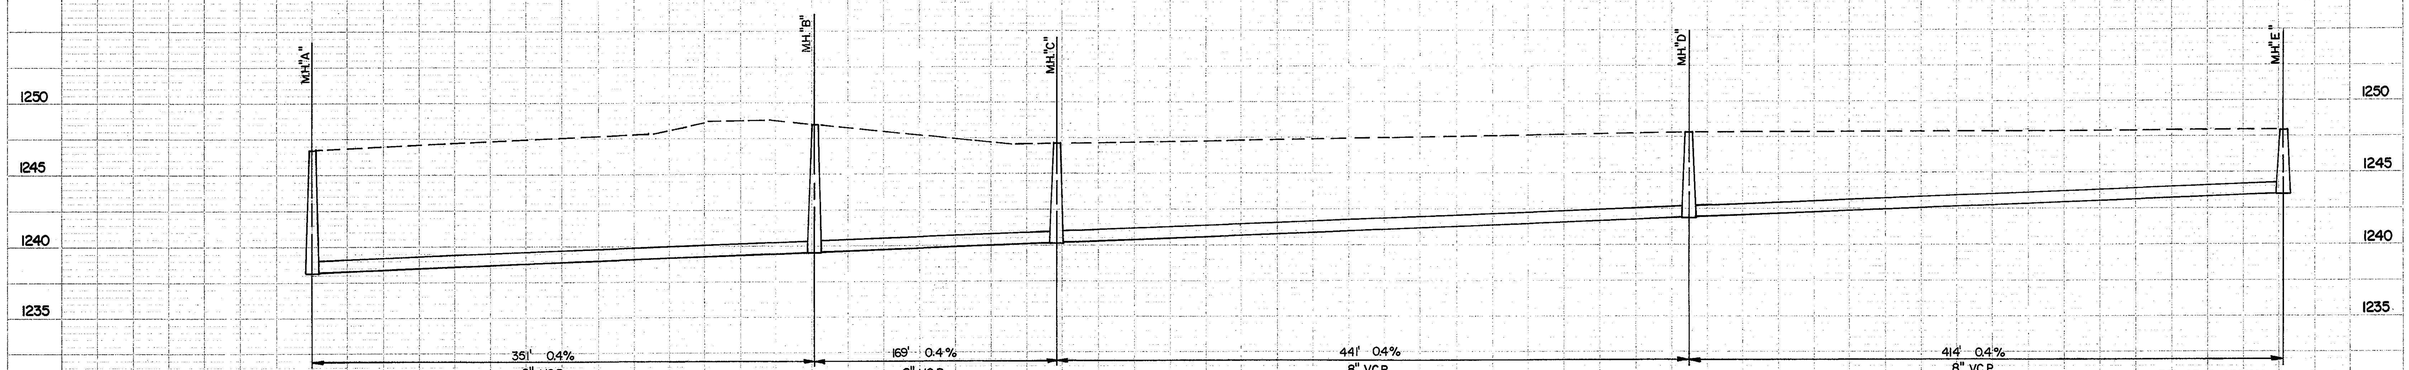
As- Built Plan
Bergkamp Inc. 1993
Utility Improvements