As-Built Plan
Airport Industrial Center
Utility Improvements

569

Scale: 1" = 100'

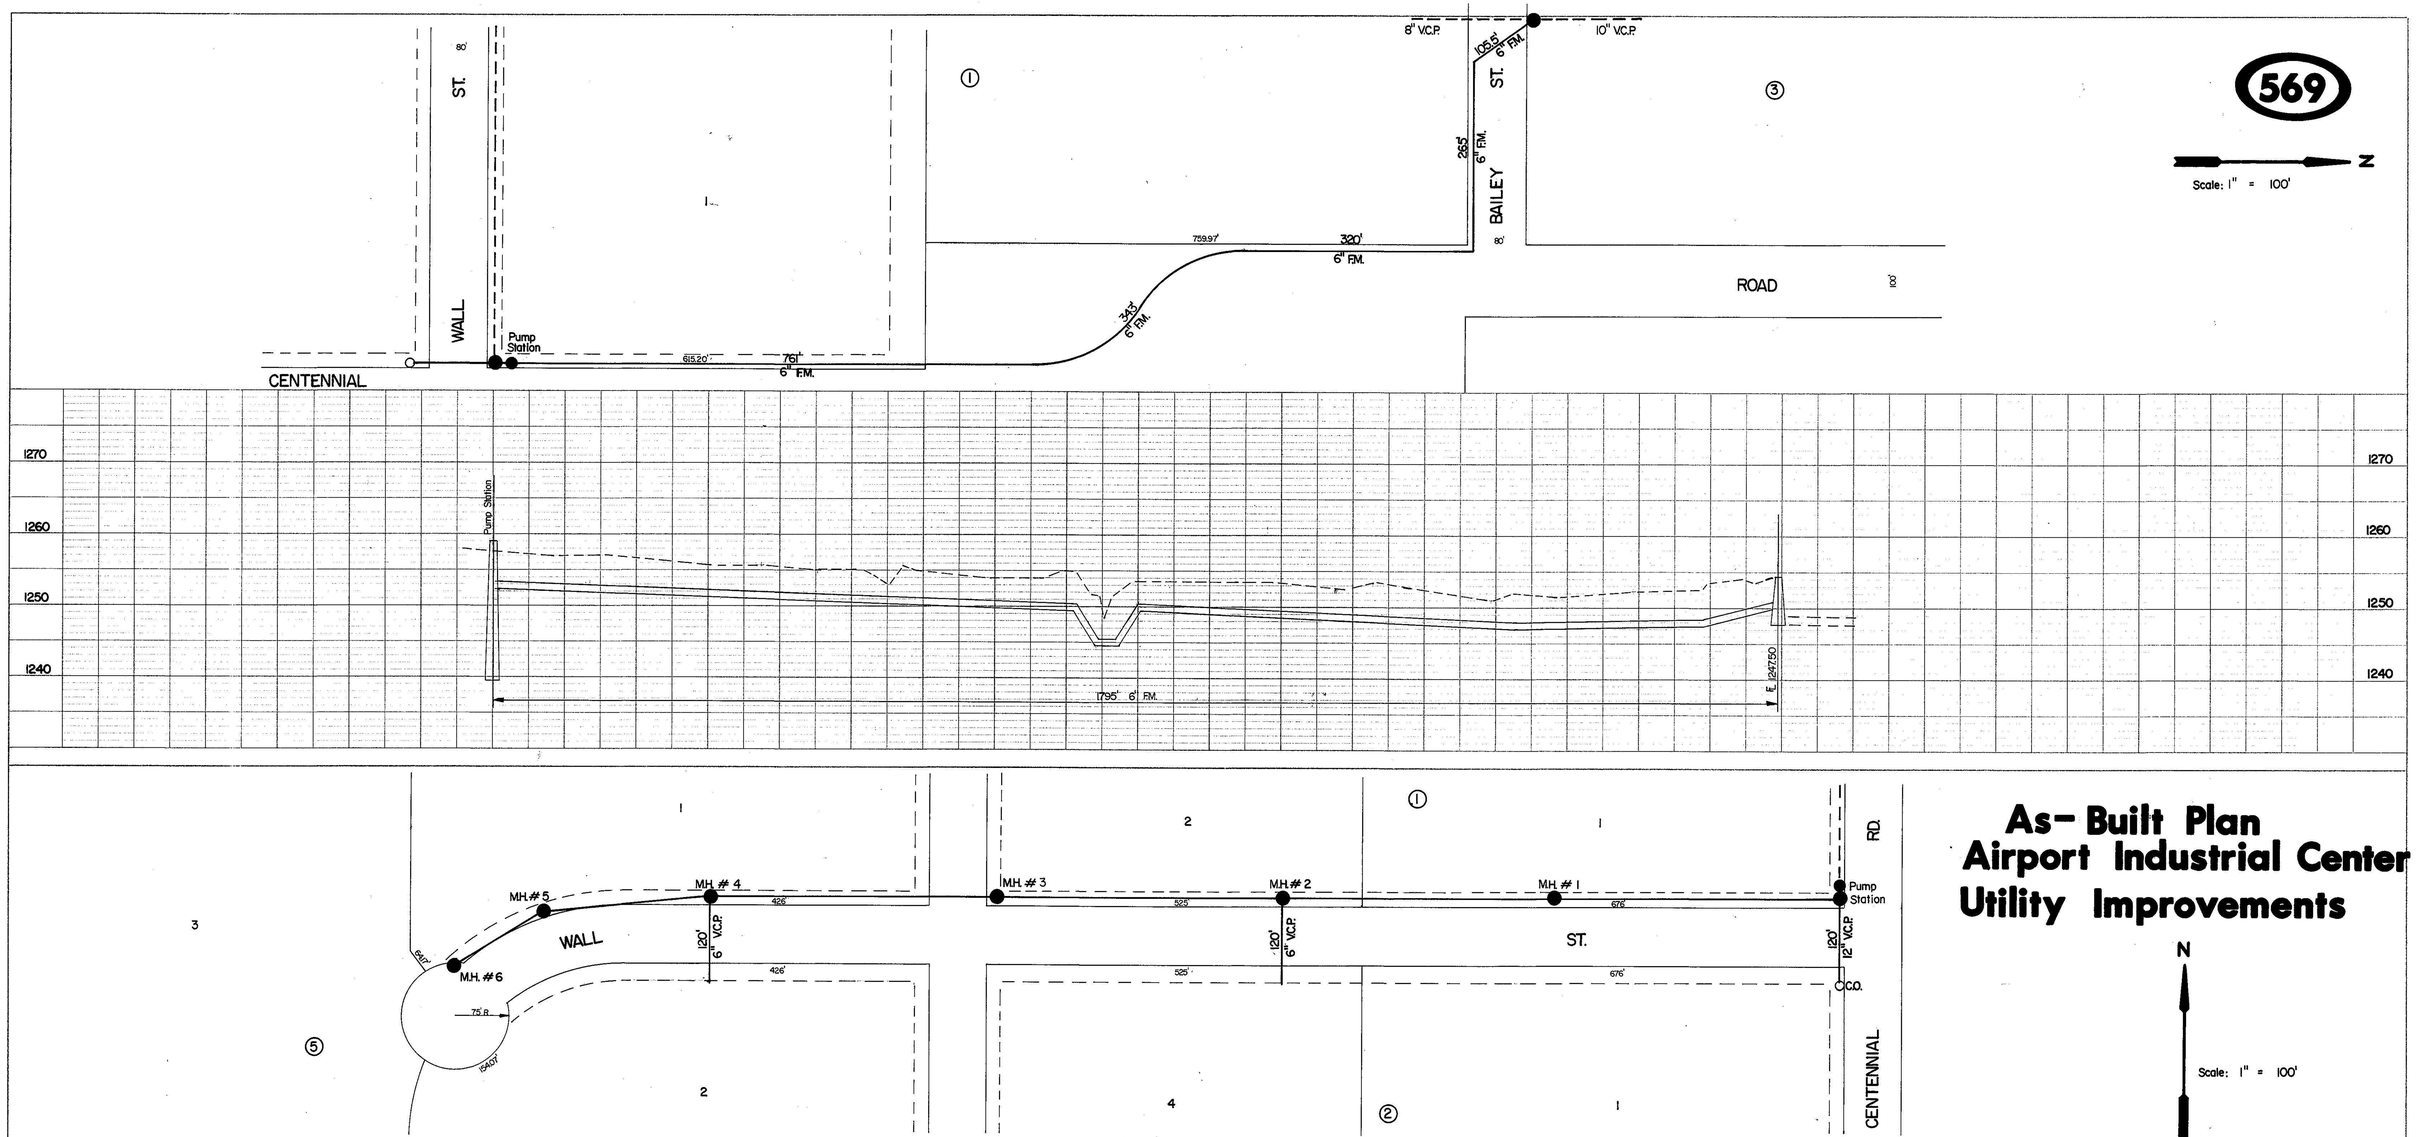

PLAN			BY	DATE
NOTE BOOK	SURVEYED			
	PLOTTED			
	ALIGNMENT CHECKED			
	RT. OF WAY CHECKED			
NO.				

PROFILE			BY	DATE
NOTE BOOK	SURVEYED			
	PLOTTED			
	PROFILE CHECKED			
	B. MS. NOTED			
NO.	STRUCTURE NOTA'NS CH'KD.			

PLATE 2 PLAN-PROFILE O. P. R. & R. E. STANDARD
100% RAG AGEPROOF VELLUM—MADE AND PRINTED IN U. S. A.
EUGENE DIETZGEN CO.