570

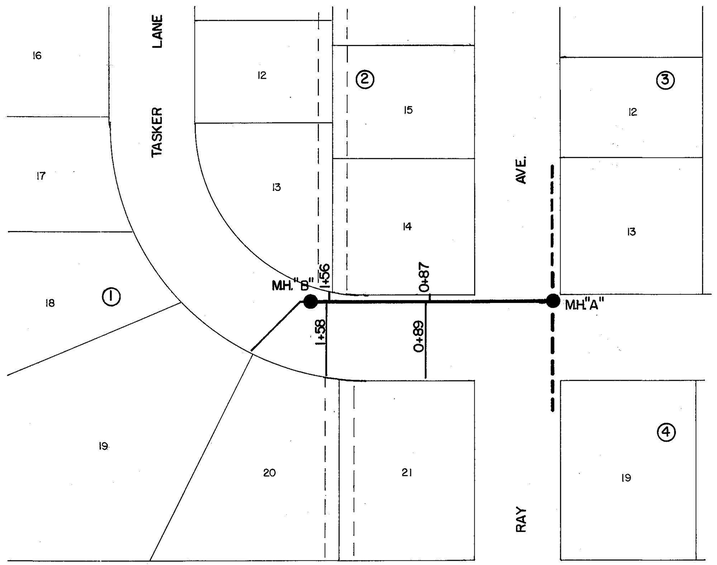

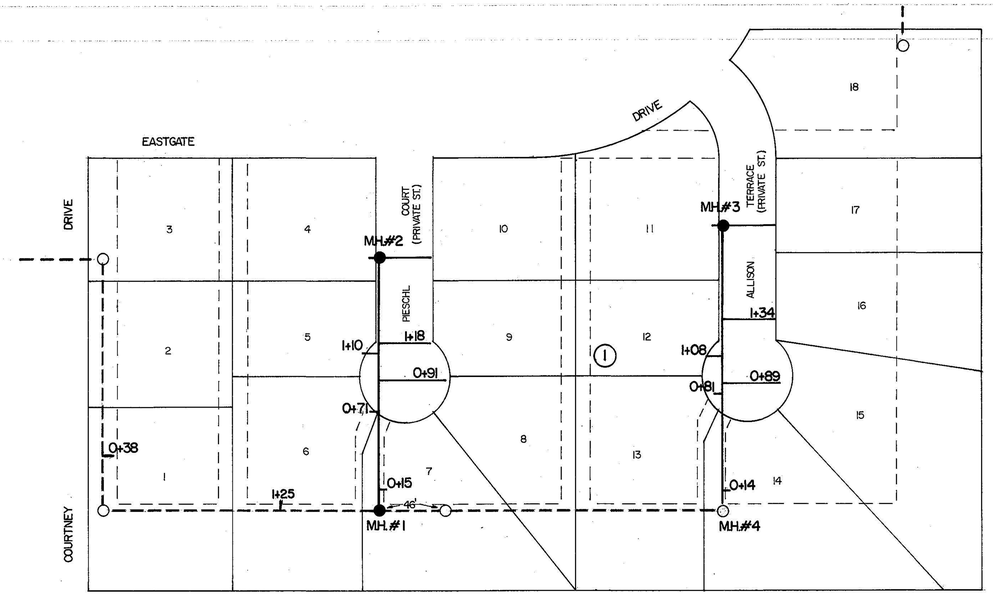

N

Scale: 1" = 50'

As-Built Plans
Replat of Eastgate
Utility Improvements

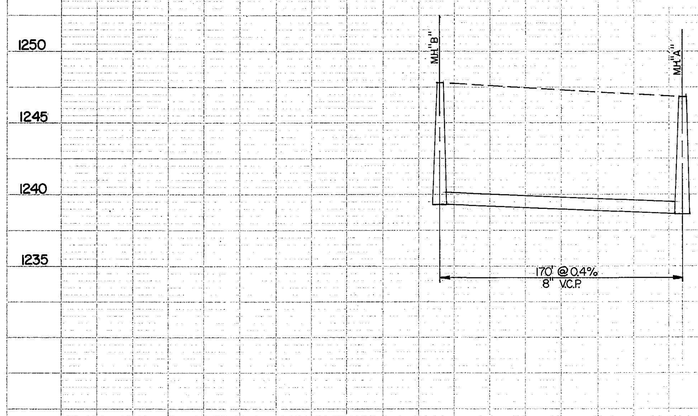

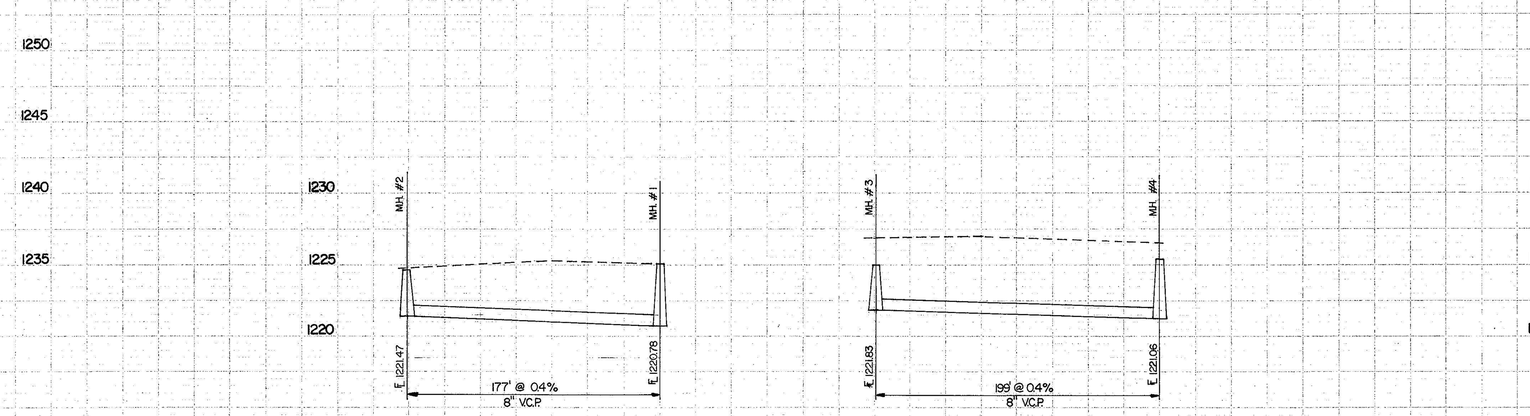

PLANS	SURVEYED		
	PLOTTED		
NOTE BOOK	ALIGNMENT CHECKED		
No.	RT. OF WAY CHECKED		
	STRUCTURE LOCATIONS CHECKED		

PROFILE	SURVEYED		
	PLOTTED		
NOTE BOOK	GRADES CHECKED		
	CLEARANCES CHECKED		
No.	STRUCTURE LOCATIONS CHECKED		