571

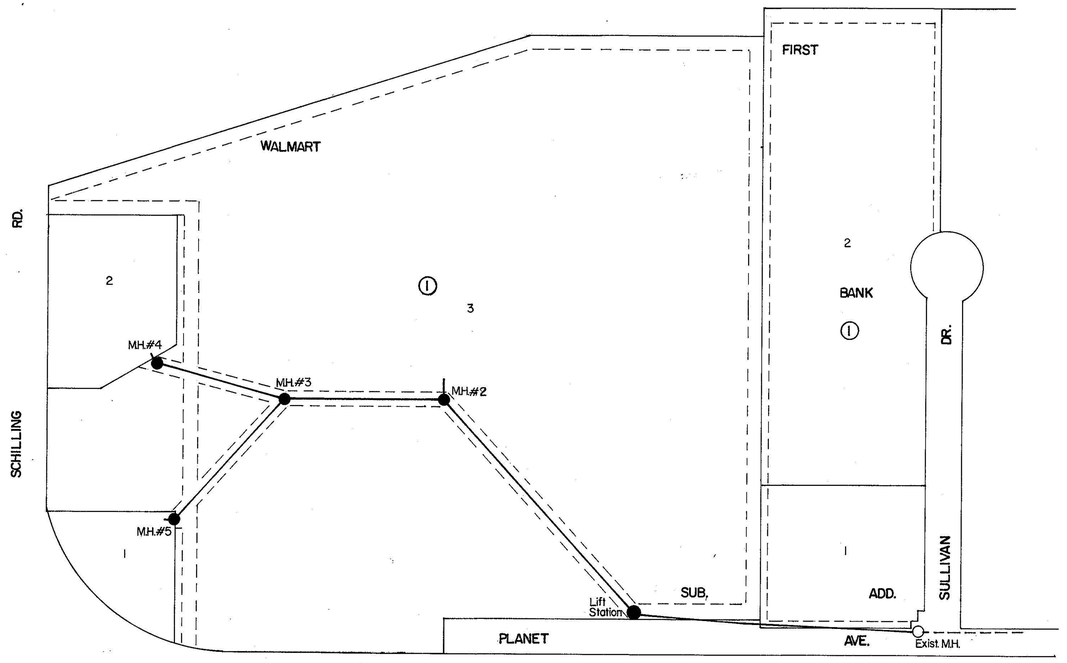

Scale: 1" = 100'
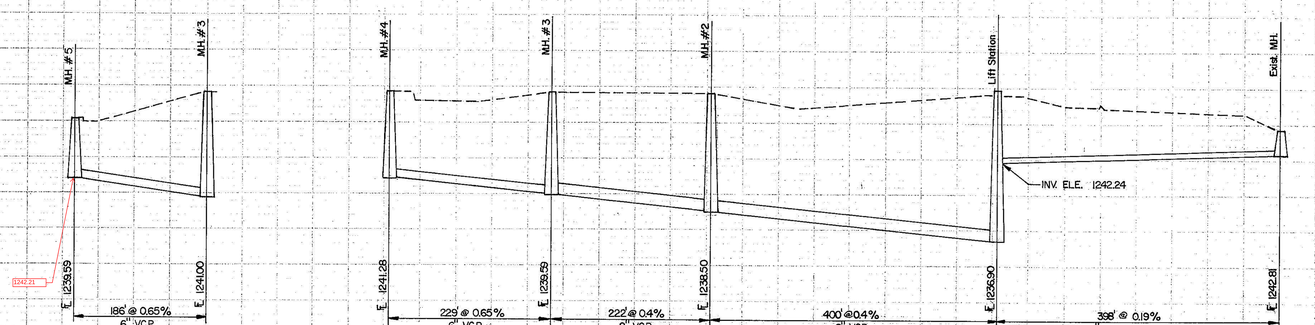
As-Built Plan
Walmart Site
Utility Improvements