572

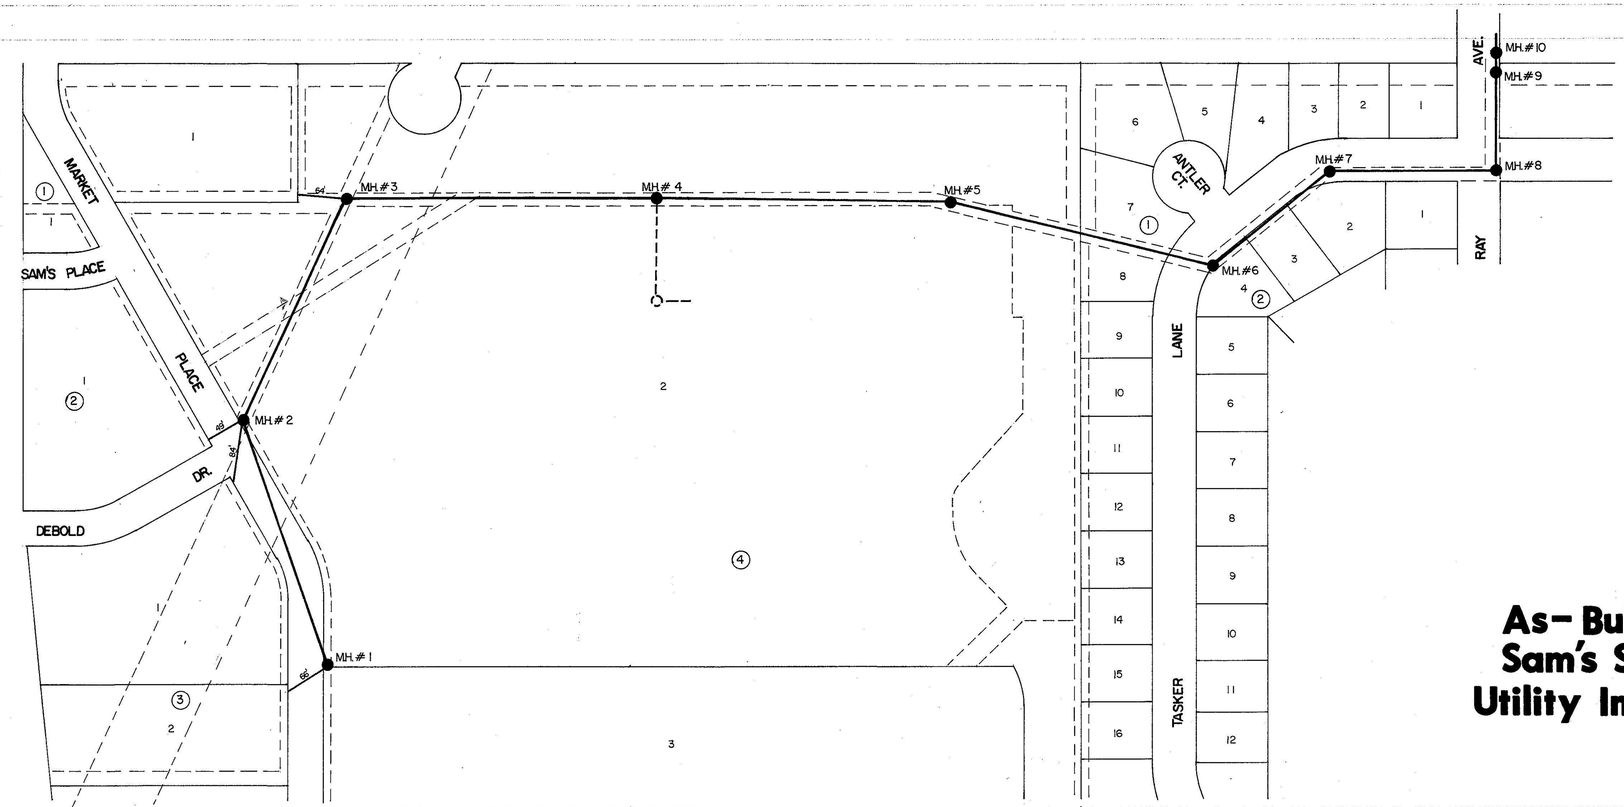
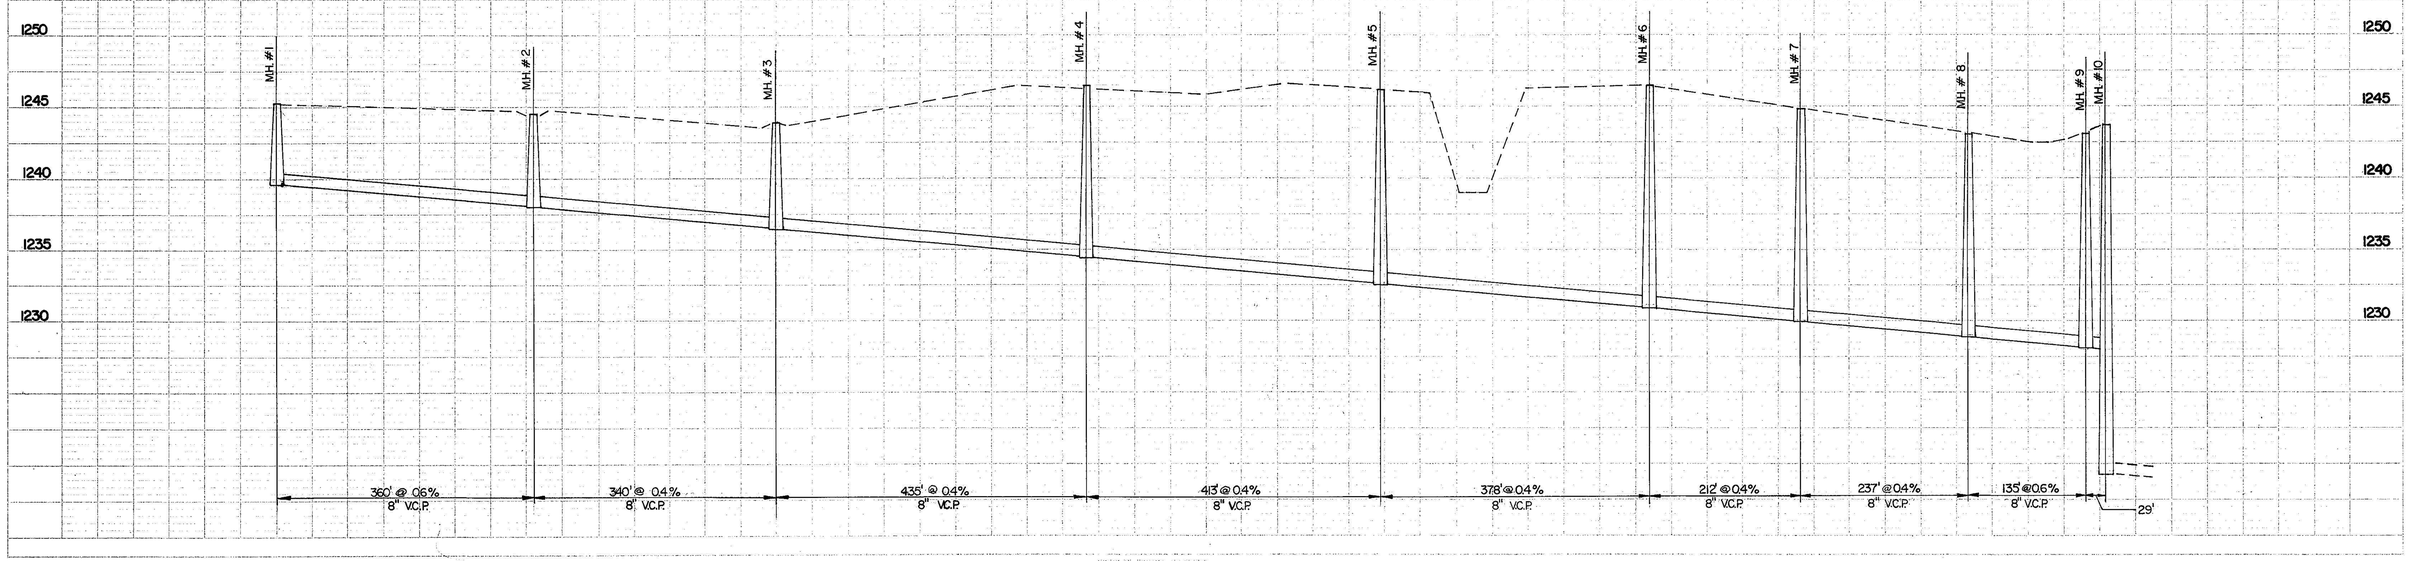
As-Built Plans
Sam's Site Plans
Utility Improvements