573

Scale: 1" = 100'
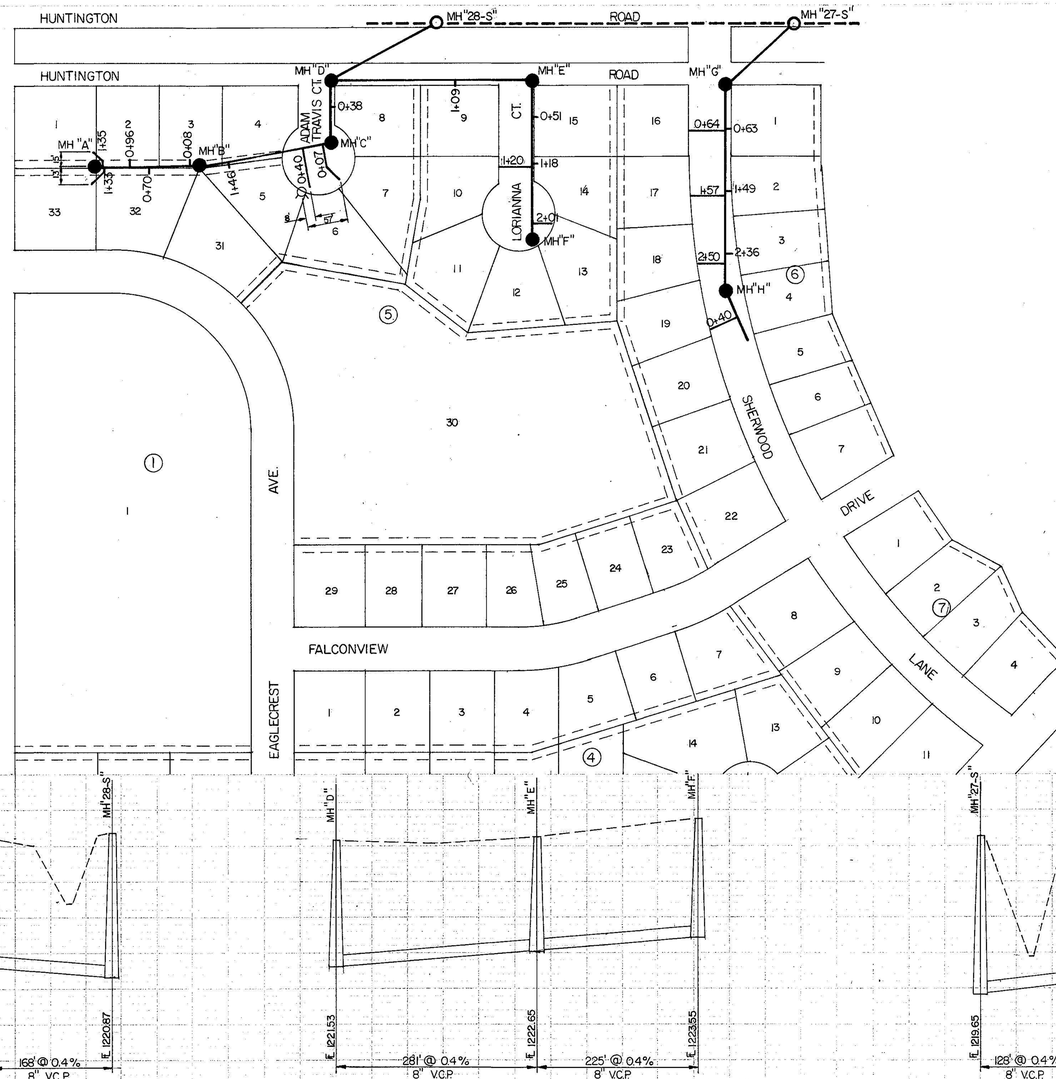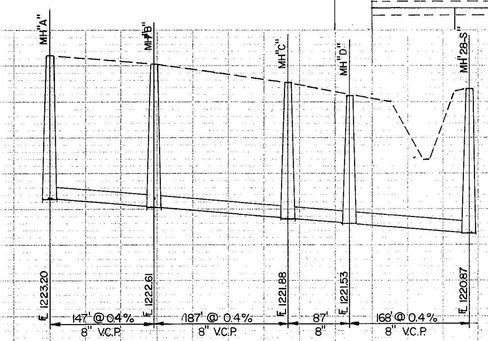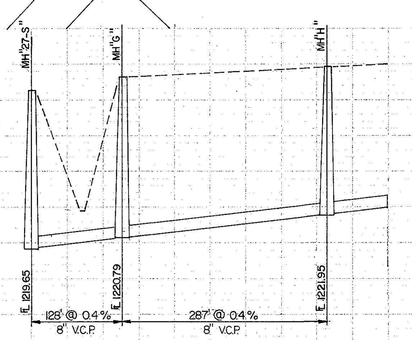
As- Built Plans
Project No. 94-892