574

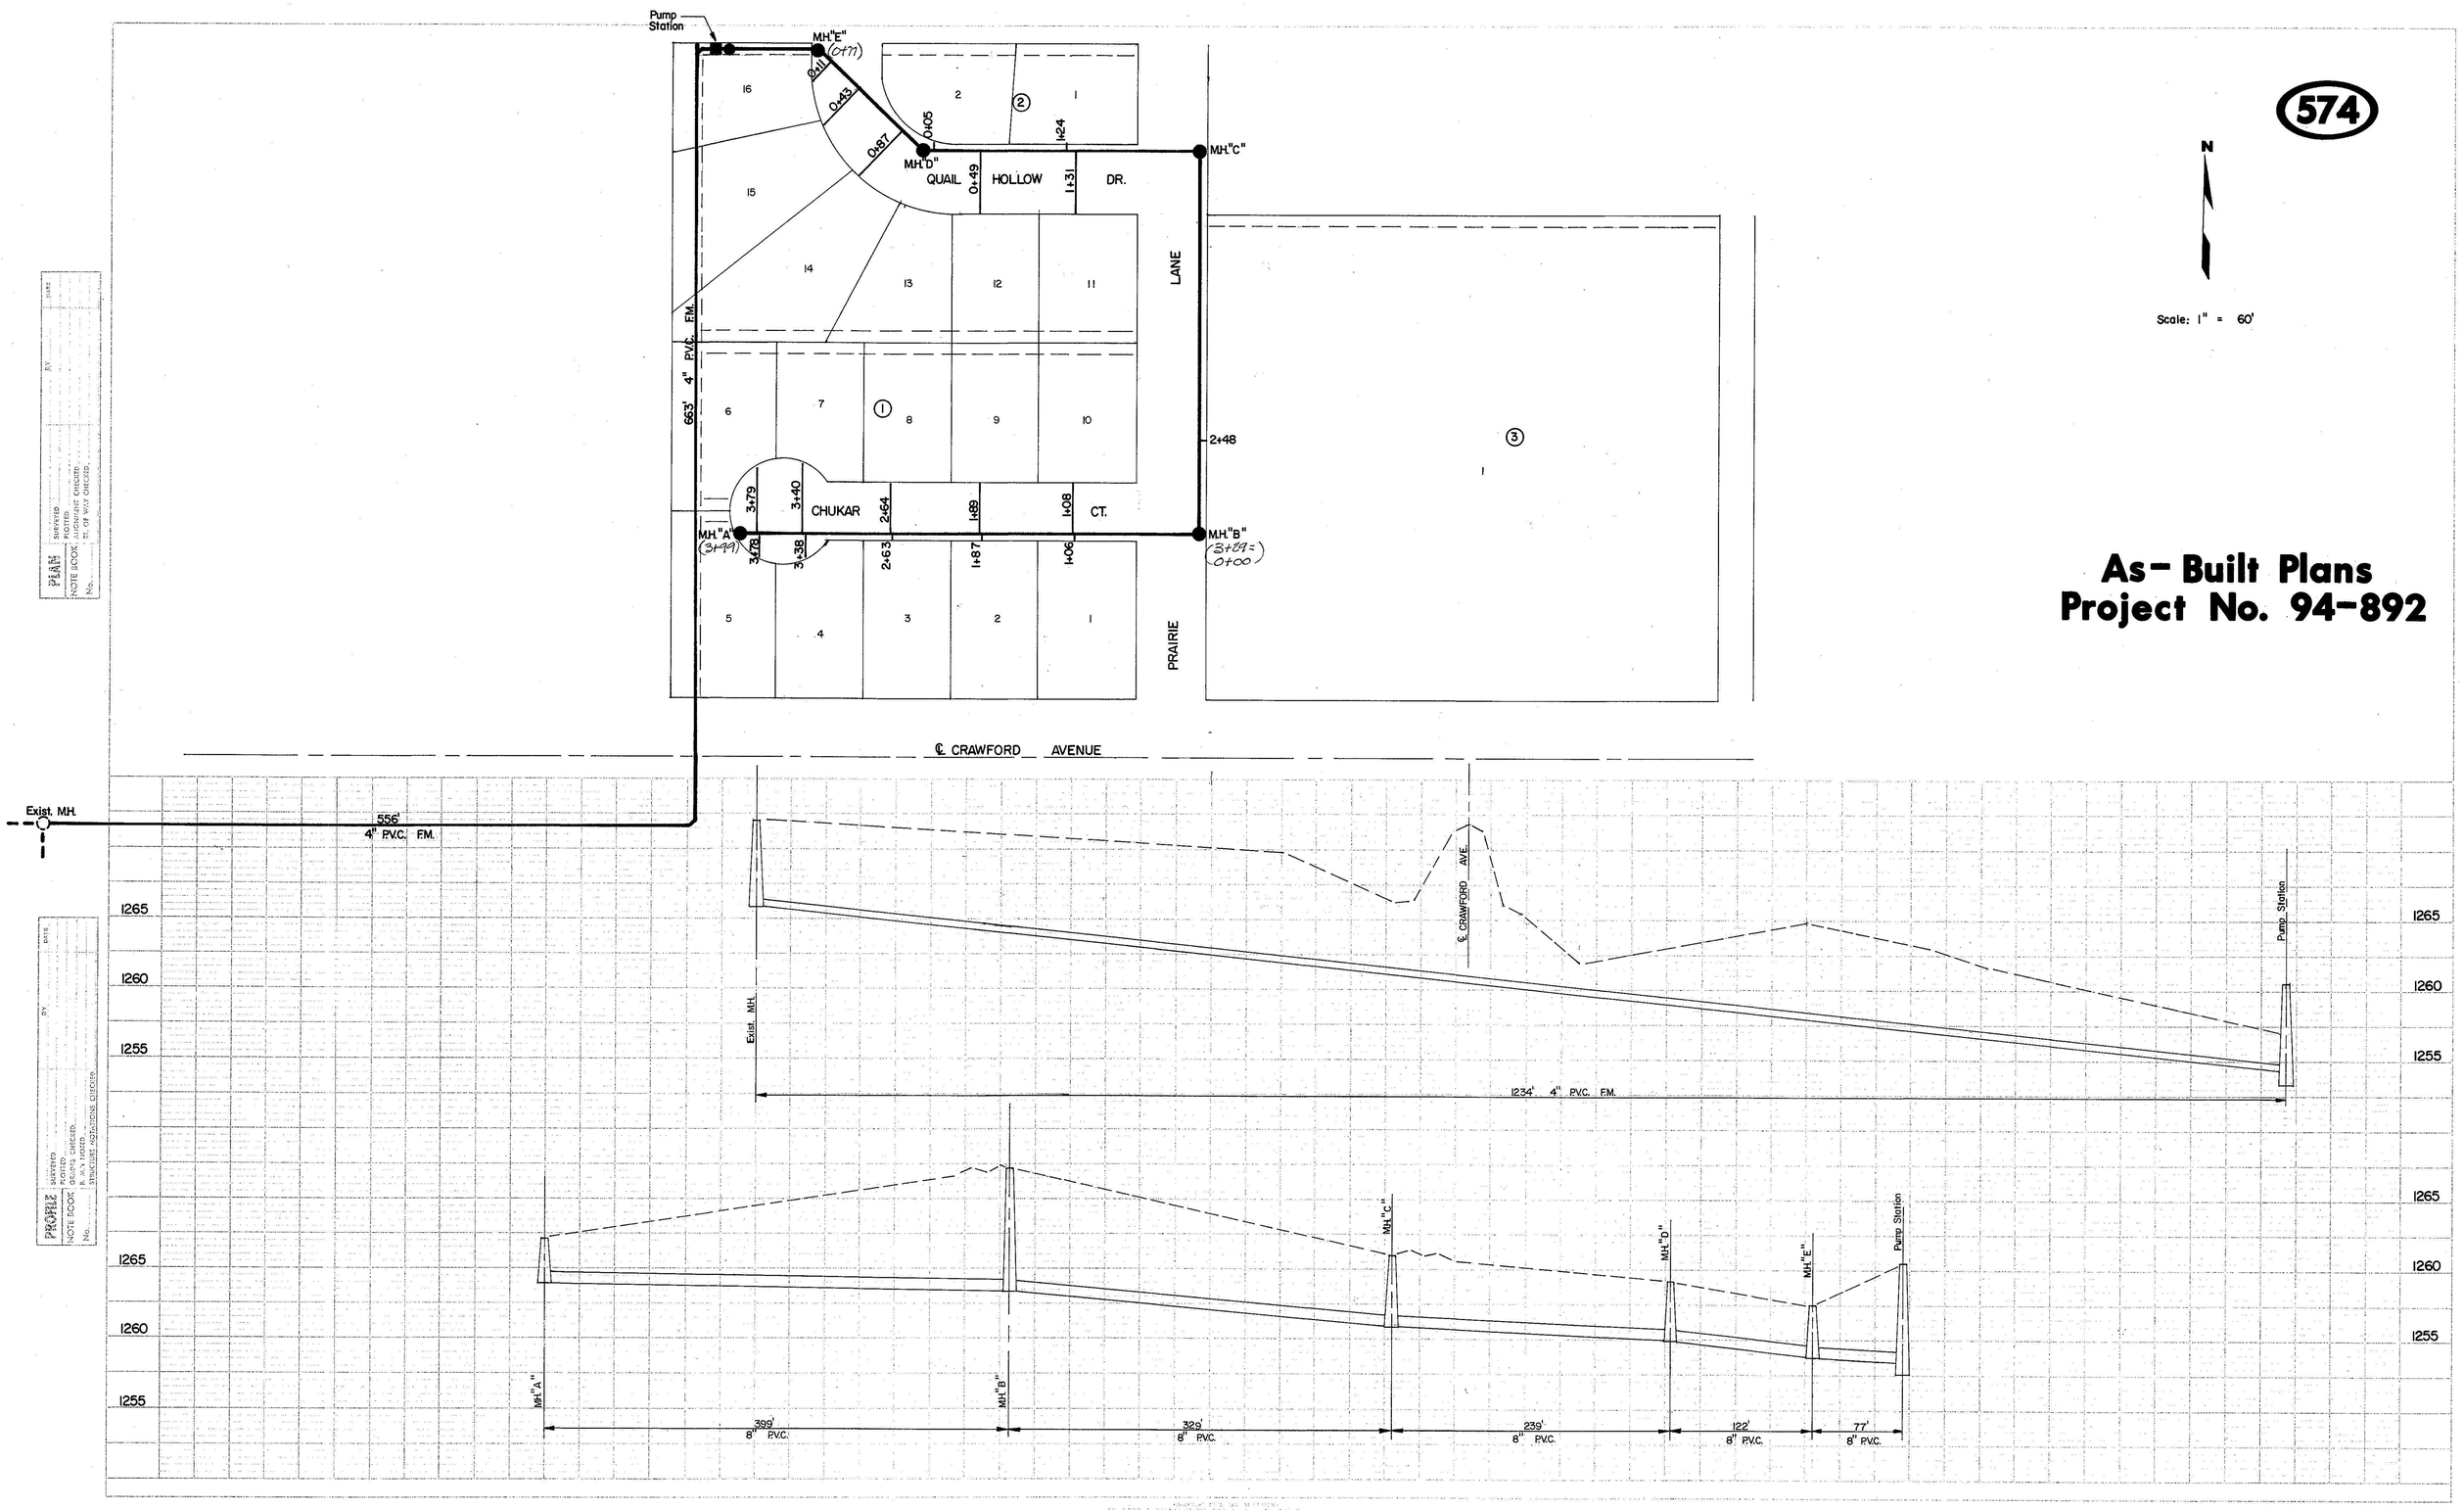

As-Built Plans
Project No. 94-892

PLAN SURVEYED
PLAN PLOTTED
NOTE BOOK ALIGNMENT CHECKED
No. PL. OF W.O.P. CHECKED
BY DATE

PROFILE SURVEYED
PROFILE PLOTTED
NOTE BOOK VERT. CURVES CHECKED
No. PLAN PLOTTED
STRUCTURE NOTATIONS CHECKED
BY DATE