575

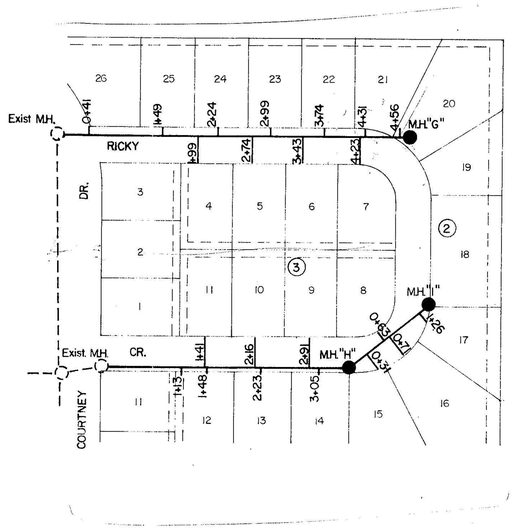

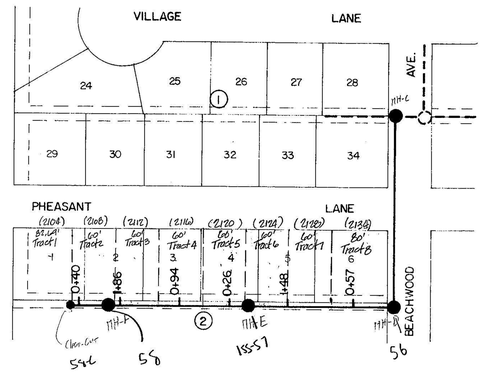

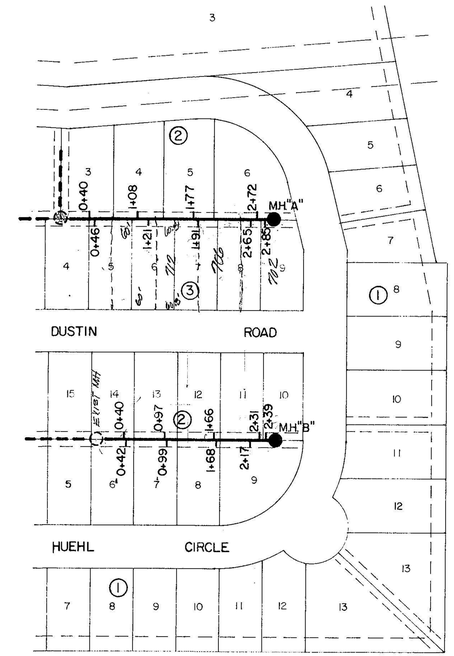

Scale: 1" = 100'

As-Built Plans
Project No. 94-892

PLAN		
NOTE BOOK	SURVEYED	BY
	PLOTTED	DATE
	GRADES CHECKED	
	ALIGNMENT CHECKED	
	RT. OF WAY CHECKED	
No.		

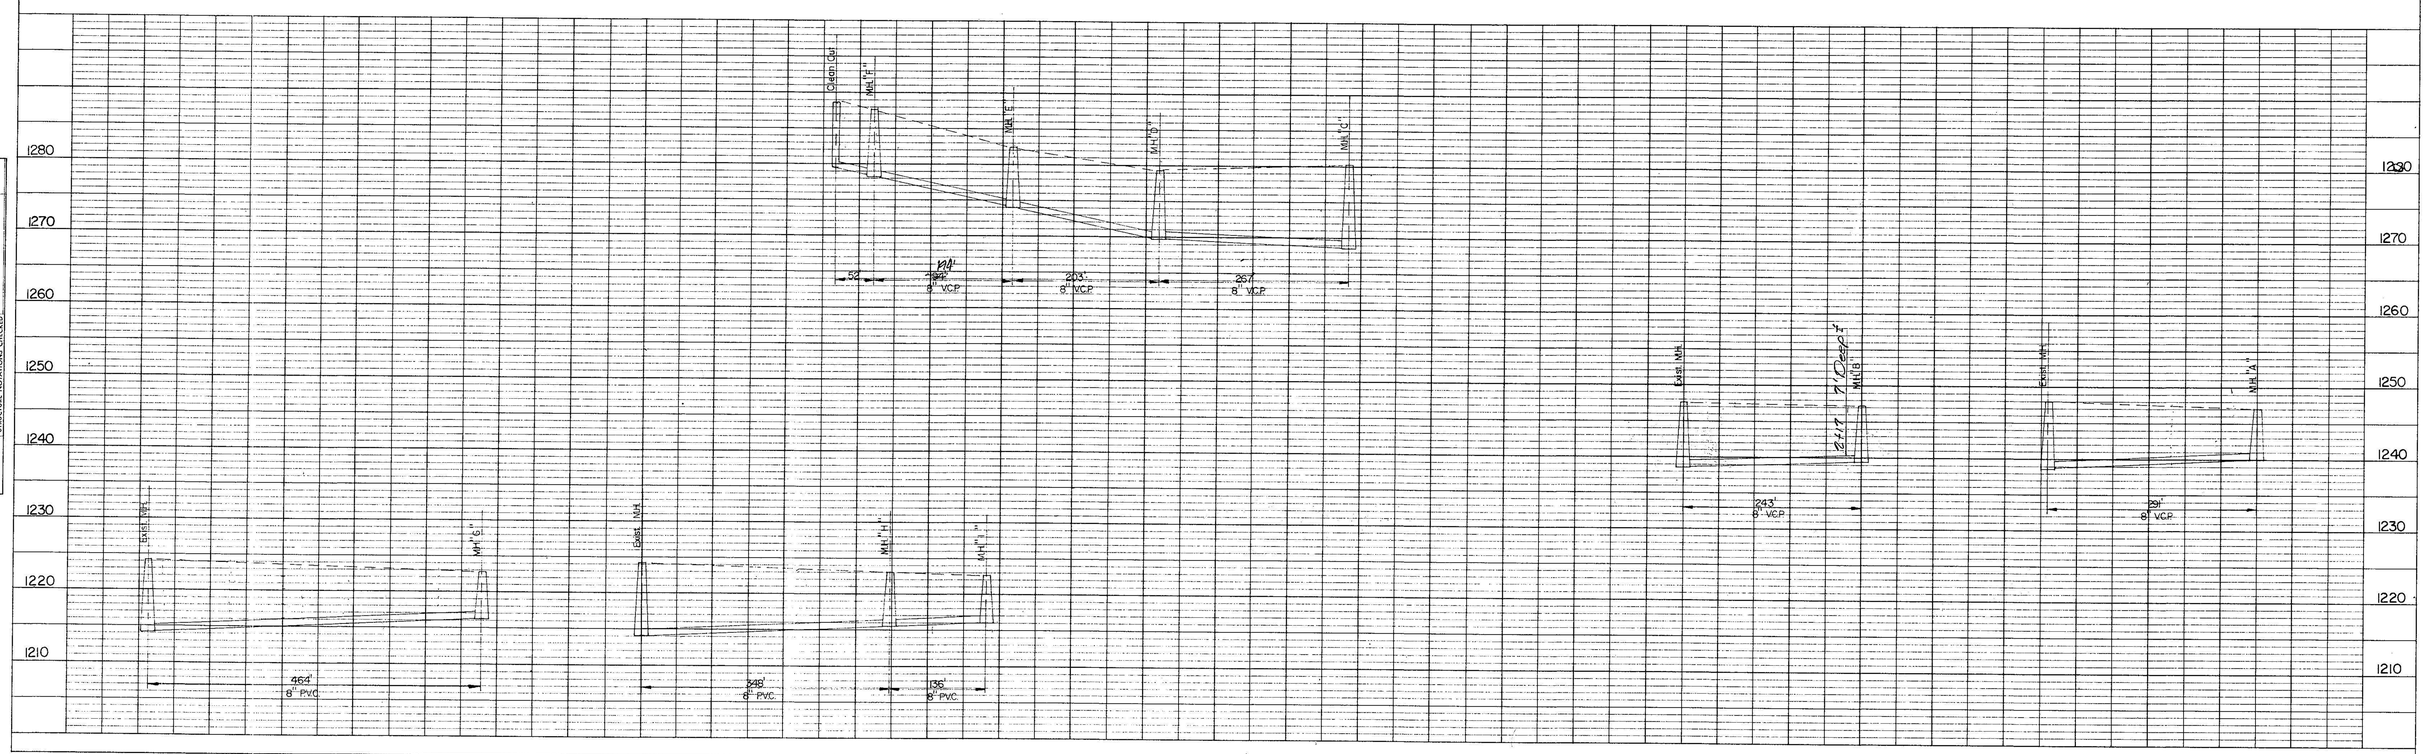

PROFILE		
NOTE BOOK	SURVEYED	BY
	PLOTTED	DATE
	GRADES CHECKED	
	ALIGNMENT CHECKED	
No.	STRUCTURE NOTATIONS CHECKED	