576

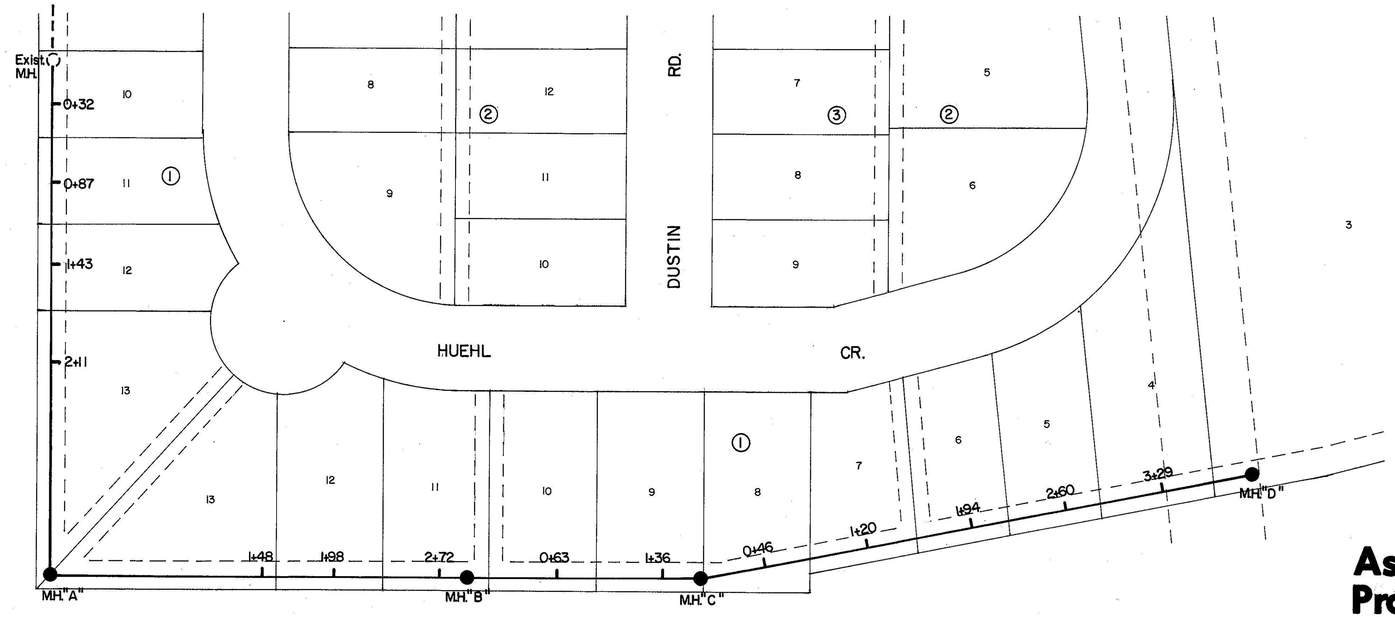

As - Built Plans
Project No. 94-898

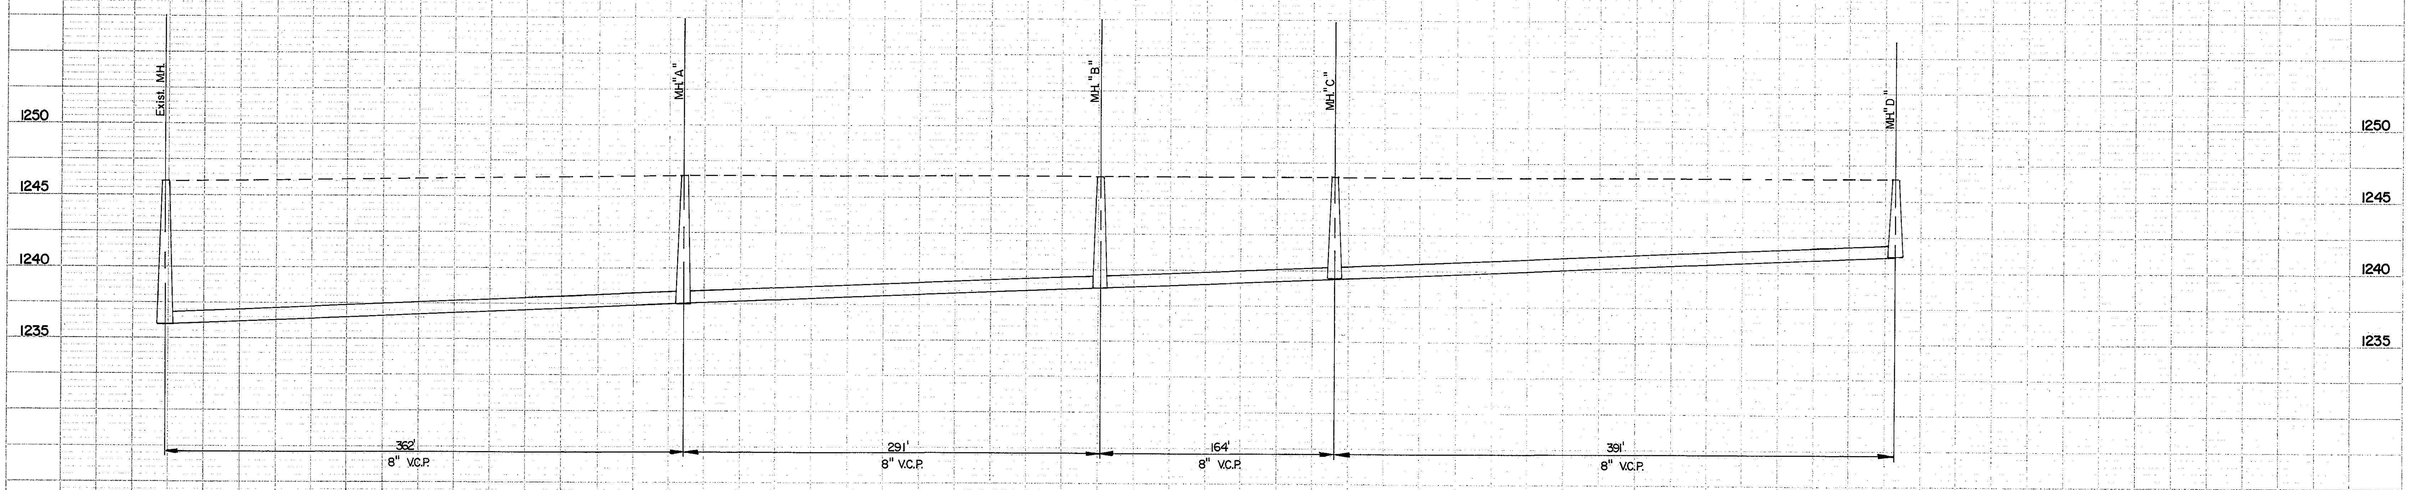

PROFILE
SURVEYED
PLOTTED
NOTE BOOK
STAKES CHECKED
B.M. & GRADES
STRUCTURE LOCATIONS CHECKED
No.
BY
DATE

PLAN
SURVEYED
PLOTTED
NOTE BOOK
ALIGNMENT CHECKED
R/W & GRADES
No.
BY
DATE