584

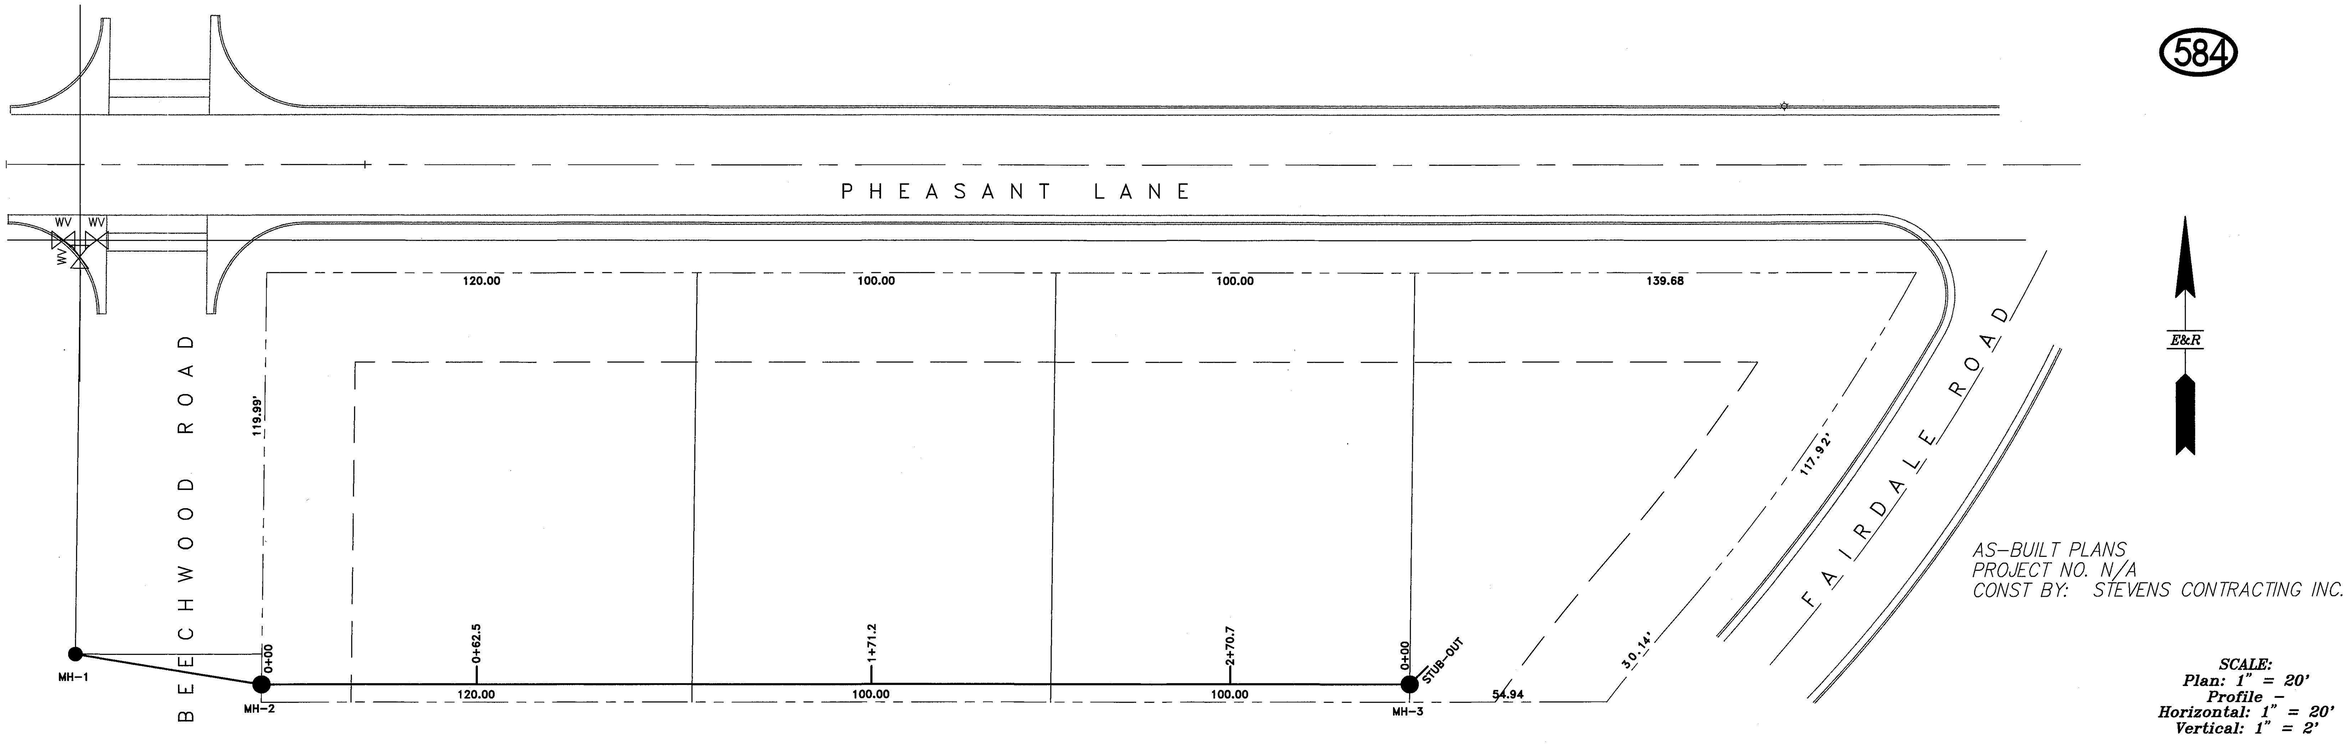

AS-BUILT PLANS
PROJECT NO. N/A
CONST BY: STEVENS CONTRACTING INC.

SCALE:
Plan: 1" = 20'
Profile –
Horizontal: 1" = 20'
Vertical: 1" = 2'

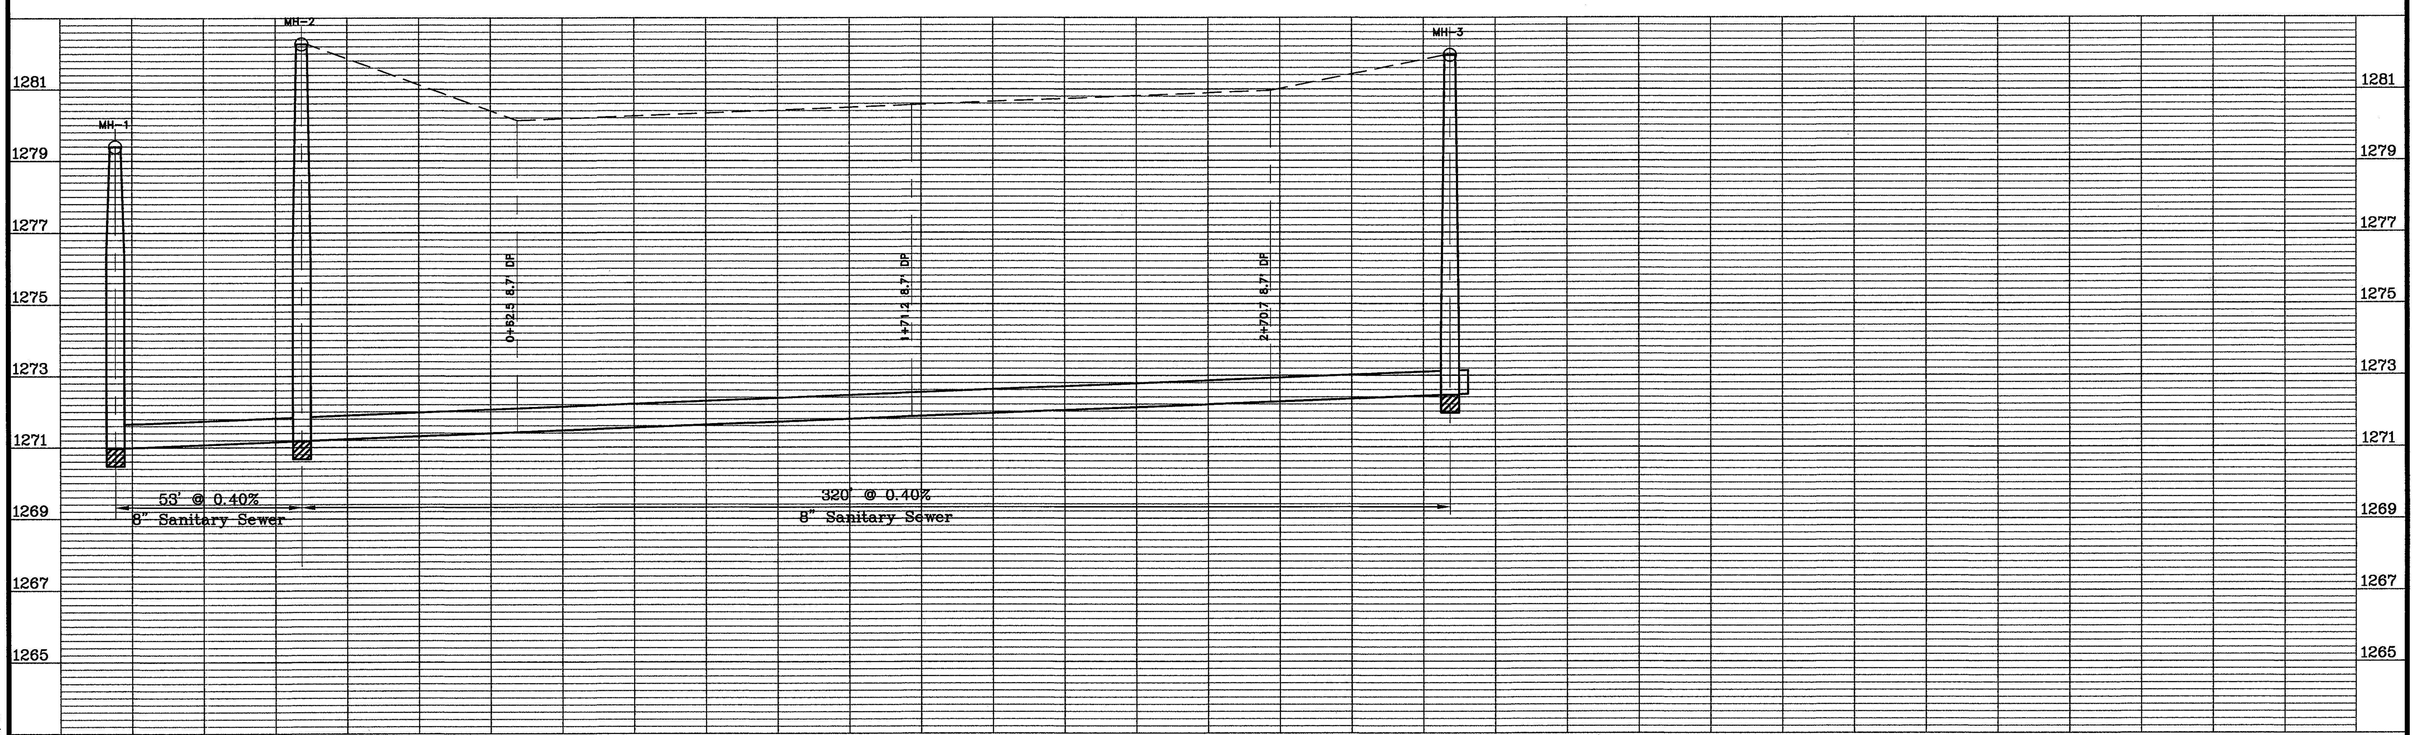

NO.	REVISIONS	DATE	BY	NO.	REVISIONS	DATE	BY

PROJECT TITLE:

SCALE:

DESIGN: | CHECKED:
DRAWN: | APPROVED:

CITY OF SALINA
ENGINEERING DEPARTMENT
300 WEST ASH SALINA, KANSAS 67401
(913)826-7290

DATE: DEC. 96
PROJ. NO.:
FILENAME:
SHEET: OF:

PP2436SI.DWG 11/09/95