Revised 5/97

586

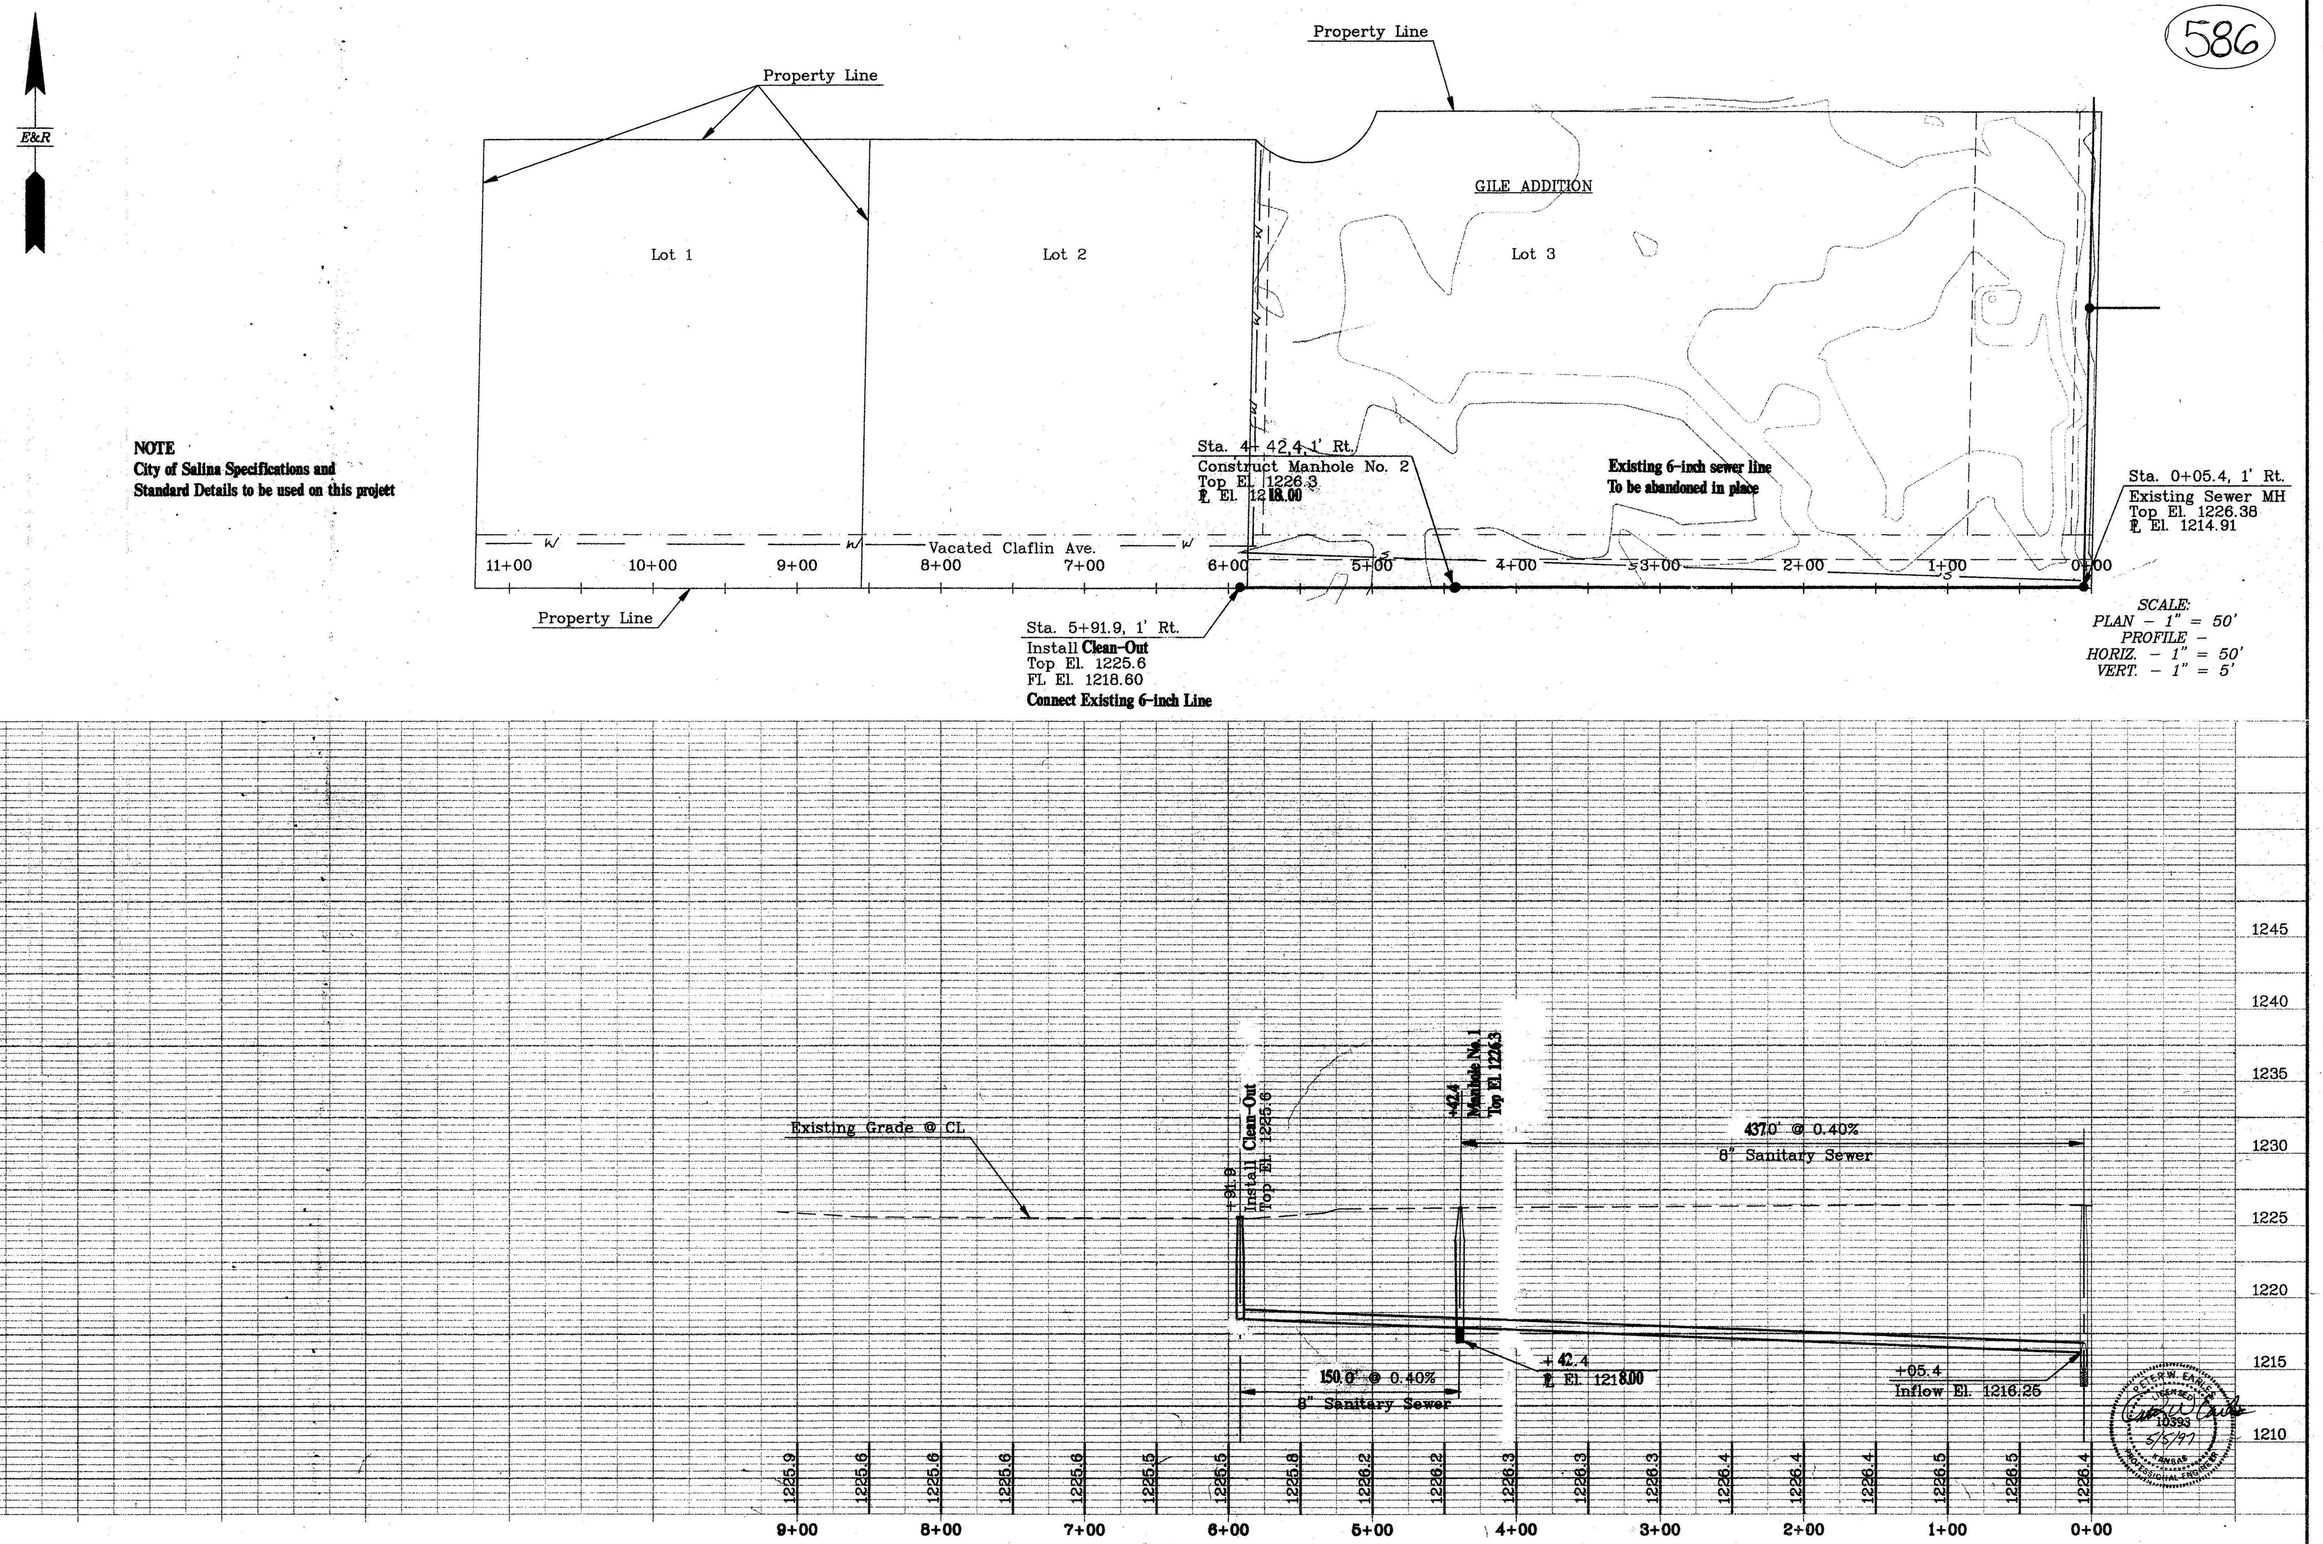

NOTE
City of Salina Specifications and Standard Details to be used on this projett

Additional Drawing Info: XREF Files used this drawing:
Path: F:\WORK.94\BRUMMET\
Title: Plan and Profile
Description: R.L. Brummet Construction, Sewer Extension

Earles & Riggs
Engineers – Planners – Landscape Architects
Project: 94-22
Filename: 94193.DWG

EARLES & RIGGS
ENGINEERS – PLANNERS – LANDSCAPE ARCHITECTS

Sheet 1 of 1