587

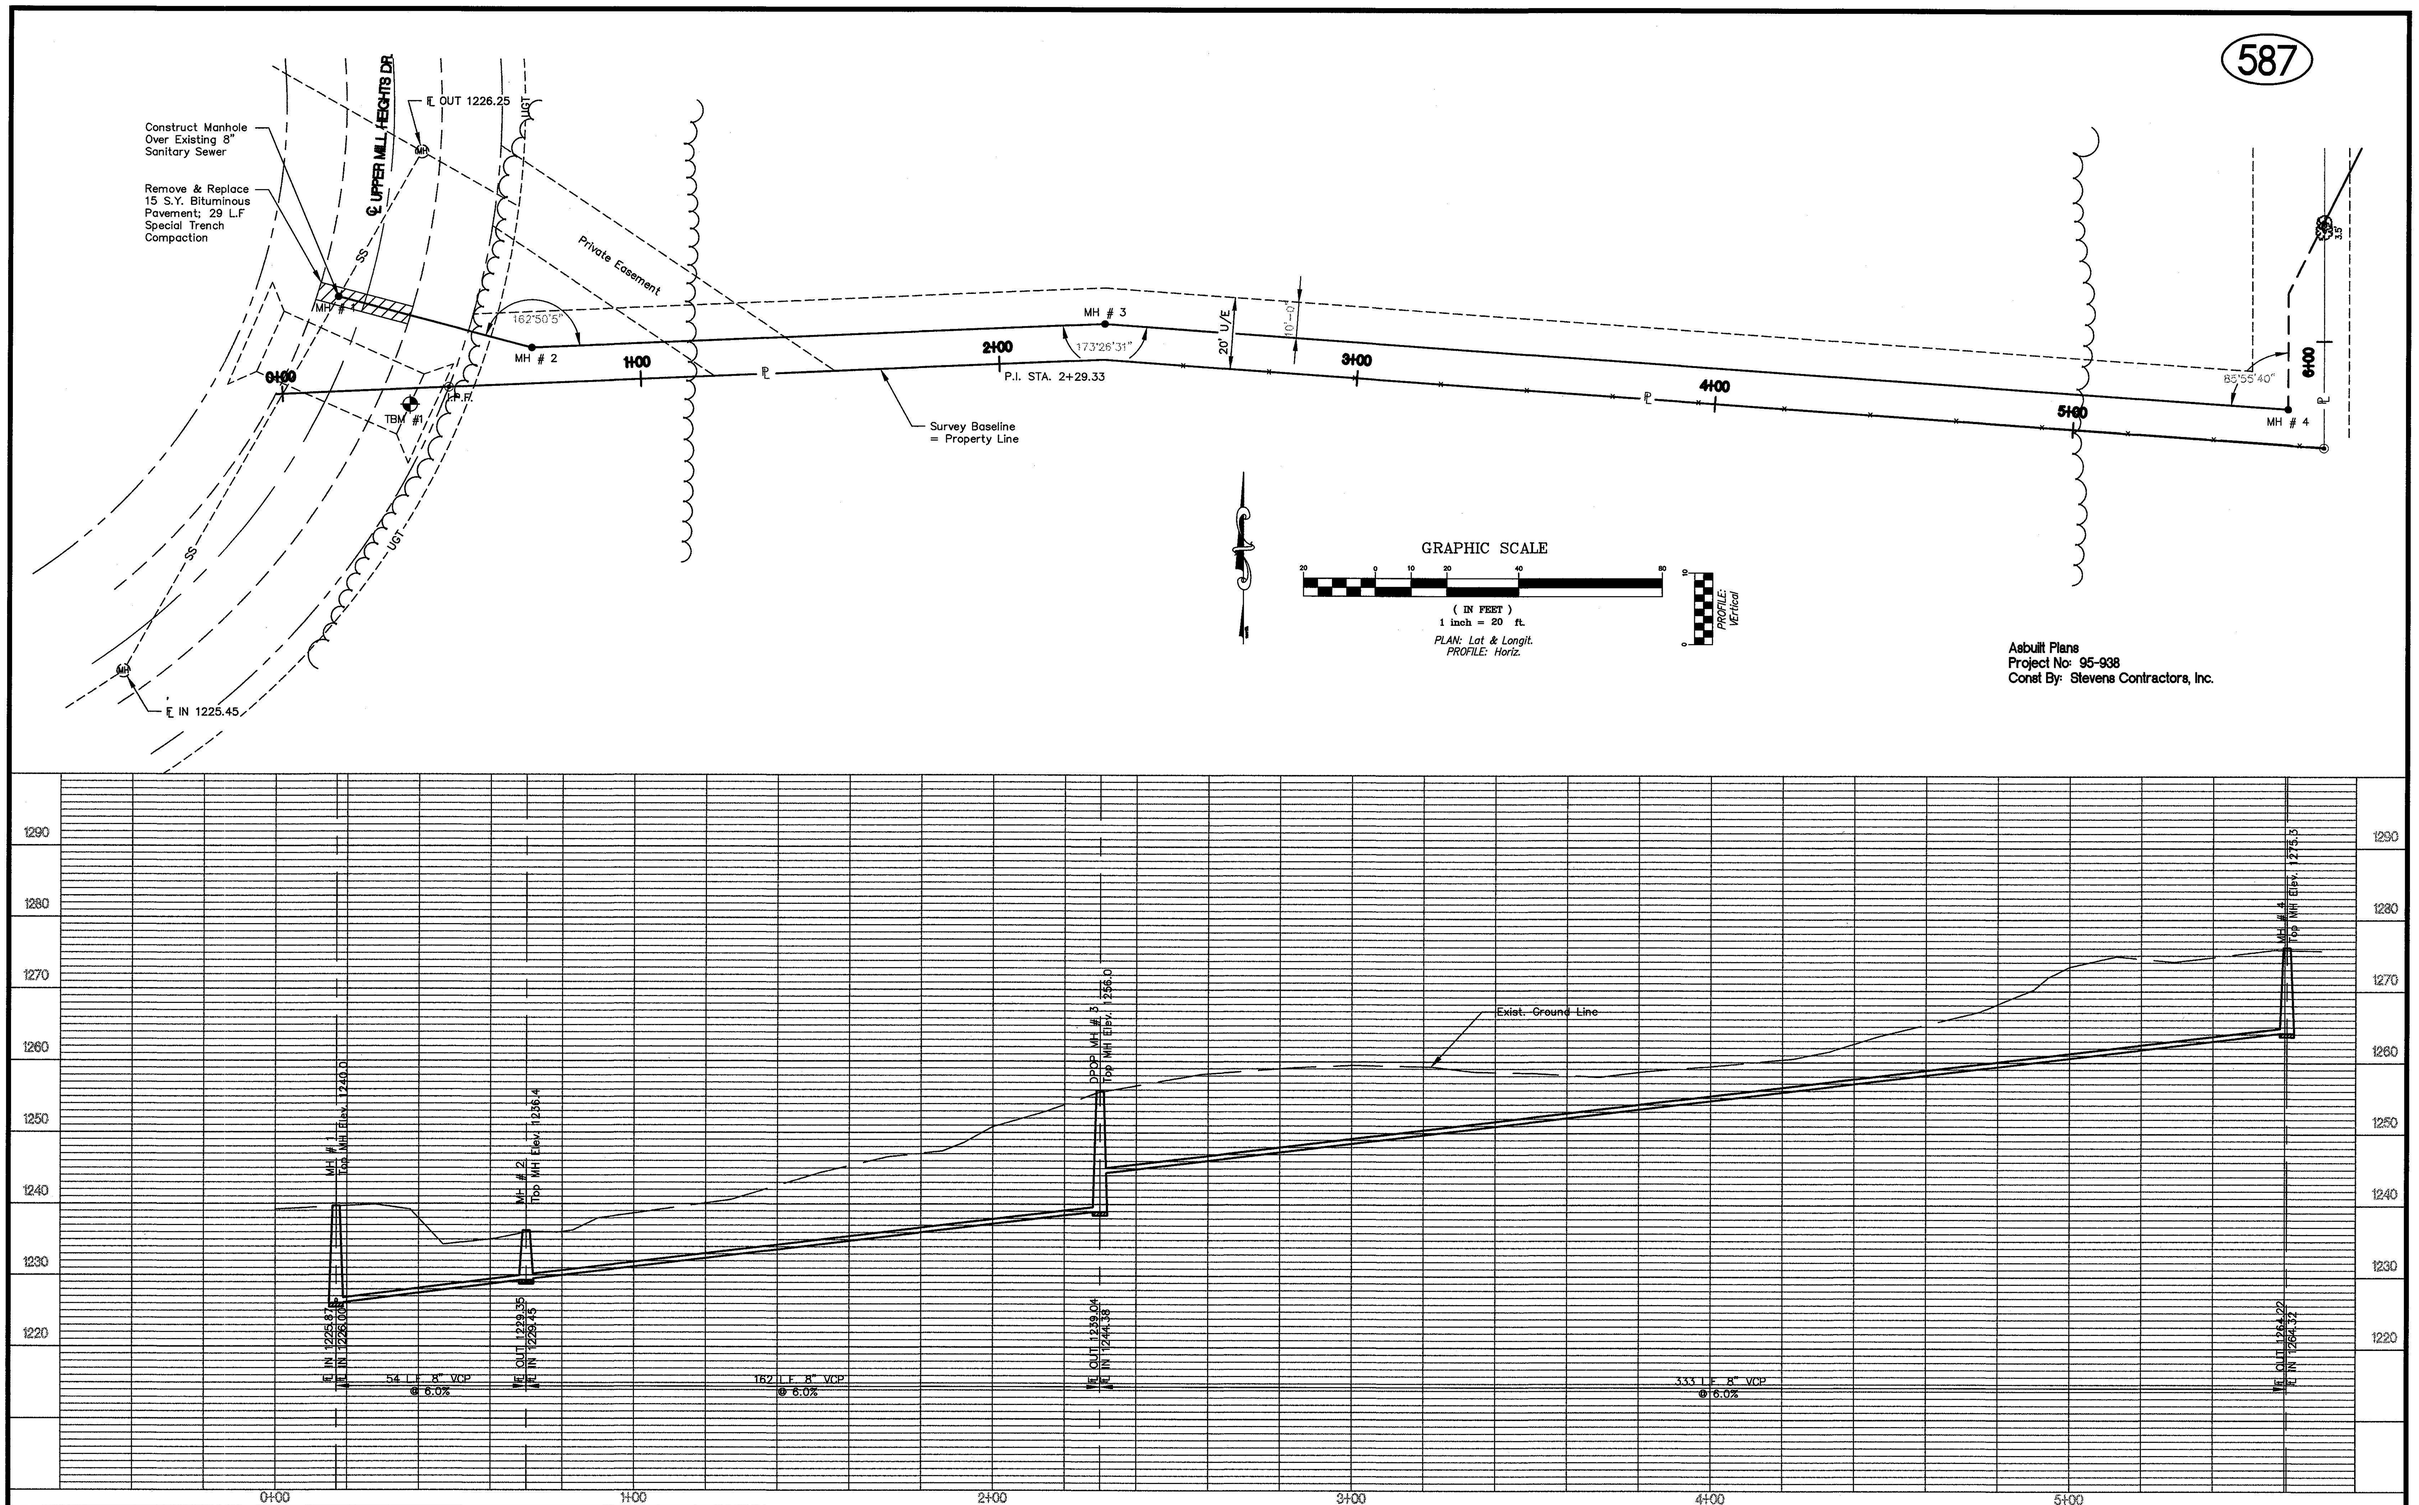

NO.	REVISIONS	DATE	BY	NO.	REVISIONS	DATE	BY

PROJECT TITLE: ASBUILT

SCALE: AS SHOWN

DESIGN:

DRAWN: M. Adams

CHECKED:

APPROVED:

CITY OF SALINA
ENGINEERING DEPARTMENT
300 WEST ASH SALINA, KANSAS 67401
(913)826-7290

DATE: AUG 95

PROJ. NO.: 95-938

FILENAME: ASBLT587.DWG

SHEET: OF:

PP2KN35S.DWG 19 OCT 93