588

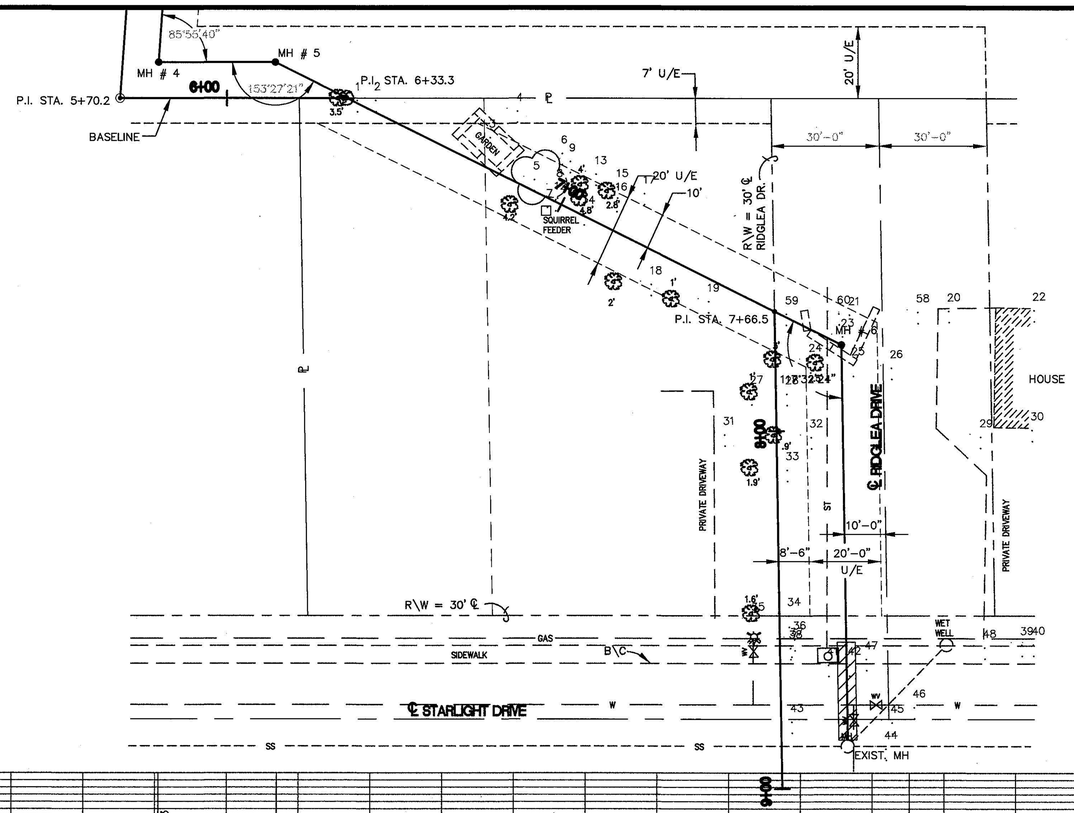

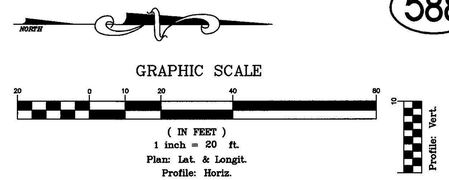

- PROPERTY LINE
- RIGHT-OF-WAY
- EASEMENT
- EXIST. PAVEMENT
- 0+00 BASELINE
- UGT EXIST. UNDERGROUND TELEPHONE
- GAS EXIST. GAS LINE
- W EXIST. WATER LINE
- SS EXIST. SANITARY SEWER
- ST EXIST. STORM SEWER
- BUSHES
- TREE
- RAIL ROAD TIES
- STORM INLET
- FIRE HYDRANT
- WATER VALVE
- MH EXIST. SANITARY MANHOLE

ASBUILT PLANS
PROJECT NO: 95-938
CONST BY: STEVENS CONTRACTORS, INC.

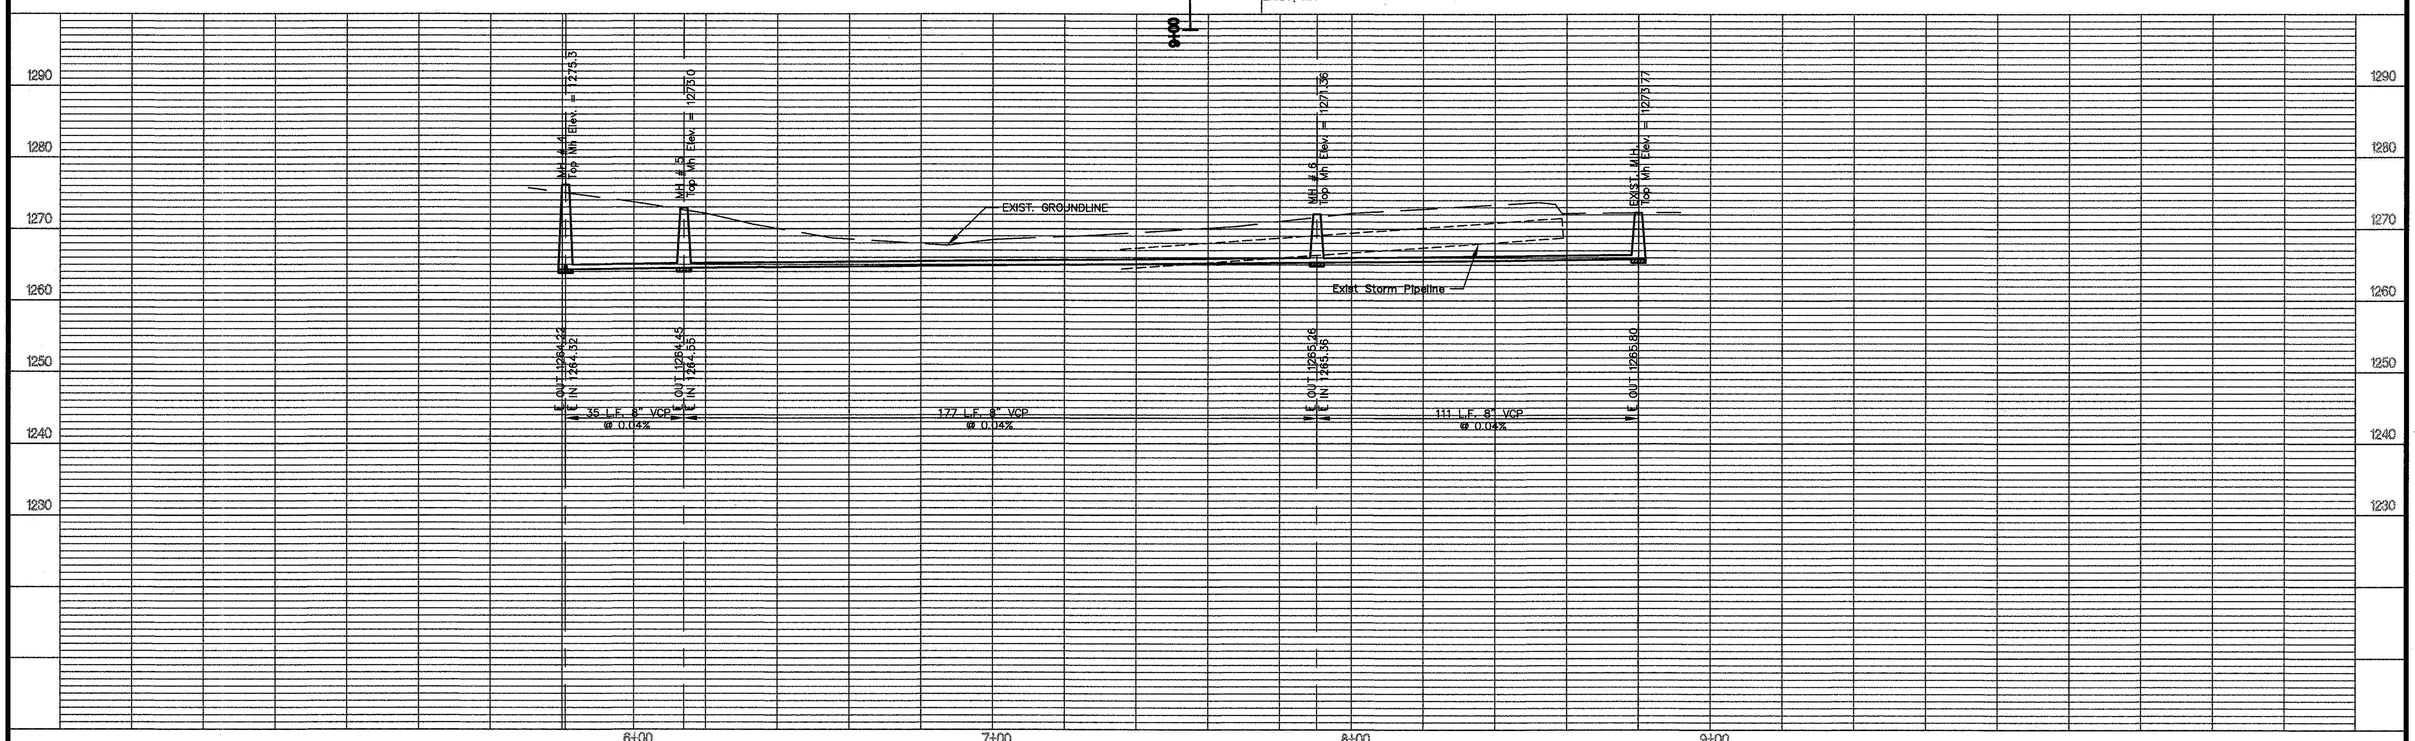

NO.	REVISIONS	DATE	BY	NO.	REVISIONS	DATE	BY

PROJECT TITLE: ASBUILT

SCALE: AS SHOWN

DESIGN: | CHECKED:
DRAWN: M. Adams | APPROVED:

CITY OF SALINA
ENGINEERING DEPARTMENT
300 WEST ASH SALINA, KANSAS 67401
(913)826-7290

DATE: AUG 95 | PROJ. NO.: 95-938
FILENAME: xxx.dwg | SHEET: | OF:

FP24X36S.DWG 13 OCT 93