Asbuilt Plans
Project No: 96-971
Const By: Stevens Contractors, Inc.

589

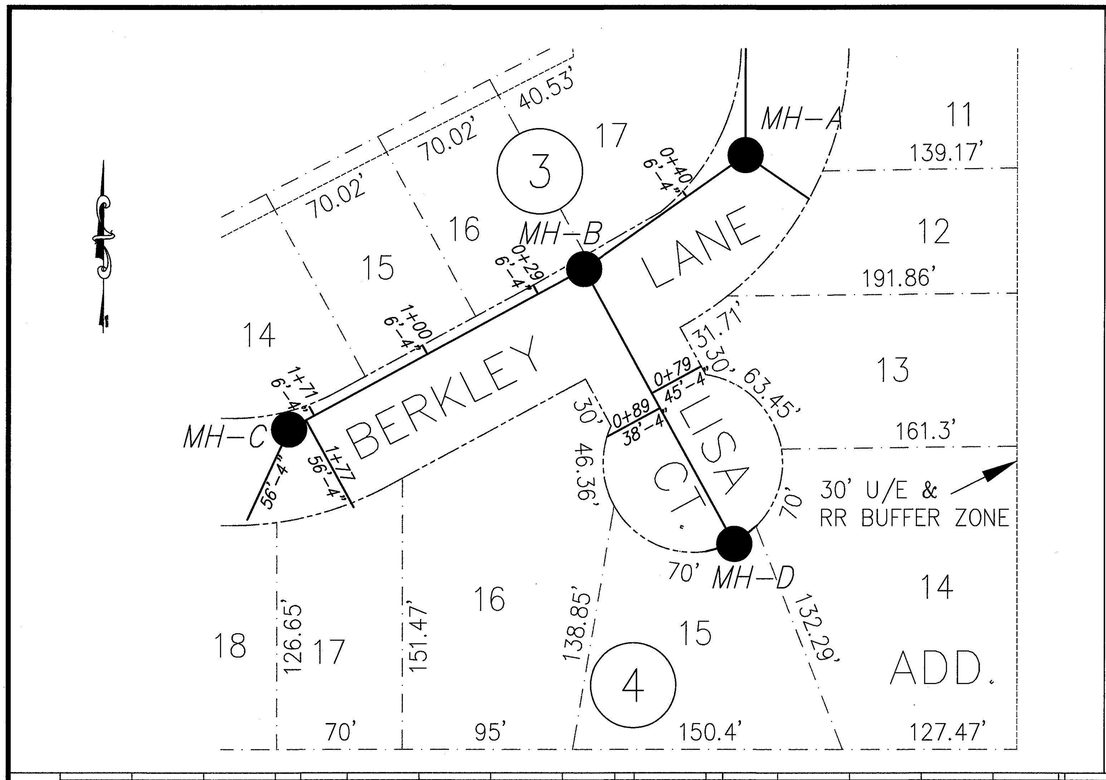

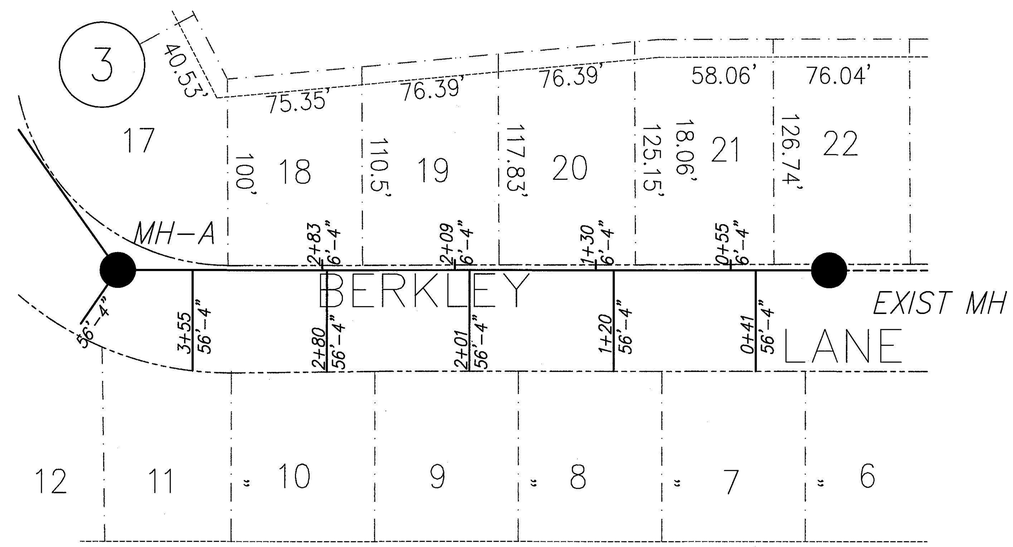

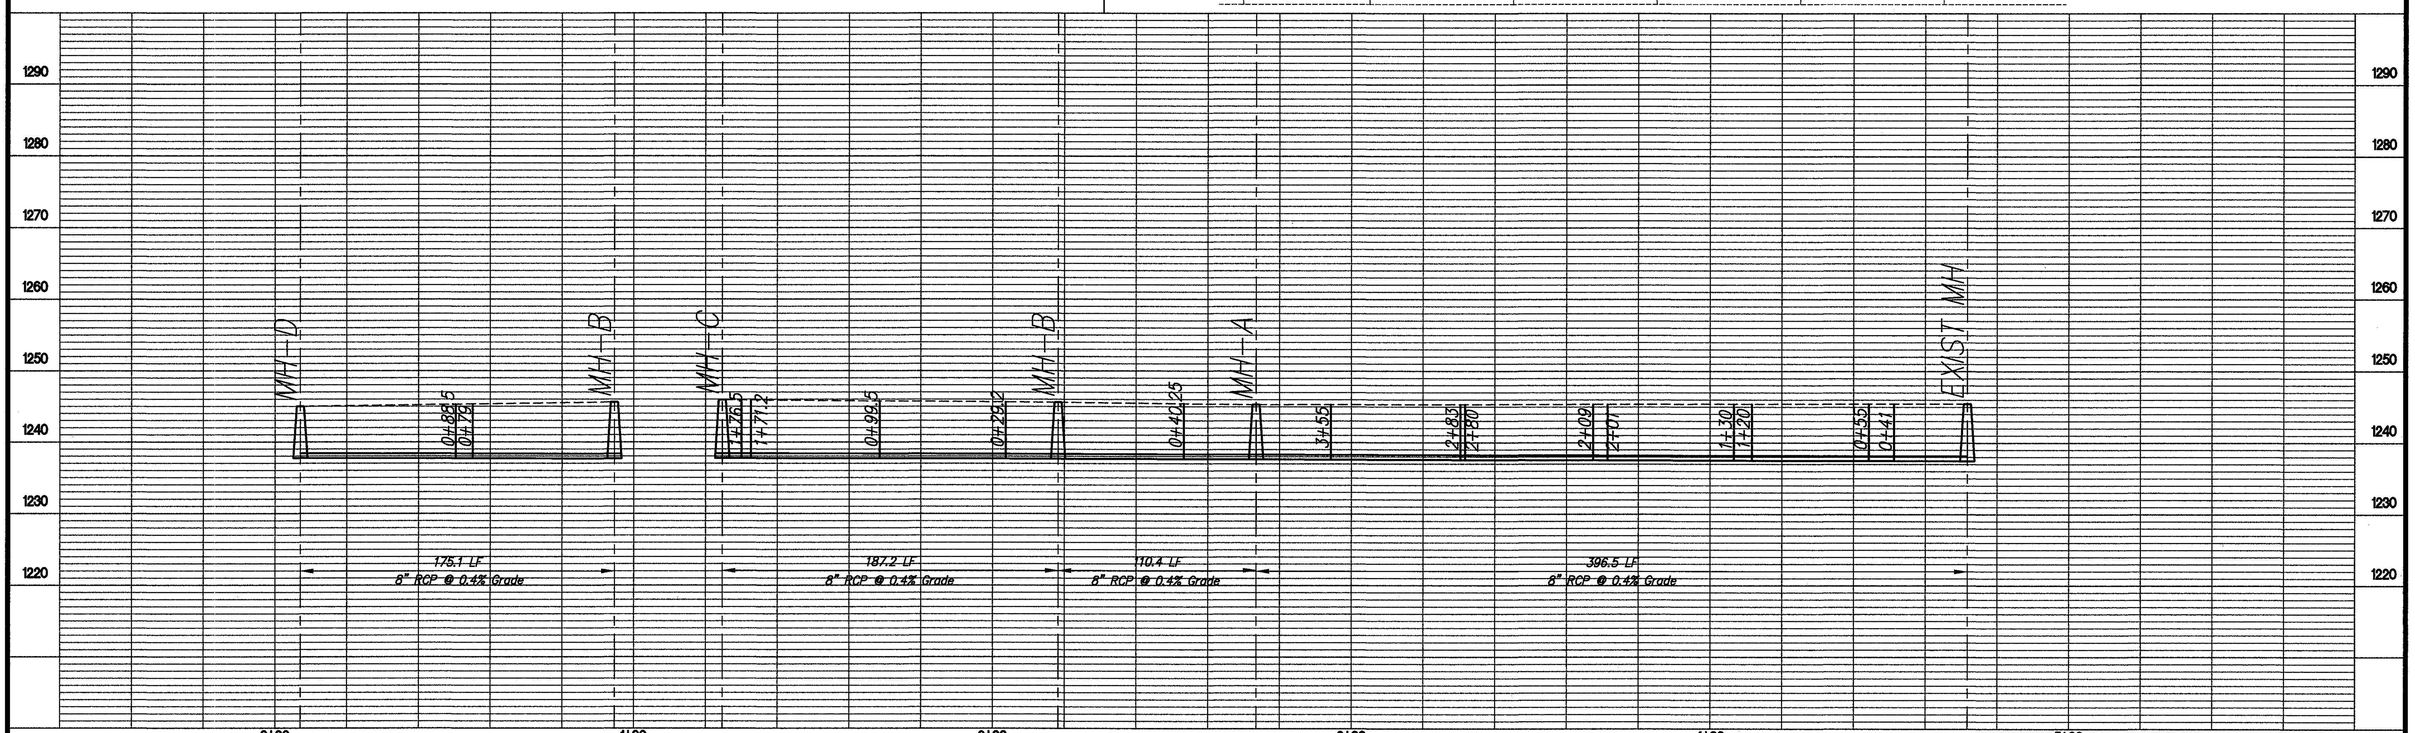

NO.	REVISIONS	DATE	BY	NO.	REVISIONS	DATE	BY

PROJECT TITLE: ASBUILT

SCALE: AS SHOWN

DESIGN:
DRAWN: M. Adams
CHECKED:
APPROVED:

CITY OF SALINA
ENGINEERING DEPARTMENT
300 WEST ASH SALINA, KANSAS 67401
(913)826-7290

DATE: AUG 95
PROJ. NO.: 96-971
FILENAME: ASBLT589.DWG
SHEET:
OF:

P:\24X36S.DWG 19 OCT 93