595

Golden Eagle Estates Addition Phase II Oct 1997

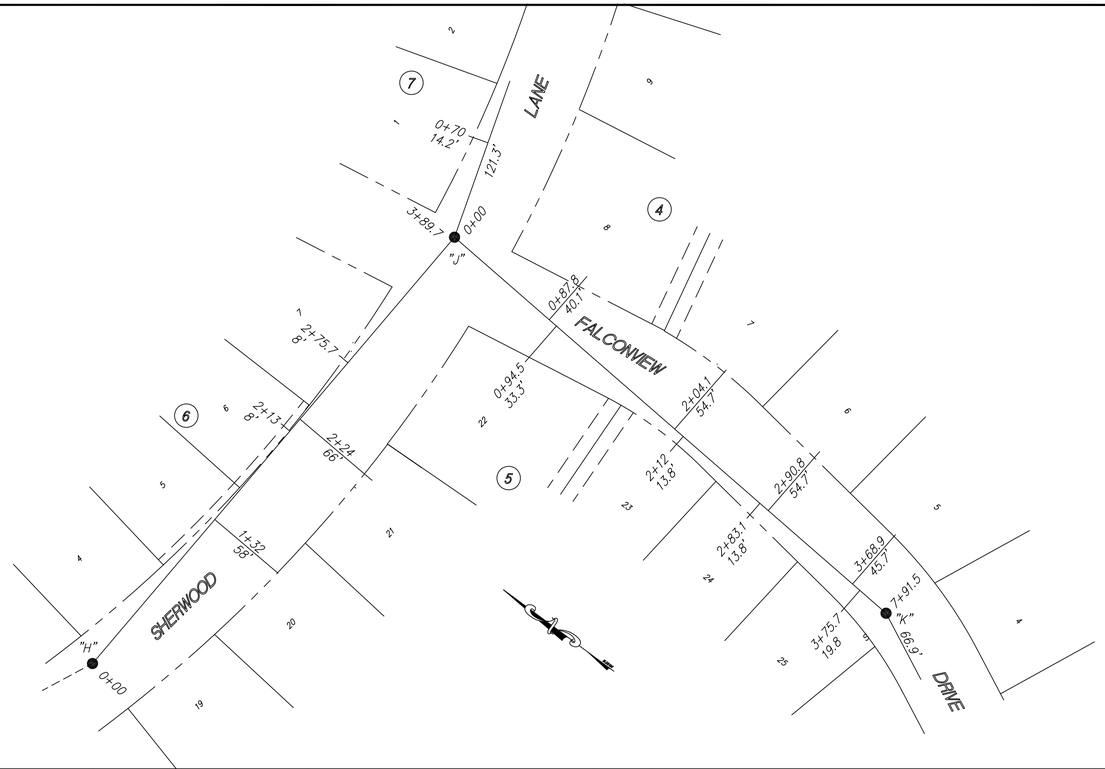

City Benchmark #93:
"M" in Mueller, top of FH NW corner of Sequoia & Huntington;
Elev = 1233.97

SCALE:
Plan: 1" = 50'
Profile –
Horizontal: 1" = 50'
Vertical: 1" = 5'

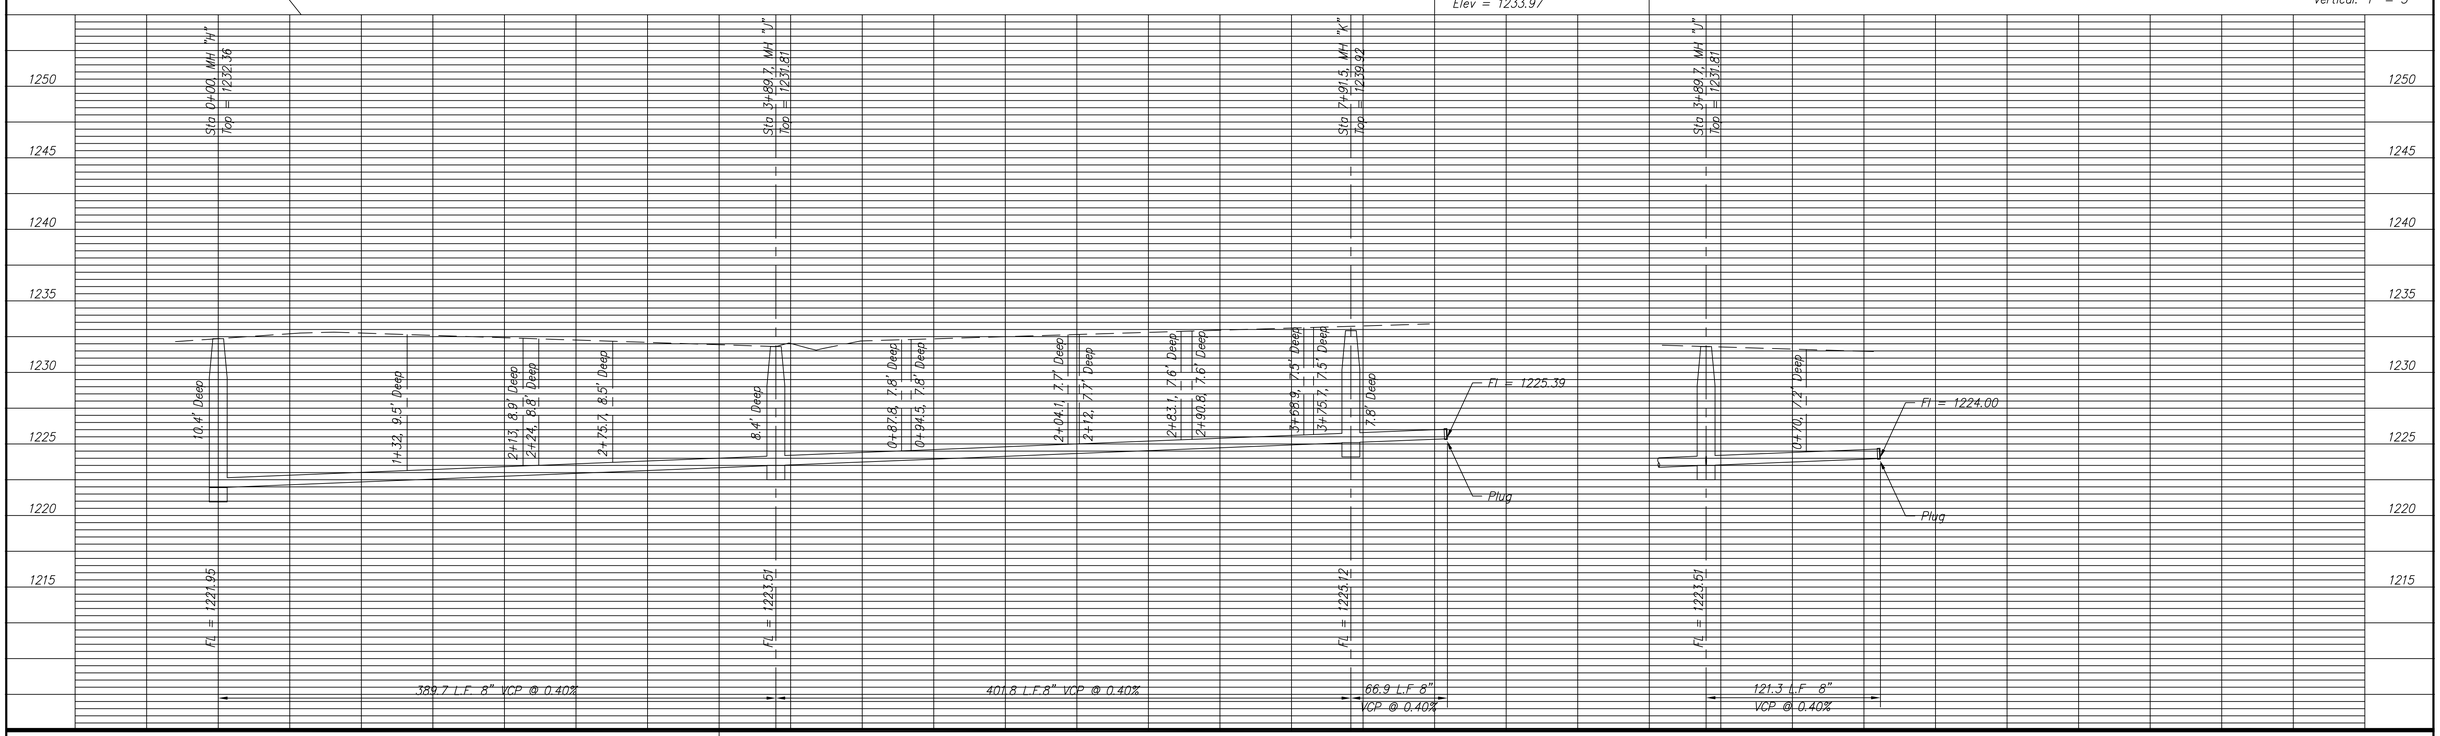

NO.	REVISIONS	DATE	BY	NO.	REVISIONS	DATE	BY

PROJECT TITLE:

SCALE:

DESIGN: CHECKED:

DRAWN: APPROVED:

CITY OF SALINA
ENGINEERING DEPARTMENT
300 WEST ASH SALINA, KANSAS 67401
(913)826-7290

DATE: PROJ. NO.:

FILENAME: SHEET: OF: