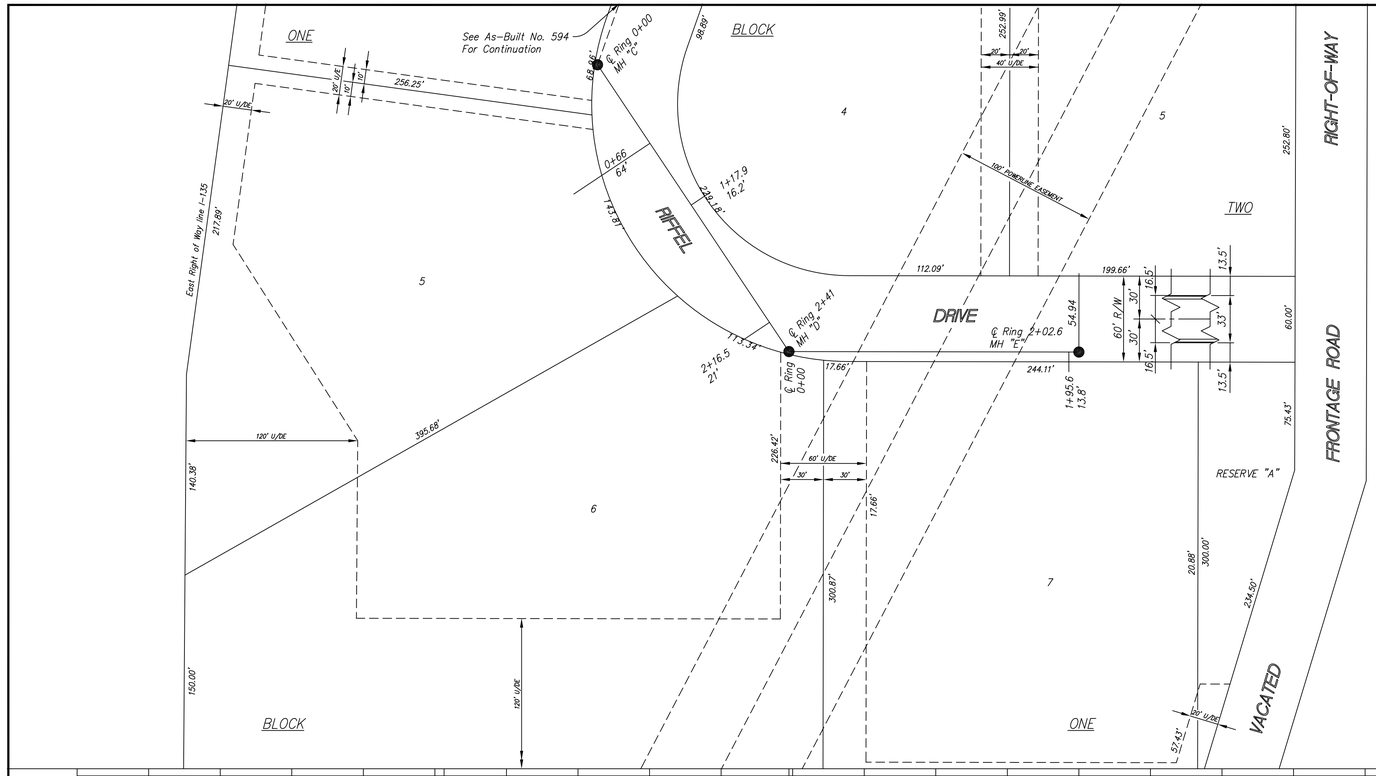

601

Riffel Addition - Phase 2
July 1999

LOCAL BM #1: Spike in power pole NW of Schilling Rd & Ninth St. Elev = 1246.83

NOTE: All Sanitary Sewer mains are 8" unless noted otherwise.

NOTE: Distance from back of curb to property line is based on the street being built in the center of the right-of-way.

NOTE: All Streets are 33' back to back of curb Right-of-Ways are 60' unless noted otherwise.

SCALE:
Plan: 1" = 50'
Profile -
Horizontal: 1" = 50'
Vertical: 1" = 5'

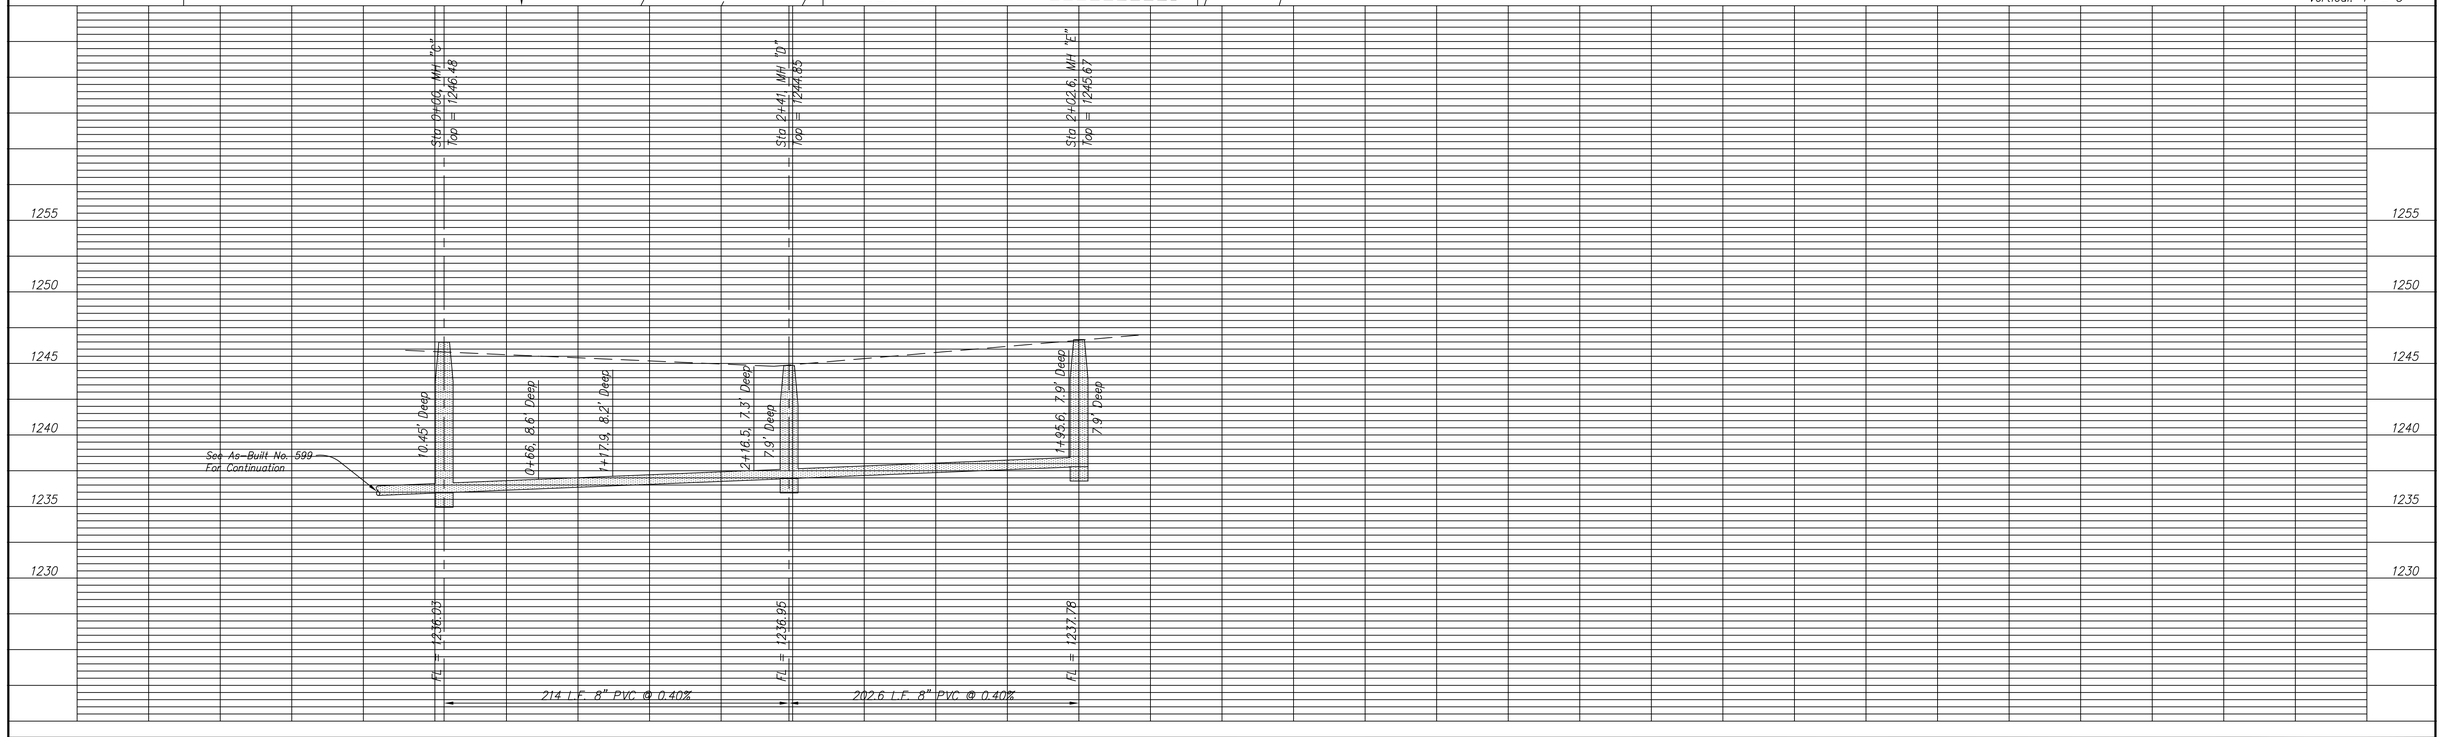

NO.	REVISIONS	DATE	BY	NO.	REVISIONS	DATE	BY

PROJECT TITLE: Sanitary Sewer As-Built Drawing

CONSTRUCTED BY: Smoky Hill Contractors

SCALE: As Shown

DESIGN: | CHECKED:
DRAWN: | APPROVED:

CITY OF SALINA
ENGINEERING DEPARTMENT
300 WEST ASH SALINA, KANSAS 67401
(913)826-7290

DATE: 02 Aug 99
FILENAME: 601.dwg
PROJ. NO.: 98-1139
SHEET: OF: