607

Frank Industrial Area

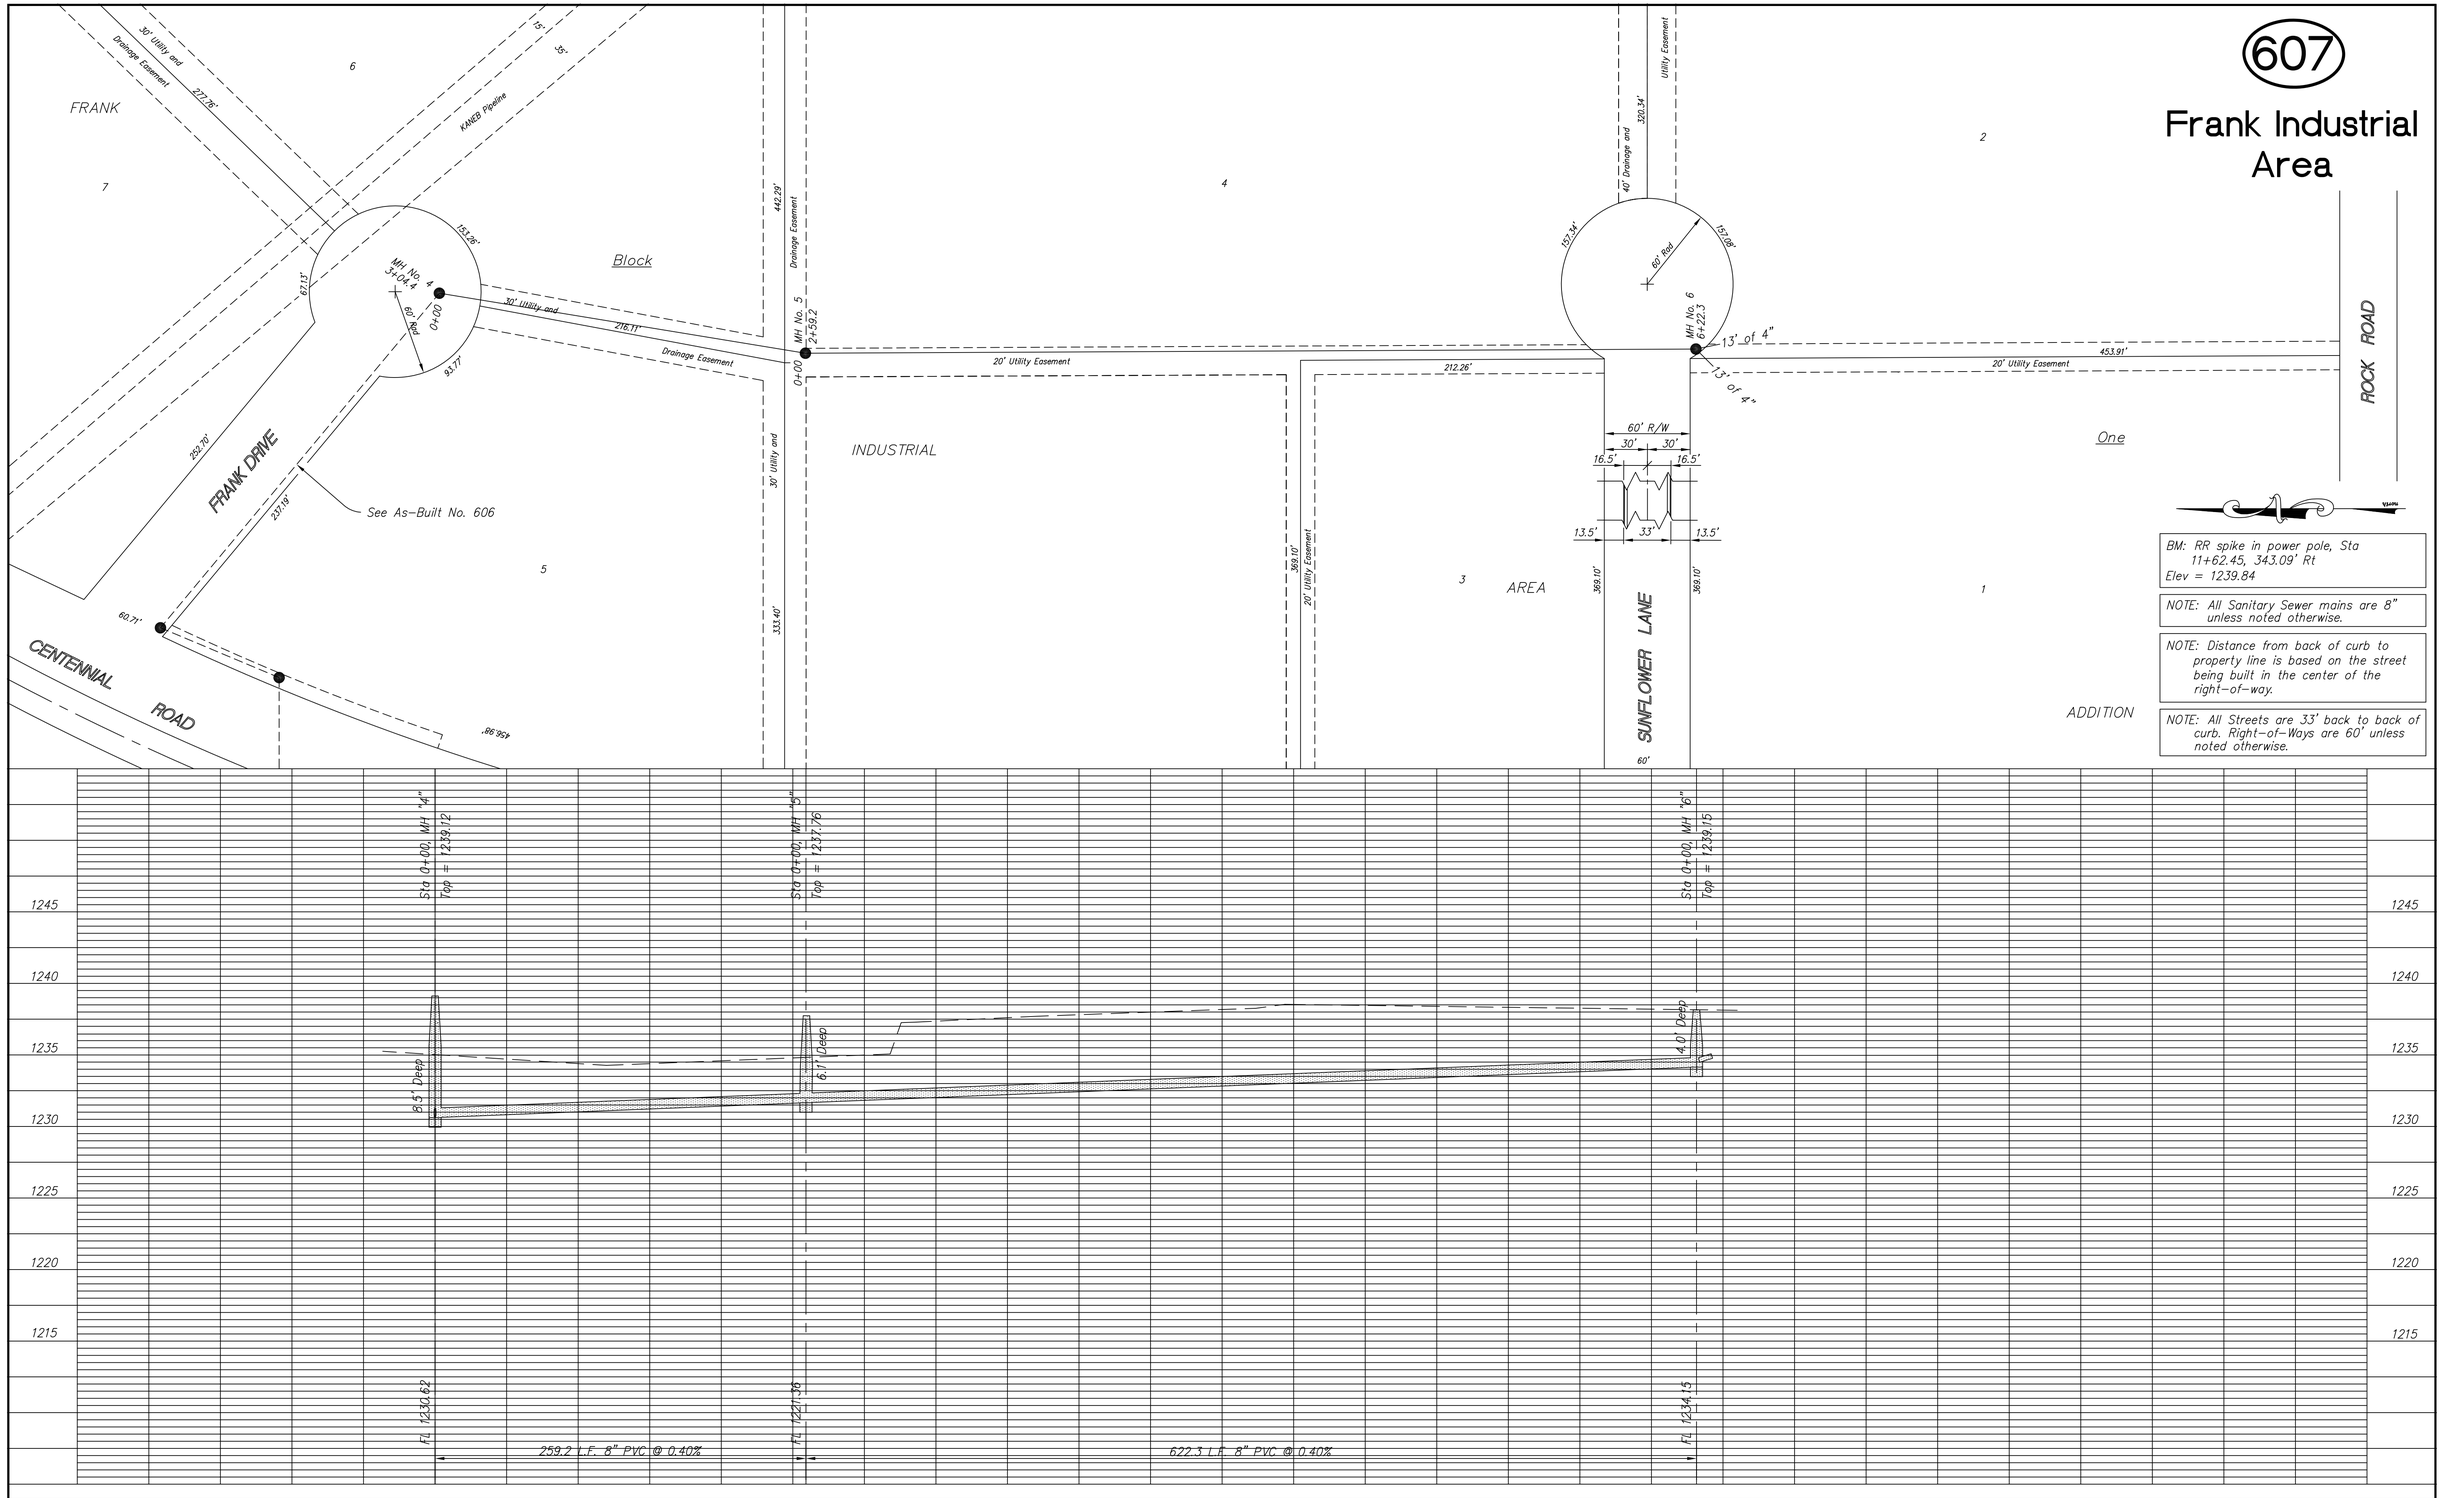

NO.	REVISIONS	DATE	BY	NO.	REVISIONS	DATE	BY

PROJECT TITLE: Sanitary Sewer As-Built Drawing

CONSTRUCTED BY: Smoky Hill Contractors

SCALE: Plan: 1" = 50' Profile – Horizontal: 1" = 50' Vertical: 1" = 5'

DESIGN: | CHECKED: | DRAWN: | APPROVED:

CITY OF SALINA
ENGINEERING DEPARTMENT
300 WEST ASH SALINA, KANSAS 67401
(913)826-7290

DATE: Jan 2000 | PROJ. NO.: 99-1192
FILENAME: 607.dwg | SHEET: | OF: