624

Hidden Meadows Addition Sept 2000

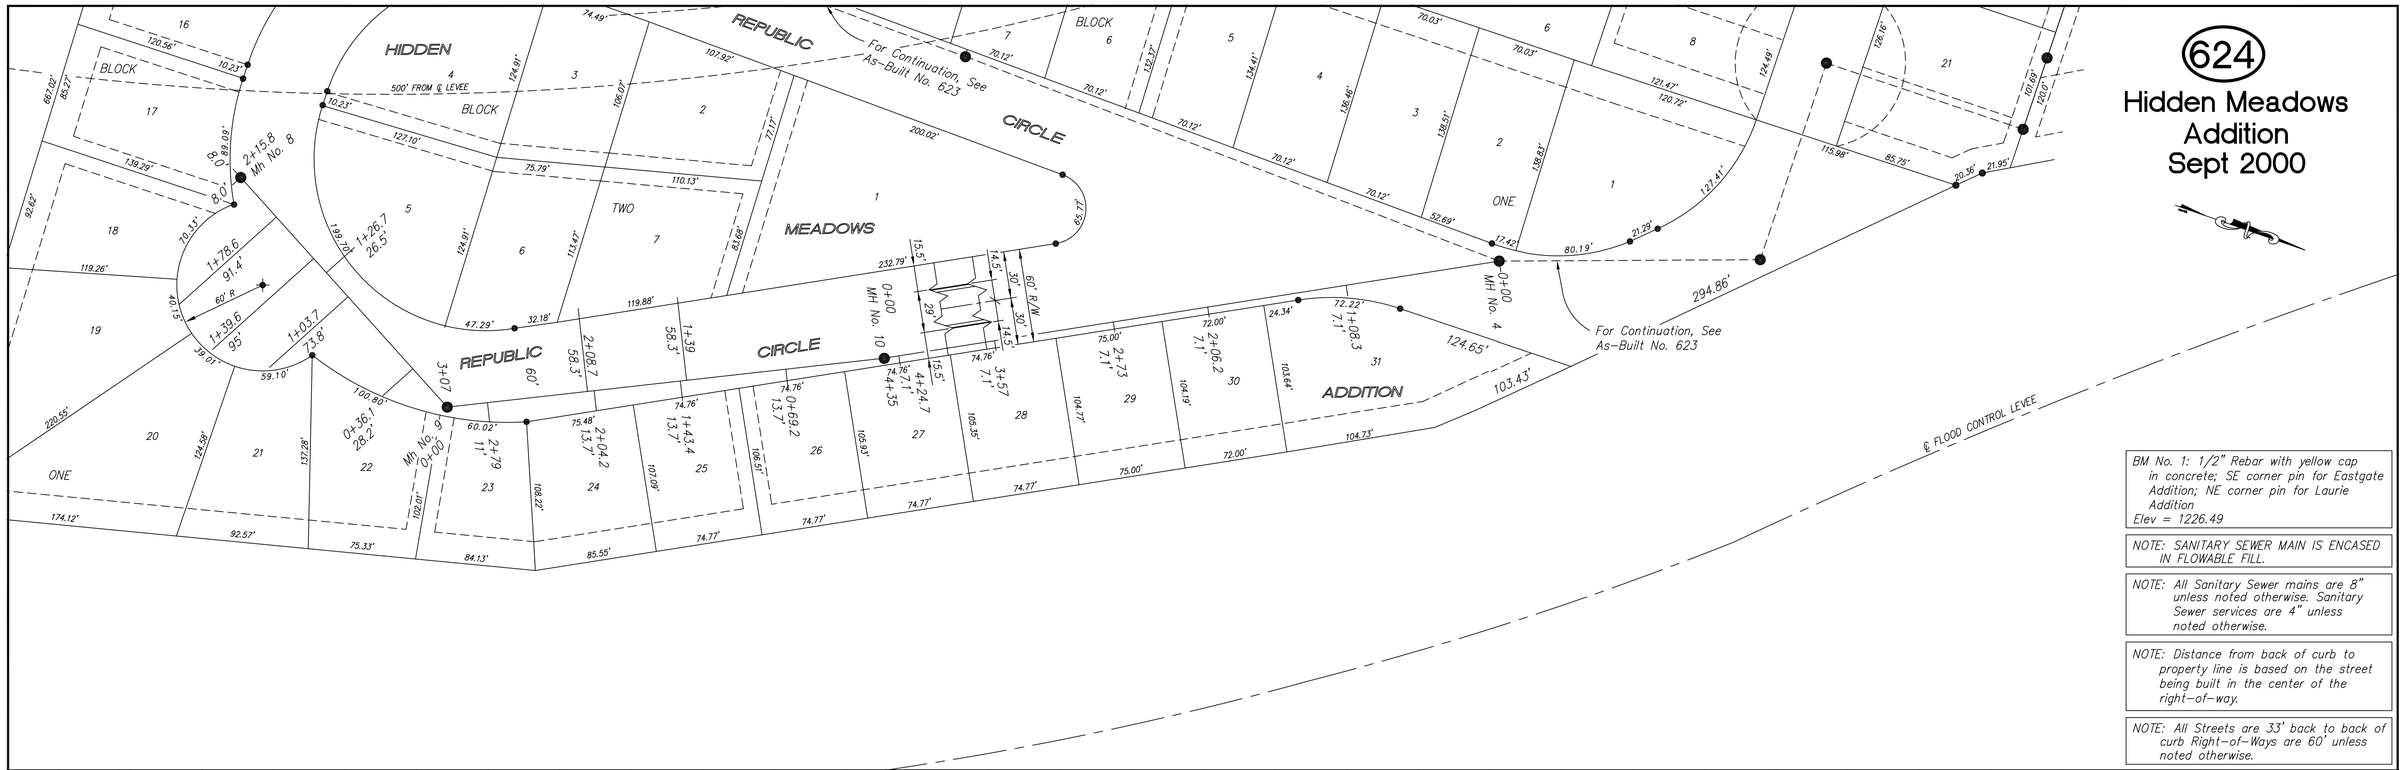

BM No. 1: 1/2" Rebar with yellow cap in concrete; SE corner pin for Eastgate Addition; NE corner pin for Laurie Addition
Elev = 1226.49

NOTE: SANITARY SEWER MAIN IS ENCASED IN FLOWABLE FILL.

NOTE: All Sanitary Sewer mains are 8" unless noted otherwise. Sanitary Sewer services are 4" unless noted otherwise.

NOTE: Distance from back of curb to property line is based on the street being built in the center of the right-of-way.

NOTE: All Streets are 33' back to back of curb Right-of-Ways are 60' unless noted otherwise.

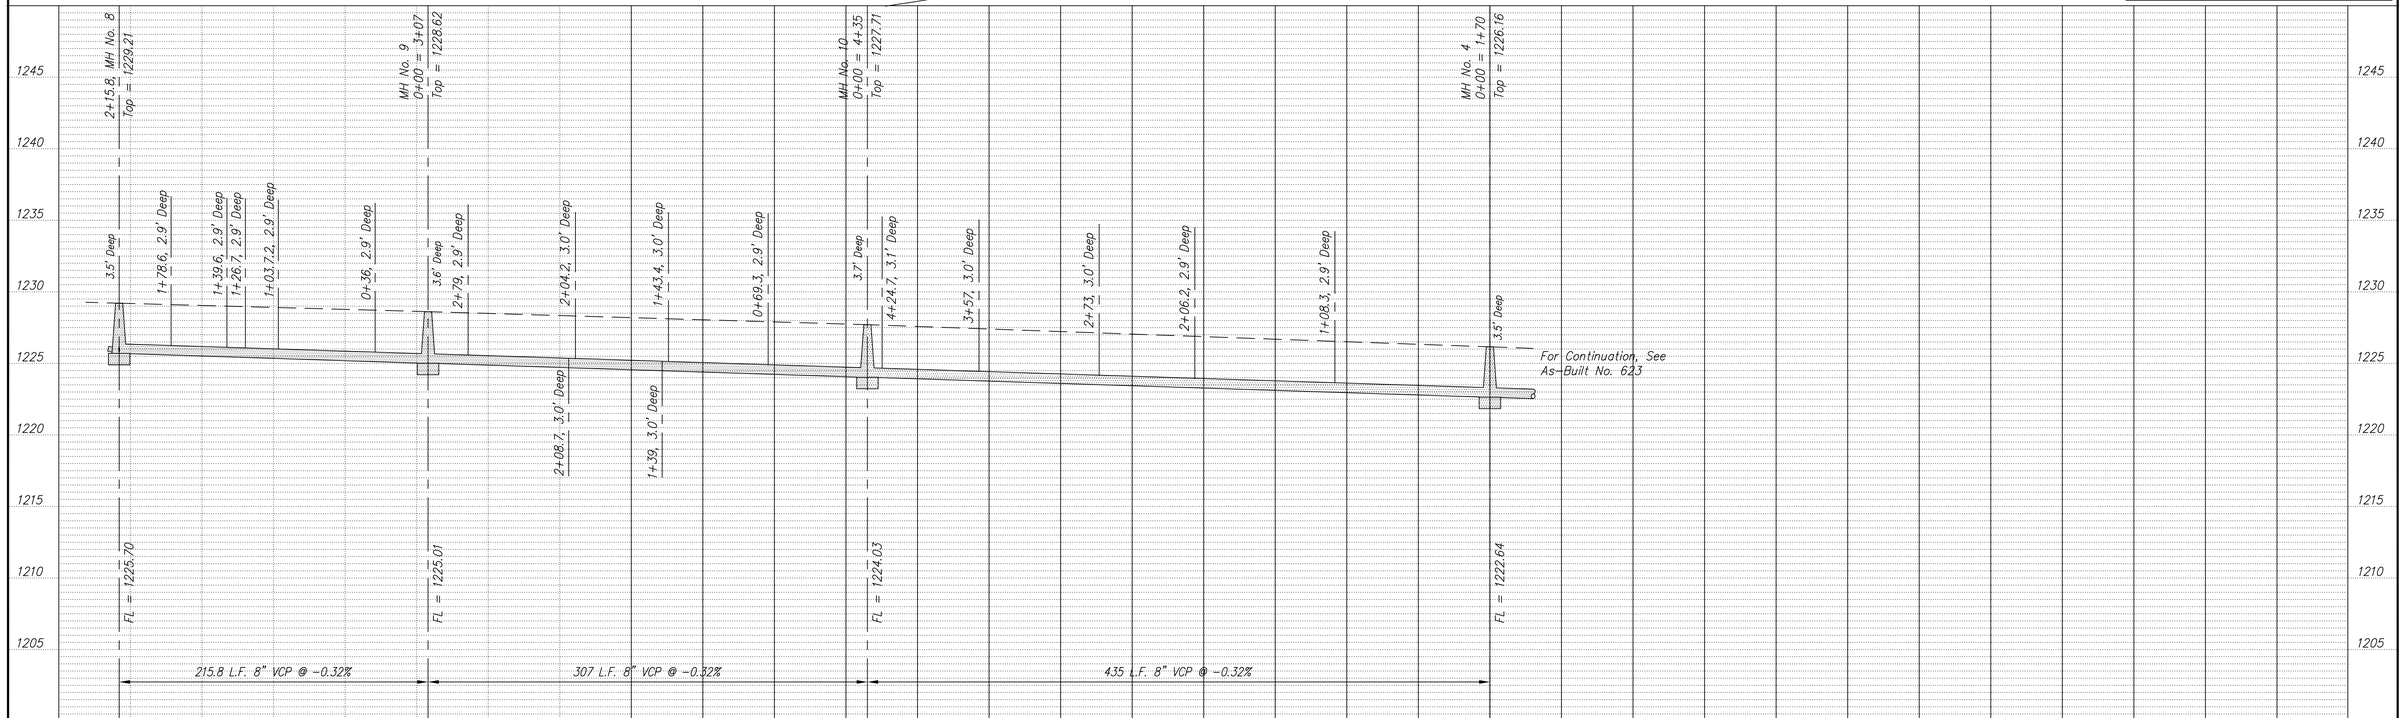

NO.	REVISIONS	DATE	BY

NO.	REVISIONS	DATE	BY

PROJECT TITLE: Sanitary Sewer As-Built Drawing

CONSTRUCTED BY: Stevens Contractors

SCALE: Plan: 1" = 50' Profile: Horiz.1" = 50' Vert. 1" = 5'

DESIGN:

CHECKED:

DRAWN: KWD

APPROVED:

CITY OF SALINA
ENGINEERING DEPARTMENT
300 WEST ASH SALINA, KANSAS 67401
(913)826-7290

DATE: Feb 2001

PROJ. NO.: Built Private

FILENAME: 624.dwg

SHEET:

OF: