NOTE:
1. LOCATION OF EXISTING SANITARY SEWER INTERCEPTOR AND MANHOLES IS BASED ON PLANS PROVIDED BY THE CITY OF SALINA AND HAS NOT BEEN FIELD VERIFIED. CONTRACTOR IS RESPONSIBLE TO FIELD VERIFY LOCATION & ℄ OF INTERCEPTOR AND NOTIFY ENGINEER OF ANY DEVIATIONS PRIOR TO CONSTRUCTION.
2. ADJUST EXISTING MANHOLE RIMS TO FINISHED GRADE. CONTRACTOR TO REMOVE CONE AND ADD MANHOLE SECTIONS AS NECESSARY. SEE PLAN MAX. OF TWO ADJUSTMENT RINGS (12") TOTAL HEIGHT ALLOWED.
3. CONTRACTOR SHALL COAT MANHOLE WITH ZEBRON POLYMER COATING OR APPROVED EQUAL AT MANUFACTURES RECOMMENDATIONS.

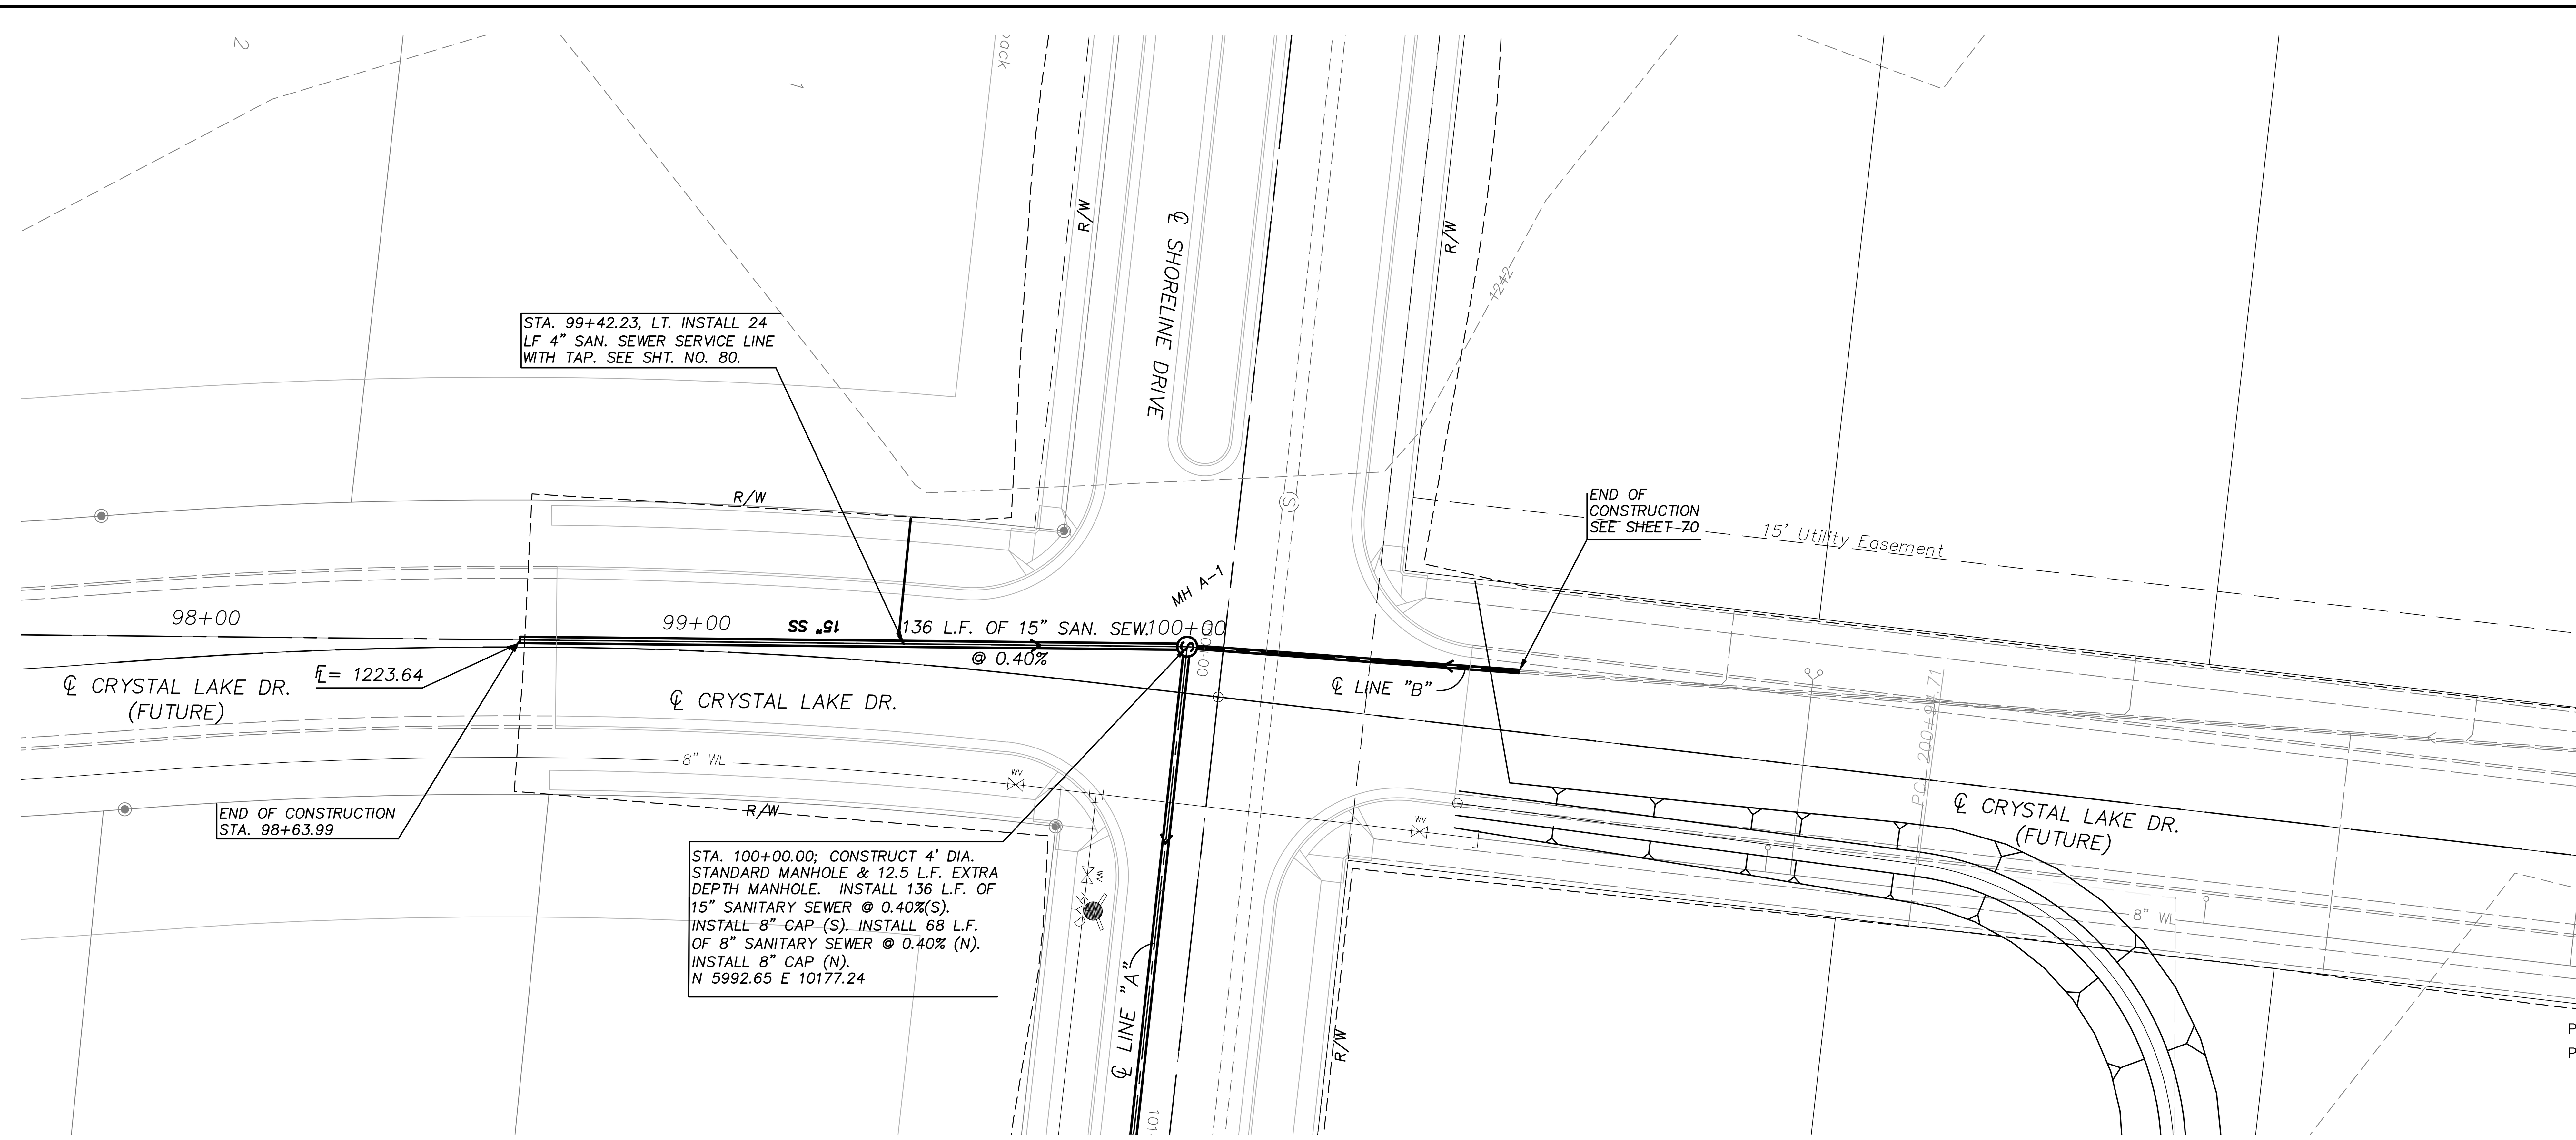

SCALE IN FEET 20 0 20 40

PLAN: Lat. & Long.
PROFILE: Horiz. same as above
Vert.

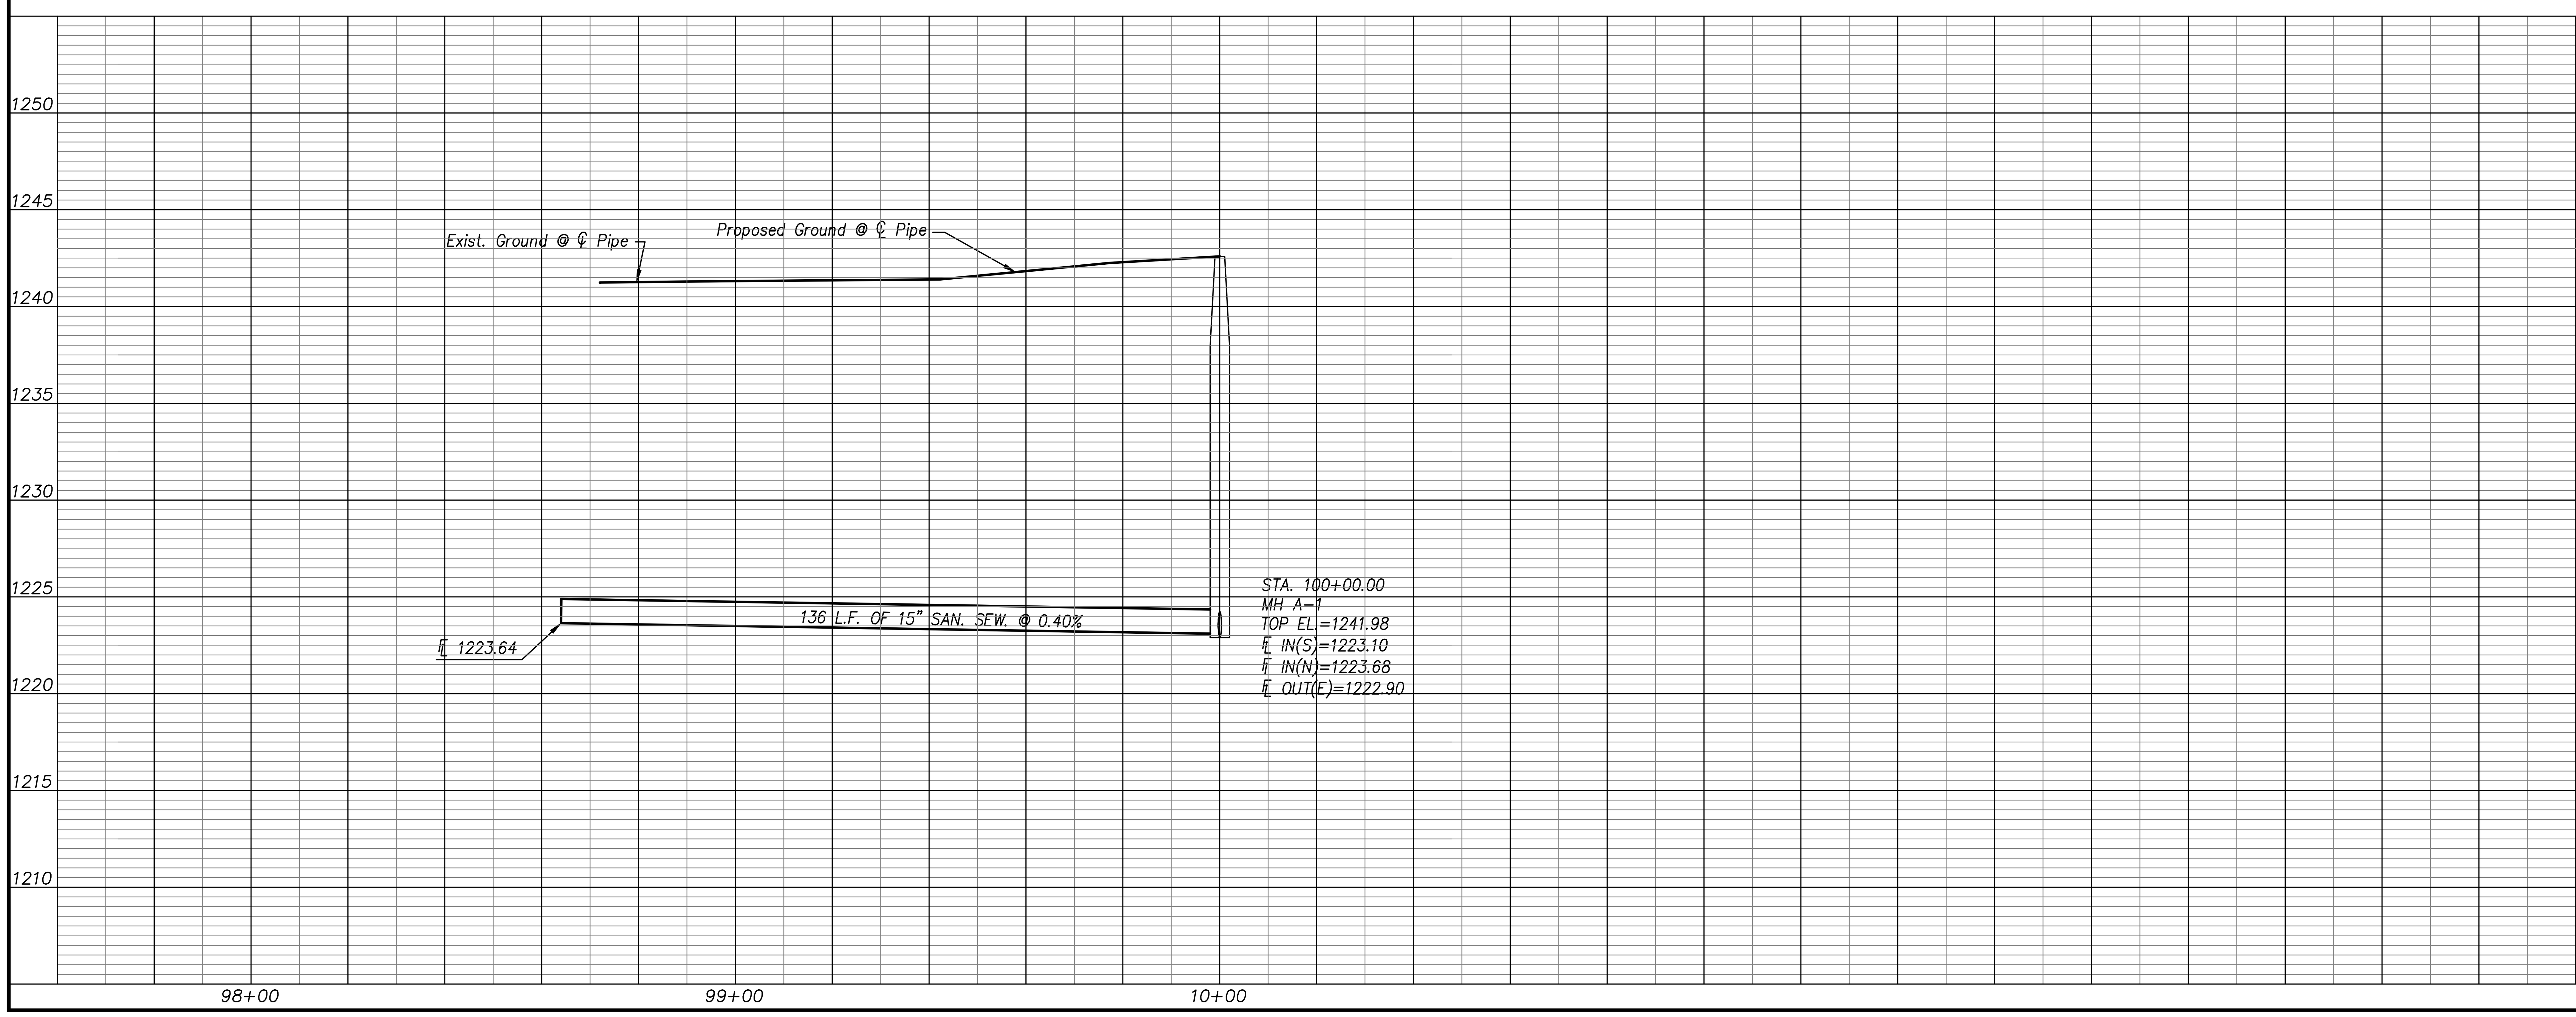

PLAN & PROFILE
SAN. SEW. LINE A
STA. 98+63.99 TO STA. 100+00.00

SEAL:

DESIGNER: CFS Cook, Flatt & Strobel ENGINEERS, P.A.

CFS PROJECT NO: 10-5140

OWNER: Sparrowhawk Land, LLC 105 Industrial Road Concordia, KS 66901

DEVELOPER: ComPro Realty 157 So. Seventh Salina, KS 66901

STREET, SEWER & WATER IMPROVEMENTS TO SERVE STONE LAKE ADDITION, PHASE I SALINA, KANSAS
CITY OF SALINA PROJECT NO. 10-2816

DATE: 6/9/11 DRAWN BY: RWE CHECKED BY: KWB REV:

REVISIONS:

NO.	DATE	DESCRIPTION

SHEET TITLE: PLAN & PROFILE

PROJECT PHASE: SAN.SEW. LINE A

SHEET NUMBER: 68A

FINAL