PRELIMINARY ONLY

CAMPBELL & JOHNSON ENGINEERS, P.A.
ENGINEERS • ARCHITECTS • LAND SURVEYORS
785-243-1755 • 113 WEST SEVENTH STREET • CONCORDIA, KANSAS 66901

DRAWN BY: JPJ	CHK'D BY: KPJ&DND	SHEET # 13 OF 60

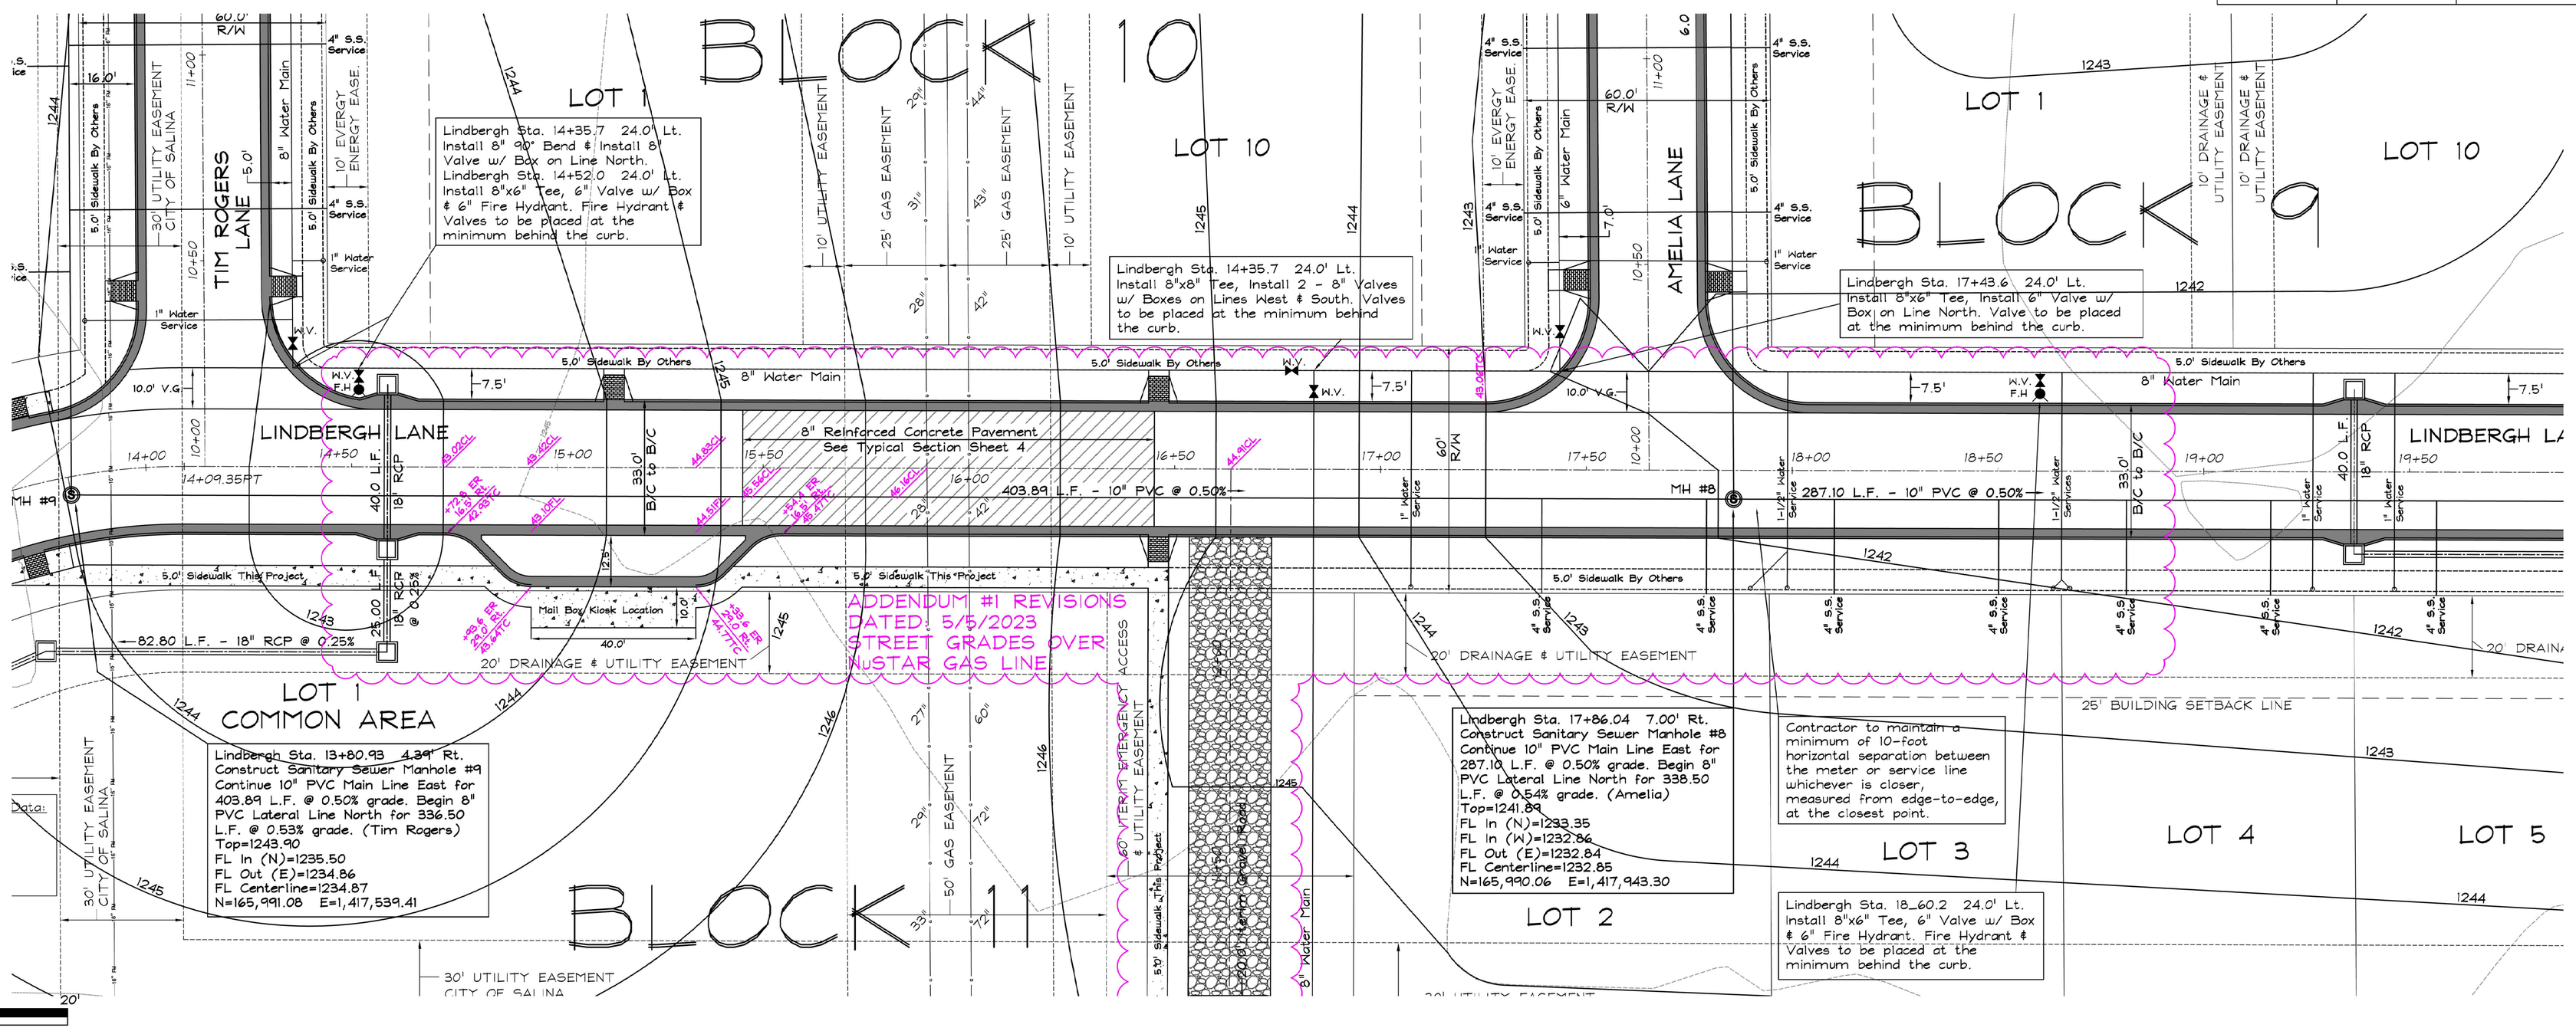

LINDBERGH - WATER & SEWER

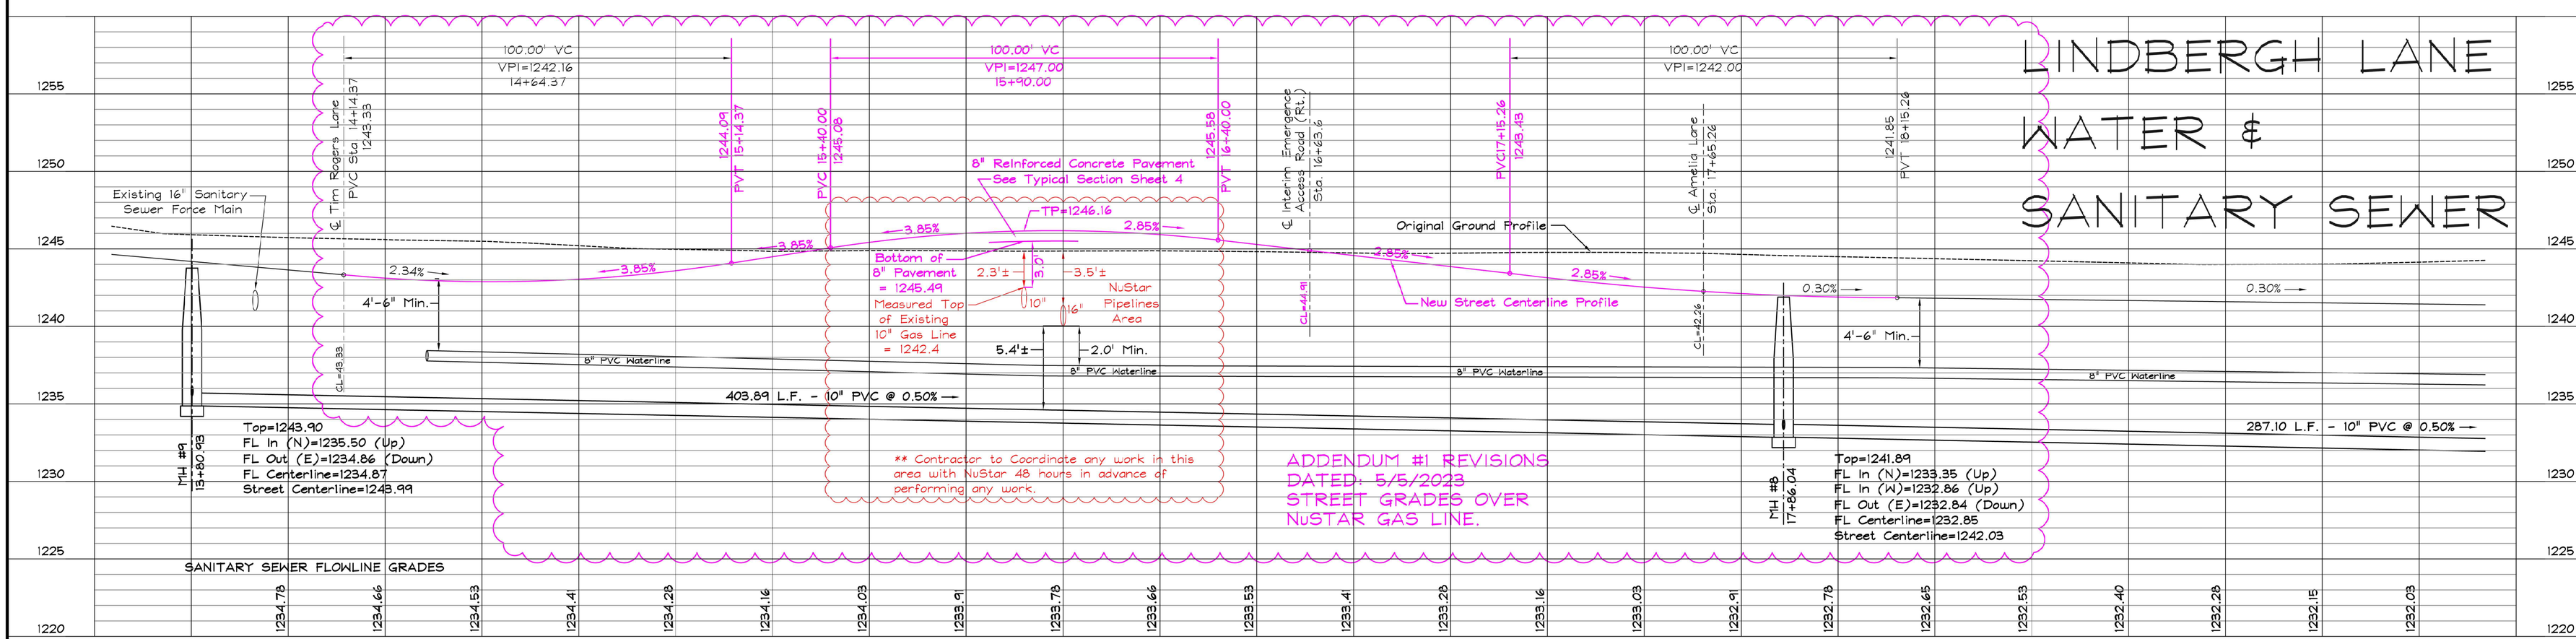

5/9/2023 2:31:14 PM, ADDENDUM #1 - REVISED 5/5/2023