
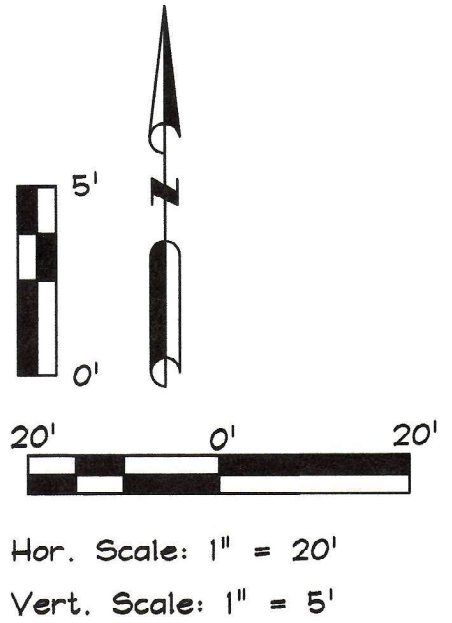


LOT 1
 DRAINAGE & UTILITY EASEMENT

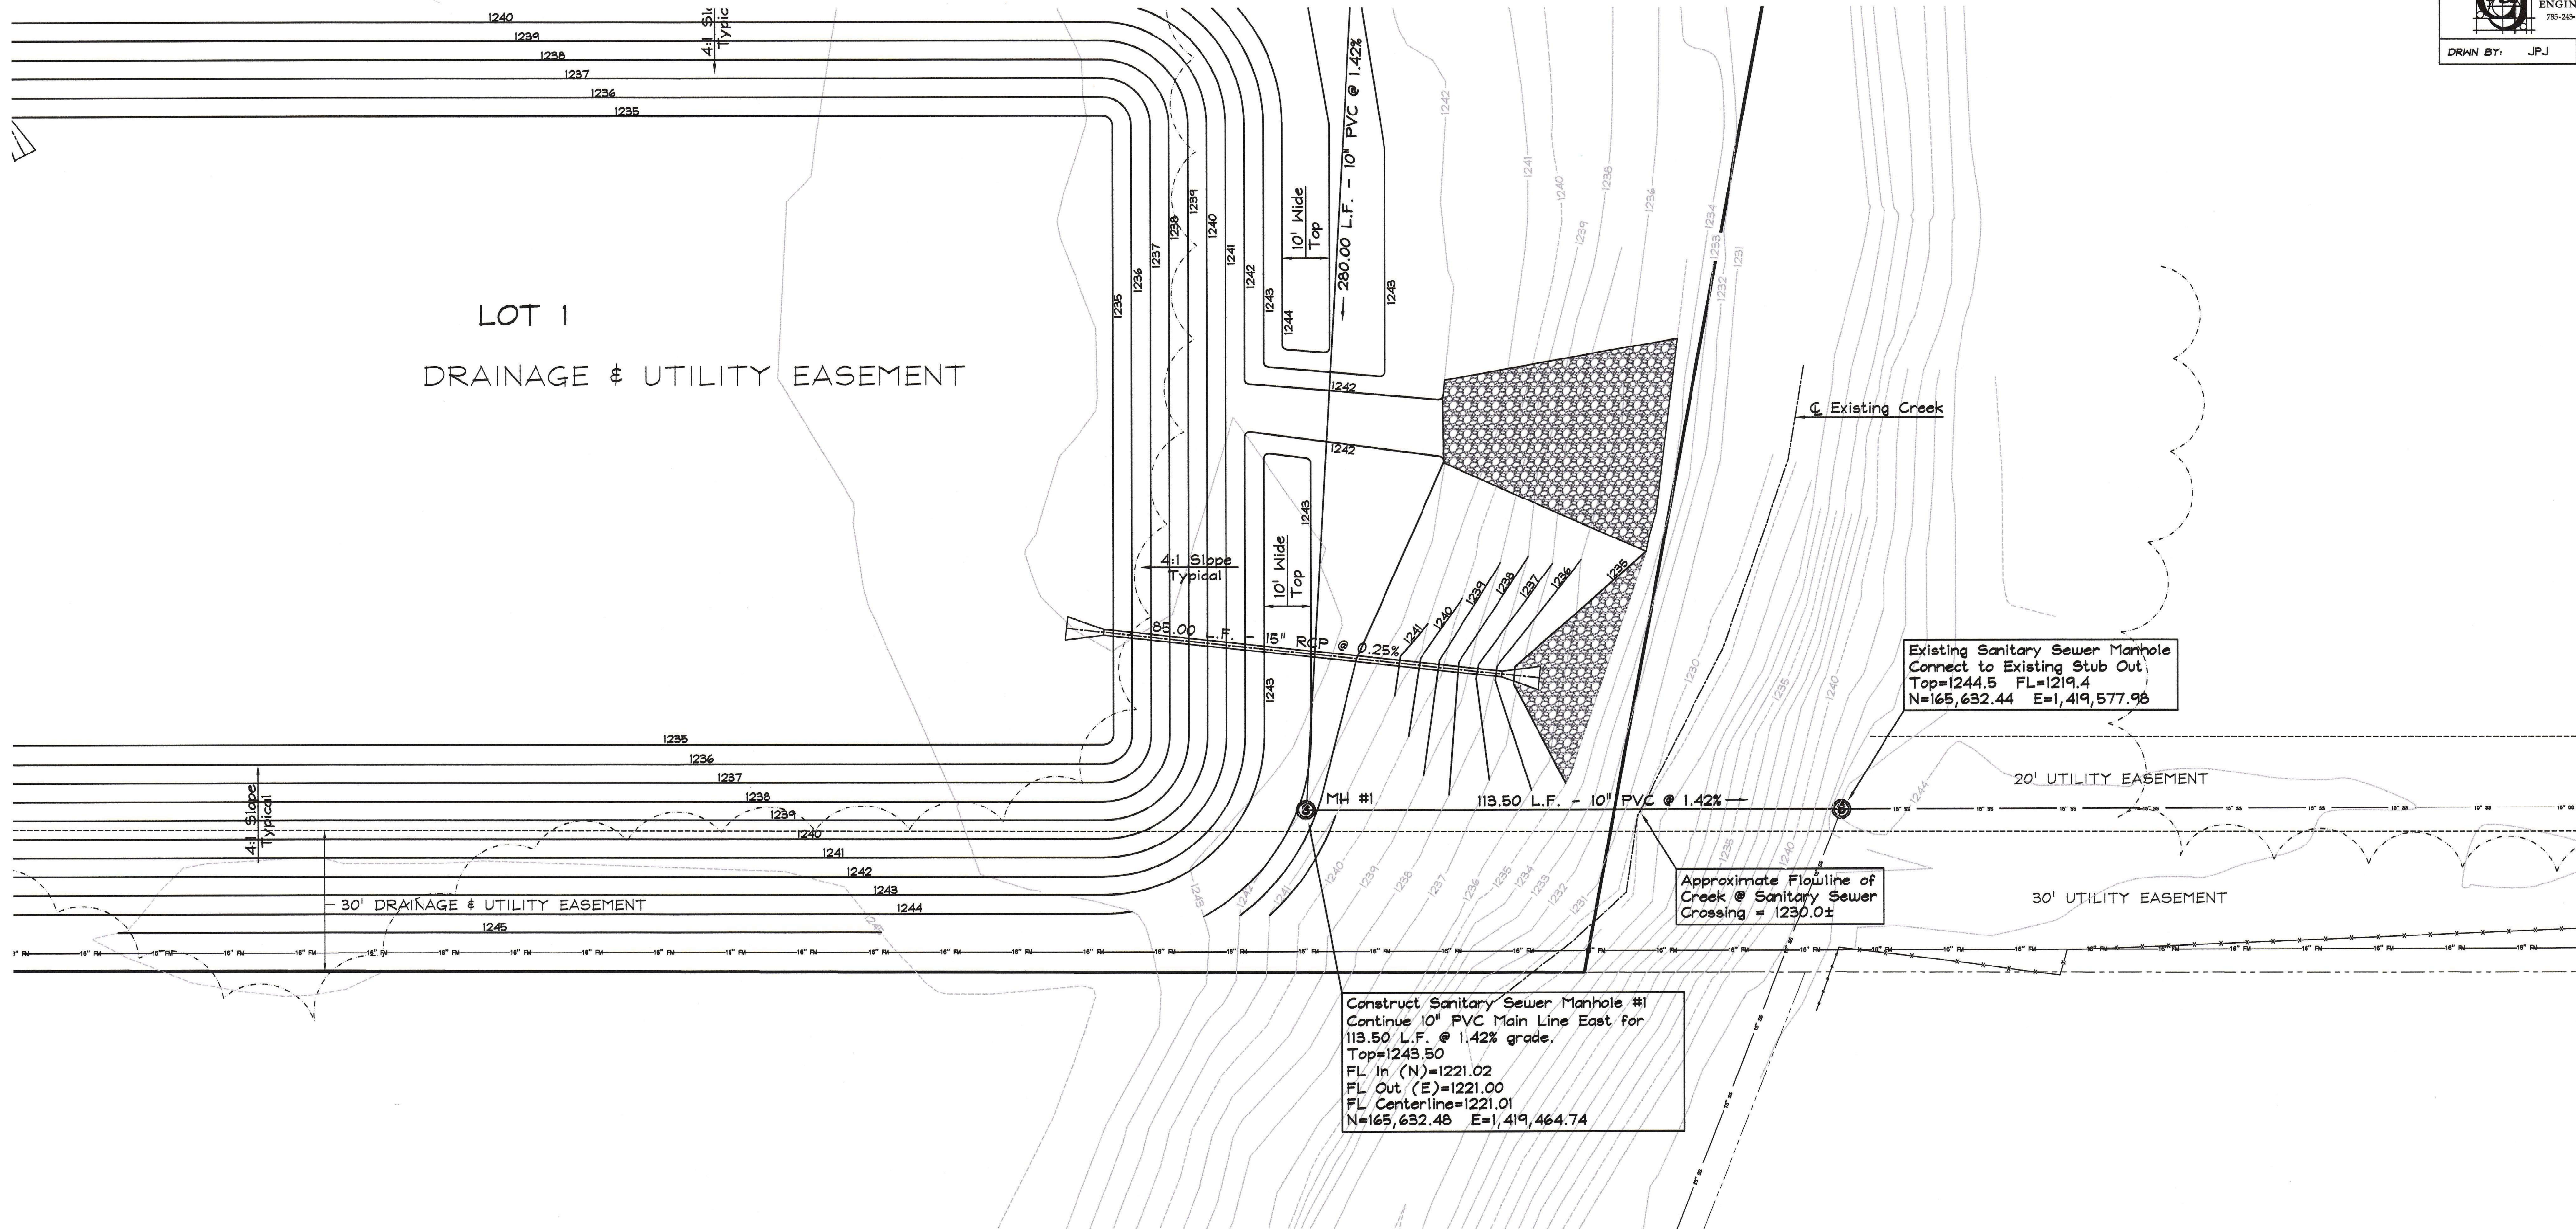


Construct Sanitary Sewer Manhole #1
 Continue 10" PVC Main Line East for
 113.50 L.F. @ 1.42% grade.
 Top=1243.50
 FL In (N)=1221.02
 FL Out (E)=1221.00
 FL Centerline=1221.01
 N=165,632.48 E=1,419,464.74

Existing Sanitary Sewer Manhole
 Connect to Existing Stub Out
 Top=1244.5 FL=1219.4
 N=165,632.44 E=1,419,577.96

Approximate Flowline of
 Creek @ Sanitary Sewer
 Crossing = 1230.0±

DETENTION POND AREA - SANITARY SEWER

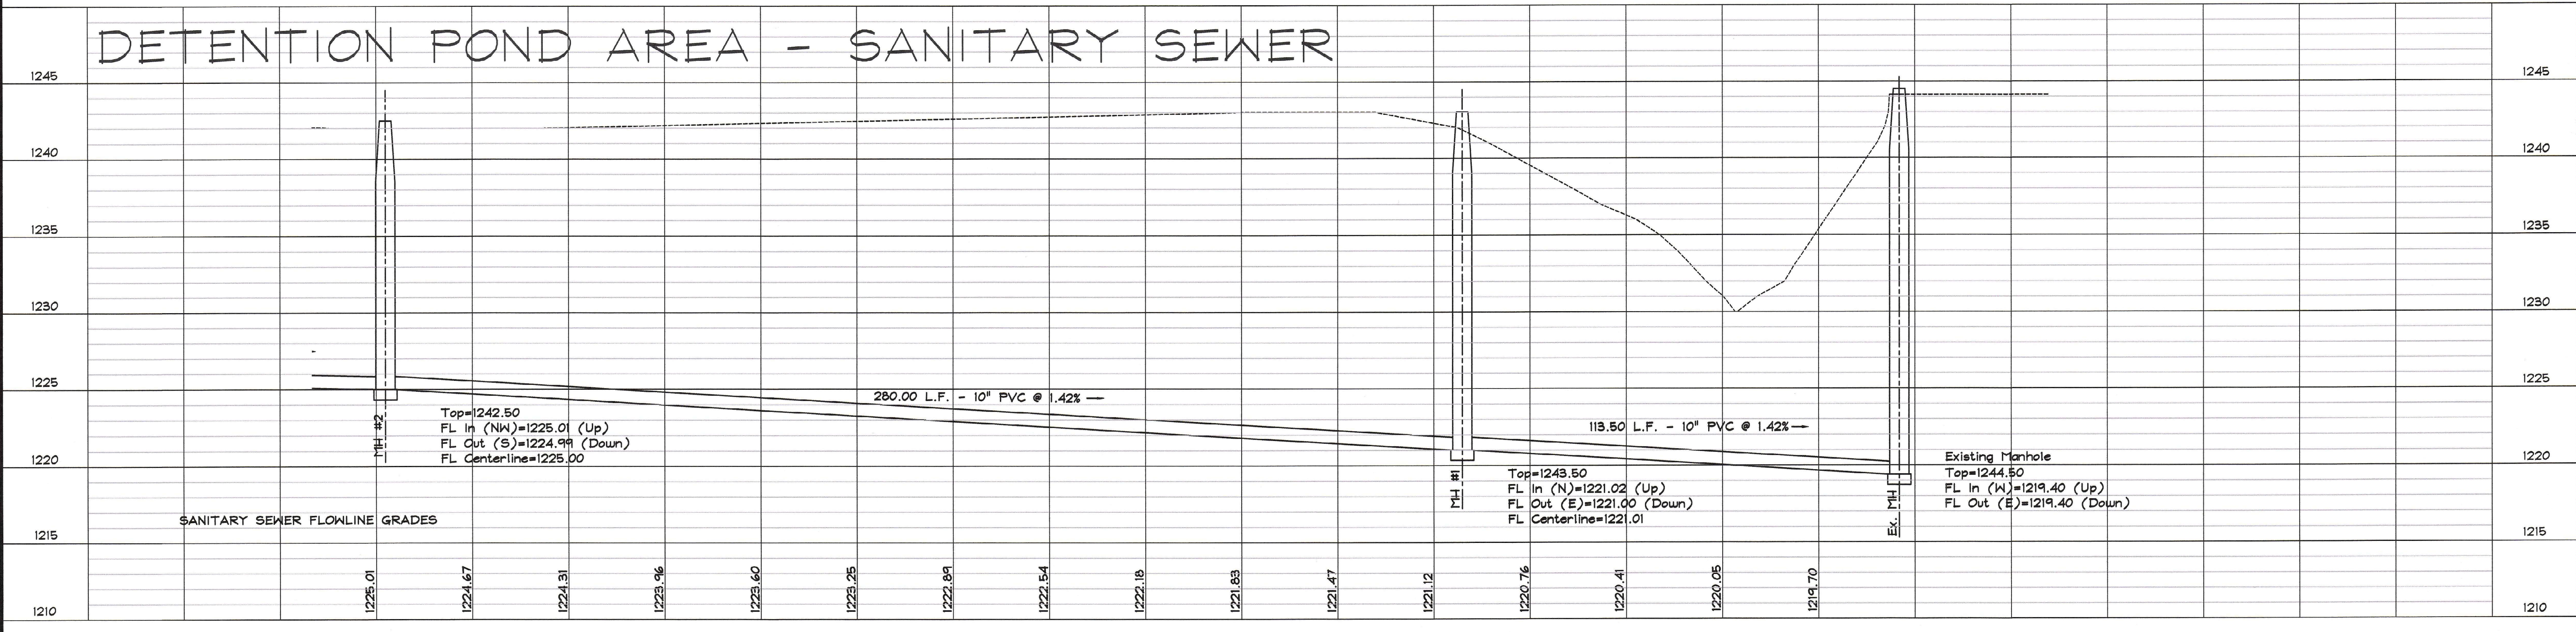

LINDBERGH - WATER & SEWER